


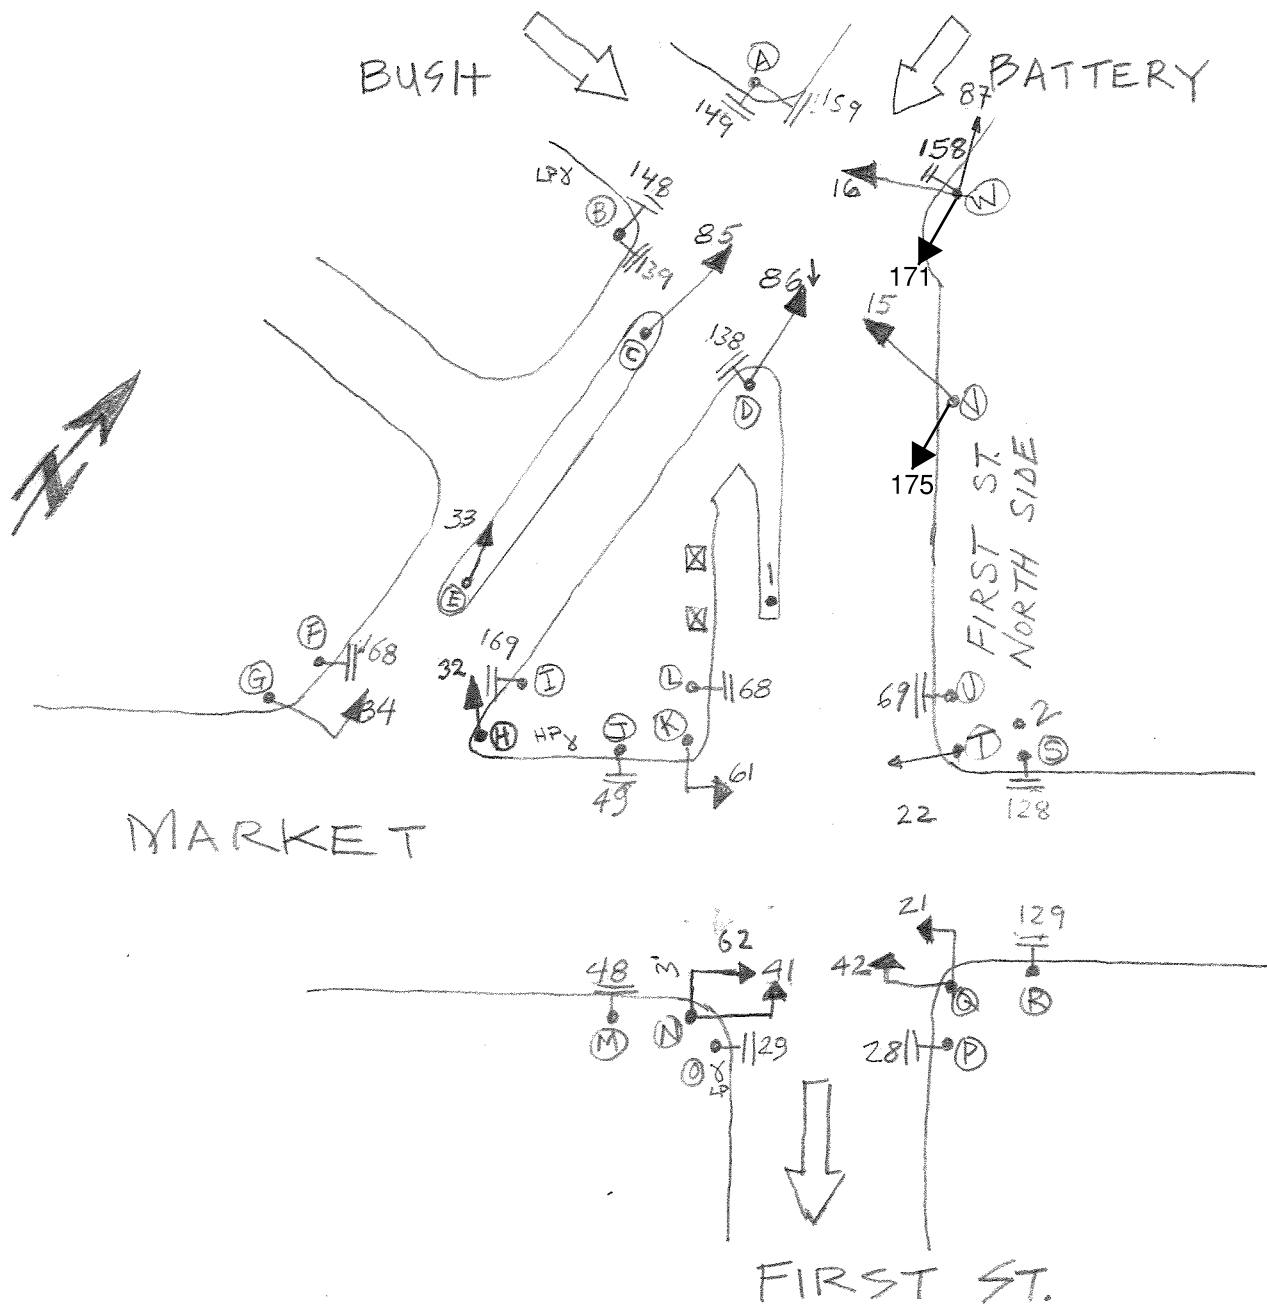

1ST ST. , BATTERY, BUSH, MARKET

HLG = HORIZONTAL LOUVER
ON GREEN BALL ONLY

12/28/2022

POLE	FUNC.	MATL	SIGNAL NO.	MAKE	NO. OF SECT.	SIZE	VISOR	B.P. OR LOUVERS	MOUNT	PED SIGNAL NO.	LEGEND	MESSAGE		MAKE	MOUNT
												ELEMENT	COLOR		
A	S	S	85	EC	3	12"	T 12"	HLG	S	158	I	I-SI	W/OR	ICC	S
B	L	S	86	GA	3	12"RYG(R)	T	NO	S	159	I	I-SI	W/OR	ICC	T
C	L	S	33	GA	3	12"RYG(RA)	T	NO	S	149	I	I-SI	W/OR	ICC	T
D	L	S								148	I	I-SI	W/OR	ICC	S
E	L	S	32	-	3	8"	T	HLG	S	139	I	I-SI	W/OR	ICC	S
F	S	S	34	-	3	8"	FC8"	BP HLG	*	138	I	I-SI	W/OR	ICC	S
G	S	S	61	-	3	8"	FC8"	BP	*	168	I	IS-I	W/OR	ICC	T
H	S	S	62	-	3	12"	T	BP	S	169	I	IS-I	W/OR	ICC	T
I	S	S	41	-	3	8"	FC8"	BP	*	49	I	IS-I	W/OR	ICC	T
J	S	S	42	-	3	8"	FC8"	BP	*	48	I	IS-I	W/OR	ICC	T
K	S	S	21	-	3	8"	FC8"	BP	*	29	I	IS-I	W/OR	ICC	T
L	S	S	22	-	3	12"	T	BP	S	28	I	IS-I	W/OR	ICC	T
M	S	S	15	E	3	12"	T 12"	NO	T	129	I	IS-I	W/OR	ICC	T
N	M	S	16	TCT	3	12"	T 12"	NO	T	128	I	IS-I	W/OR	ICC	T

POLE	FUNC.	MATL	SIGNAL NO.	MAKE	NO. OF SECT.	SIZE	VISOR	B.P. OR LOUVERS	MOUNT	PED SIGNAL NO.	LEGEND	MESSAGE		MAKE	MOUNT
												ELEMENT	COLOR		
D	S	S	87	TCT	3	12"	T 12"	HLG	T	69	I	IS-I	W/OR	ICC	T
P	S	S	171		3	8"BIKE	T 8"	NO	T	68	I	IS-I	W/OR	ICC	T
Q	S	S	175		3	8"BIKE	T 8"	NO	T						
R	S	S													
S	S	S													
T	M	S													
U	S	S													
V	S	S													
W	S	S													
1	L	S													
2	L	S													

CONTROLLER CABINET SIZE : 1 - LARGE 1 - yes
1 - ORDINARY BASE CABINET : 1 - NO

COMMENTS : * MARKET STREET MASTARM SIGNALS

Add 171 & 175 Bike Signals, Upgrade 15,16,85 & 87 to 12-inch - P. Panyam, W.Lee (SRC 2022-205)