


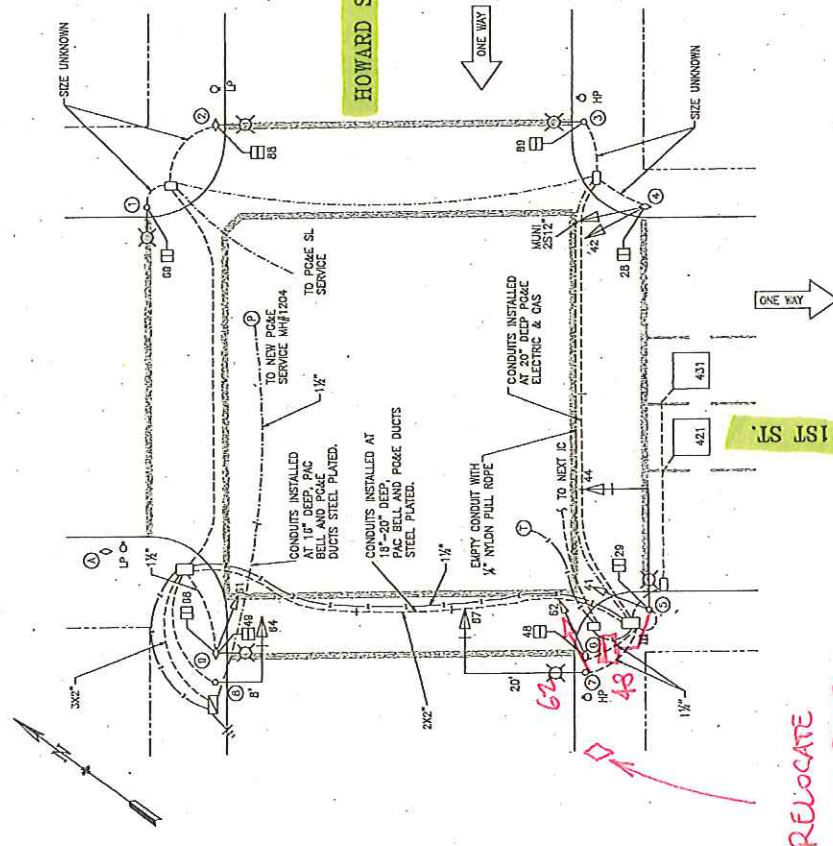

RELOCATE
MUNI POLE
WEST OF
MAST ARM POLE
IF POSSIBLE

POLE No.	TYPE OF POLE	VEHICLE SIGNAL				PEDESTRIAN SIGNAL				REMARKS
		No.	TYPE	MOUNTING	VEHICLE	LOUVER	No.	TYPE	MOUNTING	
1	SL						60	15-IN	SP-1	
2	MUNI & SL SEE SPECIFICATIONS FILE #A-27,082.1 CH 3.						88	15-IN	SP-1	
3	SL						60	15-IN	SP-1	
4	MUNI	42	3512"	SV-1-T	T		28	15-IN	SP-1	
5	178-1-70 W/ 20' MAST ARM AND 6' LUMINAIRE ARM	44 41	3512" 358"	MAS SV-1-T	T		20 48	15-IN 15-C	SP-1 SP-1	BP
6	MUNI	62	358"	SV-1-T	T		48	15-IN	SP-1	EXTERNAL CONDUIT
7	178-1-70 W/ 20' MAST ARM AND 6' LUMINAIRE ARM	67	3512"	MAS	T					BP
8	16-1-70 W/ 8' MAST ARM	84	3512"	MAS	T					BP
9	MUNI	61	358"	SV-1-T	T		49 68	15-IN 15-IN	SP-1 SP-1	
10	MUNI									



NOTE:
ORIGIN FOUNDATION TYPE: STD

		DEPARTMENT OF PARKING AND TRAFFIC DIVISION OF TRAFFIC ENGINEERING CITY AND COUNTY OF SAN FRANCISCO		TRAFFIC SIGNAL INVENTORY DIAGRAM 24532000		DATE: 4/19/2011
DRAWN: J.D./CML CHECKED: R. G.	DATE: 12/20/08 DATE: 4/16/09	SCALE: 1" = 20' SHEET OF SHEETS: 1 OF 1	1ST ST & HOWARD ST			