


POLE AND EQUIPMENT SCHEDULE									
LOCATION	TYPE OF POLE	LUMEC GPLM WATTAGE	VEHICLE SIGNAL			PEDESTRIAN SIGNAL			REMARKS
			NO.	TYPE	MOUNTING	NO.	TYPE	MOUNTING	
1	1-A (10')		61	3S12"	TV-1-T	69	1S-LED	SP-1	WIRE APS UNIT TO PED SIGNAL 69 .
2	1-A (10')		45	3S12"	TV-1-T	48 69	1S-LED	SP-1	WIRE APS UNIT TO PED SIGNAL 48 . 69
3	1-A (10')		46	3S12"	TV-1-T	89	1S-LED	SP-1	WIRE APS UNIT TO PED SIGNAL 89.
4	1-A (10')		22	3S12"RA	TV-1-T	68	1S-LED	SP-1	WIRE APS UNIT TO PED SIGNAL 68.
5	CITY STANDARD STREETLIGHT	164W	21	3S12"RA	SV-1-T				WIRE APS UNIT TO PED SIGNAL 88.
6	17-3-100 WITH 15-FT MAST ARM AND 6-FT LUMINAIRE ARM	164W	42 47	3S12" 3S12"	SV-1-T MAS	88	1S-LED	SP-1	VEHICLE SIGNAL 47 TO BE LOUVERED. VEHICLE SIGNAL 47 TO HAVE BACKPLATE. F/I WIRELESS DETECTION SSP DIGITAL RADIO; ATTACH TO POLE APPROXIMATELY 22' ABOVE GRADE.
7	17-3-100 WITH 25-FT MAST ARM AND 6-FT LUMINAIRE ARM	164W	41 62 44	3S12" 3S12" 3S12"	SV-2-TA MAS	49	1S-LED	SP-1	WIRE APS UNIT TO PED SIGNAL 49. VEHICLE SIGNAL 44 TO BE LOUVERED. VEHICLE SIGNAL 44 TO HAVE BACKPLATE.

- 8 City Standard Streetlight 164W 48 1S-LED SP-1 Wire APS Unit to Ped Signal 48.
- NOTES
- ALL PVC CONDUITS SHALL HAVE A 1#6 (BSCW) GROUND WIRE. F/I GROUND ROD AND GROUNDING LAYOUT AS SHOWN ON SPDPWSF #88,739.
 - SPLICING OF GROUND WIRE SHALL BE PER SPDPWSF #87,204.
 - SERVICE CONNECTIONS SHALL BE MADE PER SPDPWSF #87,203. IF THE PLAN REQUIRES FUSING IN A PULL BOX FOR IC SERVICE, THIS IS THE POINT THE NEUTRAL IS BONDED TO THE GROUND.
 - CONTRACTOR SHALL COORDINATE WITH PG&E VIA TJPA FOR SERVICE CONNECTION WORK PRIOR TO START OF CONSTRUCTION. LOCATION OF PG&E SERVICE POINT IS UNDETERMINED AND SUBJECT TO CHANGE.
 - ALL PULL BOXES SHOWN ARE CCSF/SFMTA TYPE III, UNLESS OTHERWISE INDICATED.

- SHEET NOTES
- CONTRACTOR TO INSTALL TYPE 2070LXN2 CONTROLLER UNIT (PROCURED FROM CITY).
CONTRACTOR TO INSTALL TYPE M-SF TALL CABINET AND ASSEMBLY (PROCURED FROM CITY) AND CONSTRUCT AN M-SF TALL CONTROLLER CABINET FOUNDATION AND ANCHOR BOLTS. DOOR TO OPEN AWAY FROM INTERSECTION.
CONTRACTOR TO INSTALL BATTERY BACK-UP SYSTEM (AS SPECIFIED BY CITY), CAPABLE OF FITTING INSIDE THE CONTROLLER CABINET.
 - CONTRACTOR TO INSTALL WIRELESS VEHICLE DETECTION SYSTEM (PROCURED FROM CITY). A DRAWING SHOWING THE LAYOUT OF THE SENSORS SHALL BE SUBMITTED TO THE TRAFFIC ENGINEER FOR REVIEW AND APPROVAL PRIOR TO INSTALLATION.

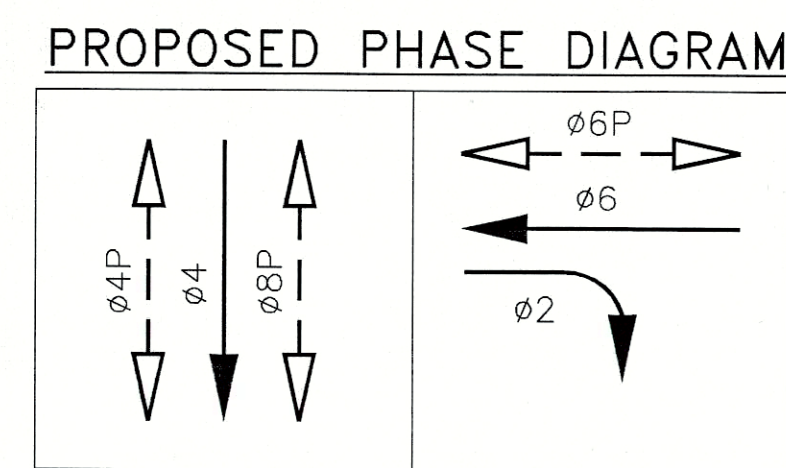

FLASH 6/27/2019 (11:40AM)


SFMTA
Wei Sheng Zhang
Robert Donohoe
Cynthia Hui
Steven Wong
Stephanie Chan

3-COLOR 6/30/2019 (1:15PM)

SFMTA
Wei Sheng Zhang
Alan Coughlan



NO.	DATE	DESCRIPTION	BY	APP
TABLE OF REVISIONS				
CHECK WITH TRACING TO SEE IF YOU HAVE LATEST REVISION				

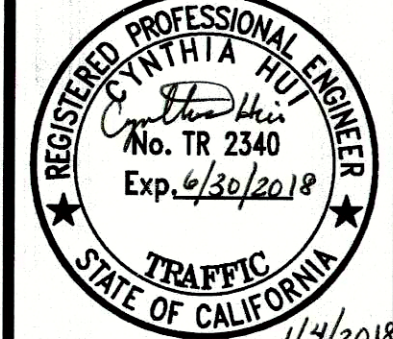

APPROVED		SCALE:
[Signature] January 9 2018		AS SHOWN
DRAWN:	DATE:	
S WONG	1/2018	
CHECKED:	DATE:	
C HUI	1/2018	
CITY TRAFFIC ENGINEER		

SHEET/SHEETS:

TRANSBAY TRANSIT CENTER PROGRAM
FIRST STREET AND NATOMA STREET TRAFFIC SIGNAL WORK



CONTRACT NO.
DRAWING NO. ET-2.0
FILE NO.
REV. NO. 0

FILE NAME: --/--/--
DATE: --/--/--

NO.	DATE	DESCRIPTION	BY	APP
TABLE OF REVISIONS				
CHECK WITH TRACING TO SEE IF YOU HAVE LATEST REVISION				



DRAWN: S WONG	DATE: 1/2018
CHECKED: C HUI	DATE: 1/2018

APPROVED	
 January 9 2018	
SENIOR ENGINEER	DATE:
 1/9/18	
CITY TRAFFIC ENGINEER	DATE:

SCALE:
AS SHOWN

SHEET/SHEETS

TRANSBAY TRANSIT CENTER PROGRAM

FIRST STREET AND NATOMA STREET CONDUIT AND WIRING SCHEDULE

CONTRACT NO.
DRAWING NO. ET-2.1
FILE NO.
REV. NO. 0

FILE NAME: _____
DATE: --/--/---