


POLE AND EQUIPMENT SCHEDULE											
POLE No.	TYPE OF POLE	LUMINAIRE VOLTAGE/ WATTAGE	VEHICLE SIGNAL					PEDESTRIAN SIGNAL			REMARKS
			No.	TYPE	MOUNTING	VISORS	LOUVERS	No.	TYPE	MOUNTING	
①	19-4-100 W/25' MAST ARM & 6' LUMINAIRE ARM		161 124 84 134	3S12"BIKE 3S12"RA 3S12" NRT	SV-1-T MAS MAS MAS	T T T		168	1S-COUNT	SP-1	BACKPLATE BACKPLATE APS-2W
②	17B-1-70 W/8' MAST ARM & 6' LUMINAIRE FIXTURE		22 24	3S12" 3S12"	SV-1-T MAS	T T		69	1S-COUNT	SP-1	APS-2W BACKPLATE
③	16-1-70 W/8' MAST ARM		21 27	3S12" 3S12"	SV-1-T MAS	T T		28	1S-COUNT	SP-1	APS-2W BACKPLATE
④	STEEL STREET LIGHT 28.5' W/6' LUMINAIRE ARM		165 125 42	3S8"BIKE 3S12"RA 3S12"	SV-1 TV-2-T	T T T		169	1S-COUNT	SP-1	MOUNT 165 AT 8'
⑤	17-2-100 W/20' MAST ARM & 6' LUMINAIRE ARM		141 44	3S12" BIKE 3S12"	SV-1-T MAS	T T		48	1S-COUNT	SP-1	APS-2W BACKPLATE CCTV CAMERA
⑥	1-A (7')							29	1S-COUNT	TP-1	APS-2W
⑦	CITY STANDARD STREET LIGHT W/ LUMINAIRE FIXTURE							68	1S-COUNT	SP-1	APS-2W
⑧	1-A (13')		82 145	3S12" 3S8" BIKE	TV-1-T SV-1	T T		49	1S-COUNT	SP-1	APS-2W MOUNT 145 AT 8'
⑨	PPB POLE										APS-2W



1	09/03/22	ADDED CCTV CAMERA (SRC 2022-154)	S.ALEXANDER	M.VELASCO
0	02/04/21	CONVERTED FROM CONTRACT 1064J	S.SHARIATI	M.GROWNEY
NO.	DATE	DESCRIPTION	BY	APPROVED
TABLE OF REVISIONS CHECKOUT DRAWING THROUGH THE SID CUSTODIAN FOR THE LATEST REVISION				

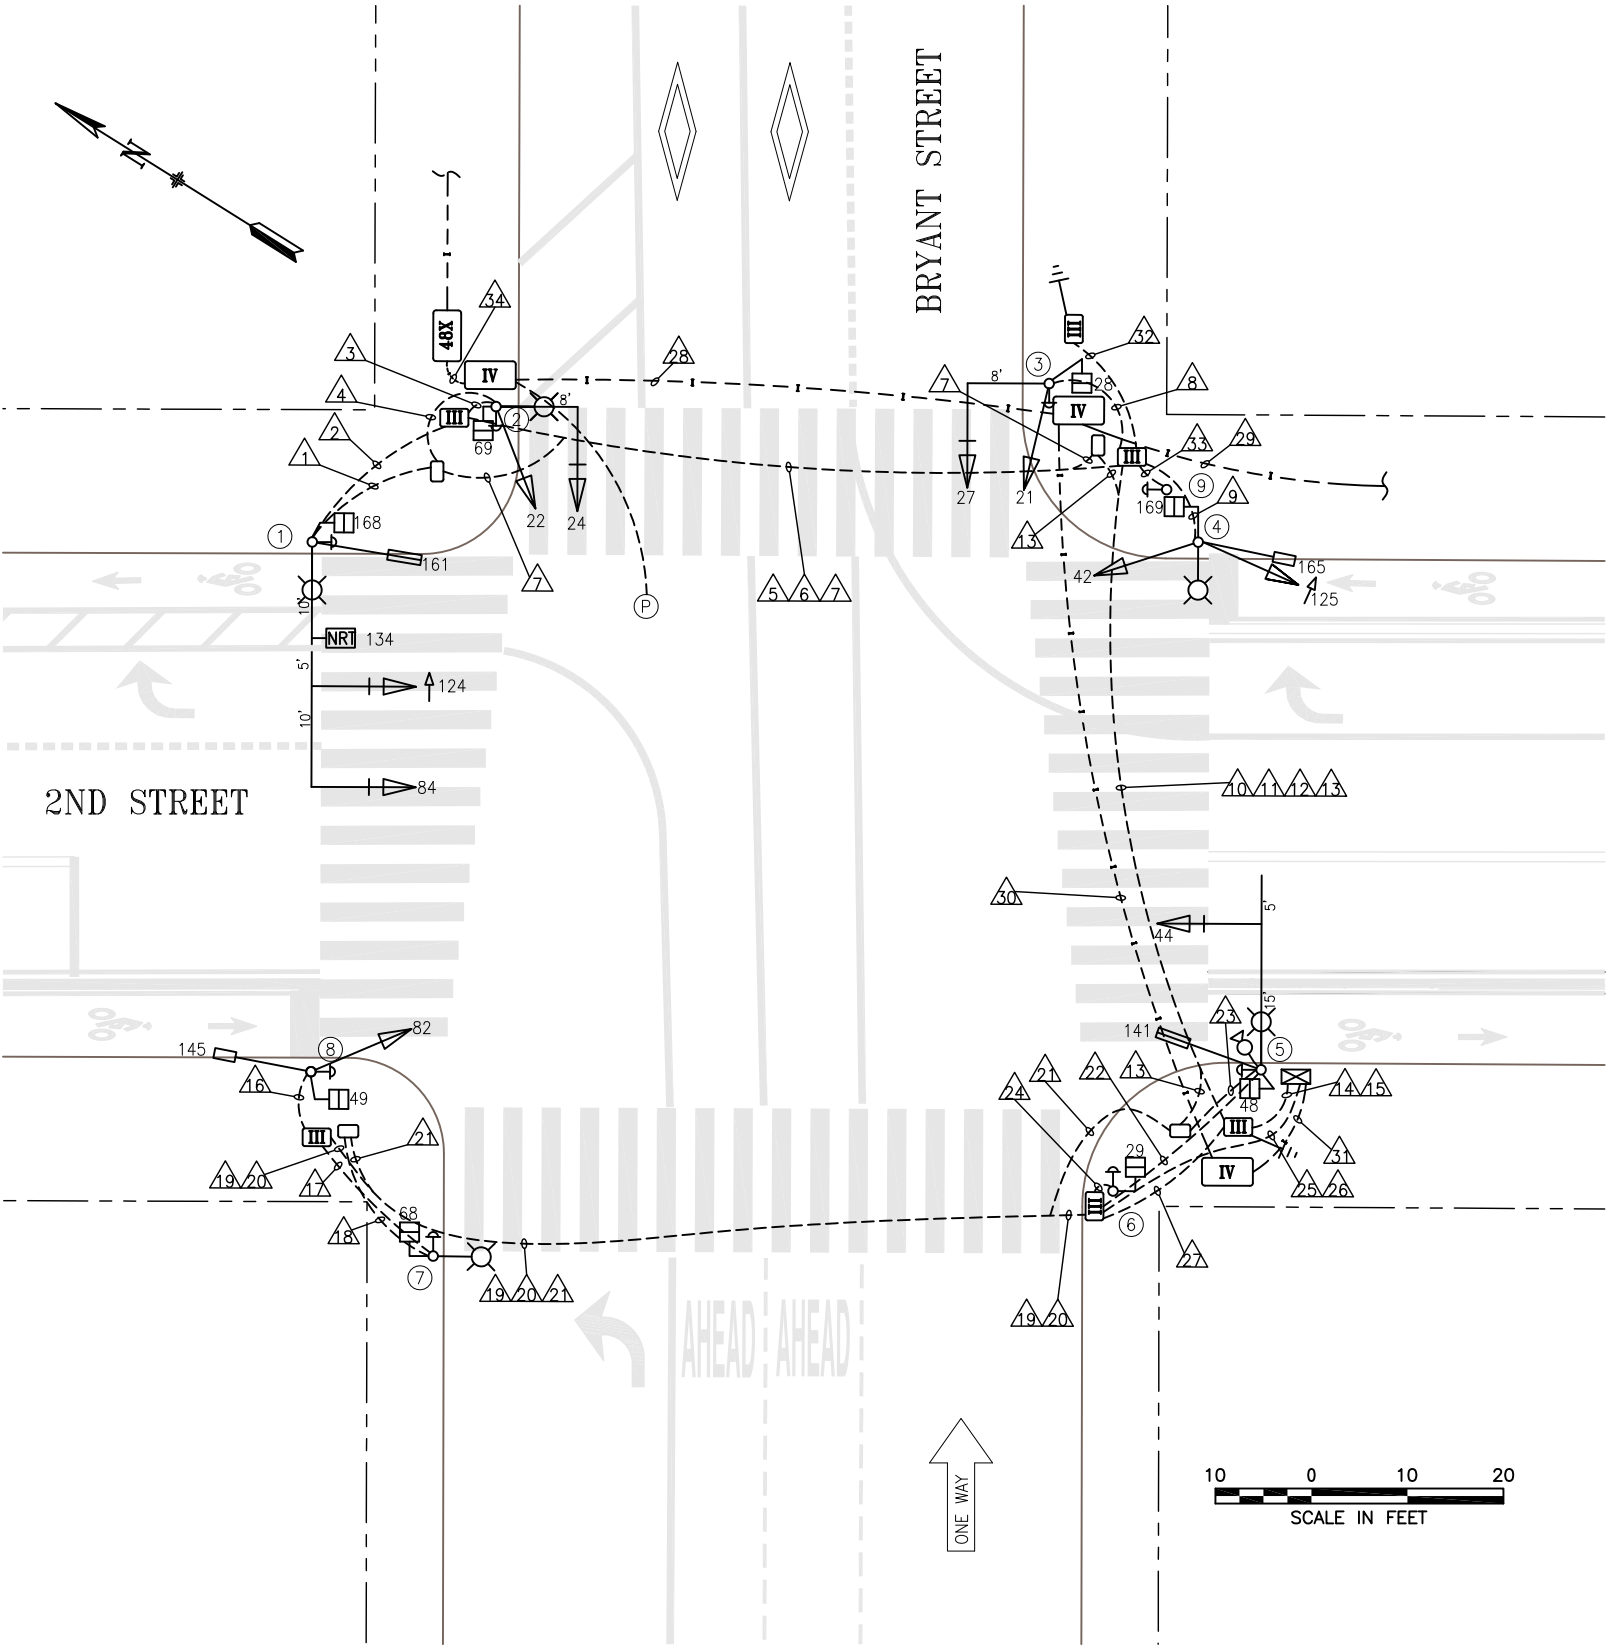

SFMTA

DRAWN BY:	DATE:
SHAHRAM SHARIATI	02/07/22
CHECKED BY:	DATE:
MAURICE GROWNEY	03/21/22

SCALE
AS SHOWN
SHEET OF SHEETS
1 OF 2

TRAFFIC SIGNAL INVENTORY DIAGRAM
2ND STREET & BRYANT STREET

CNN NO:
24490000
REV NO:
1