


[illegible]

		SCALE	TRAFFIC SIGNAL INVENTORY DIAGRAM	CNN NO:
		AS SHOWN		24519000
DRAWN BY:	DATE:	SHEET OF SHEETS	2ND STREET & FOLSOM STREET	REV NO:
SHAHAM SHARAITI	02/07/22			
CHECKED BY:	DATE:	01 OF 02		0
MAURICE GROWNEY	03/21/22			

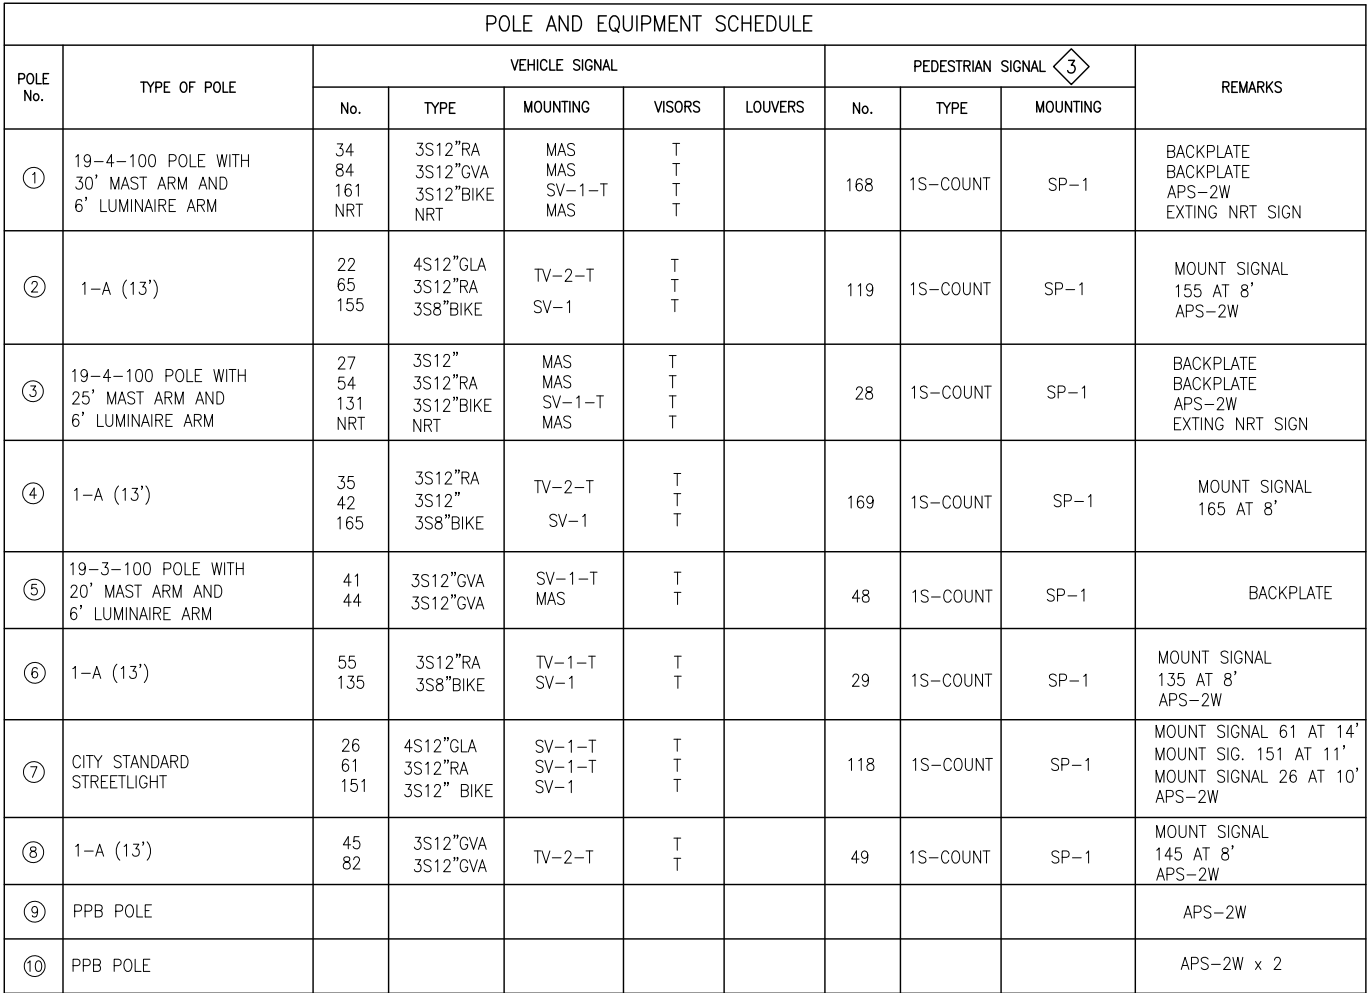