


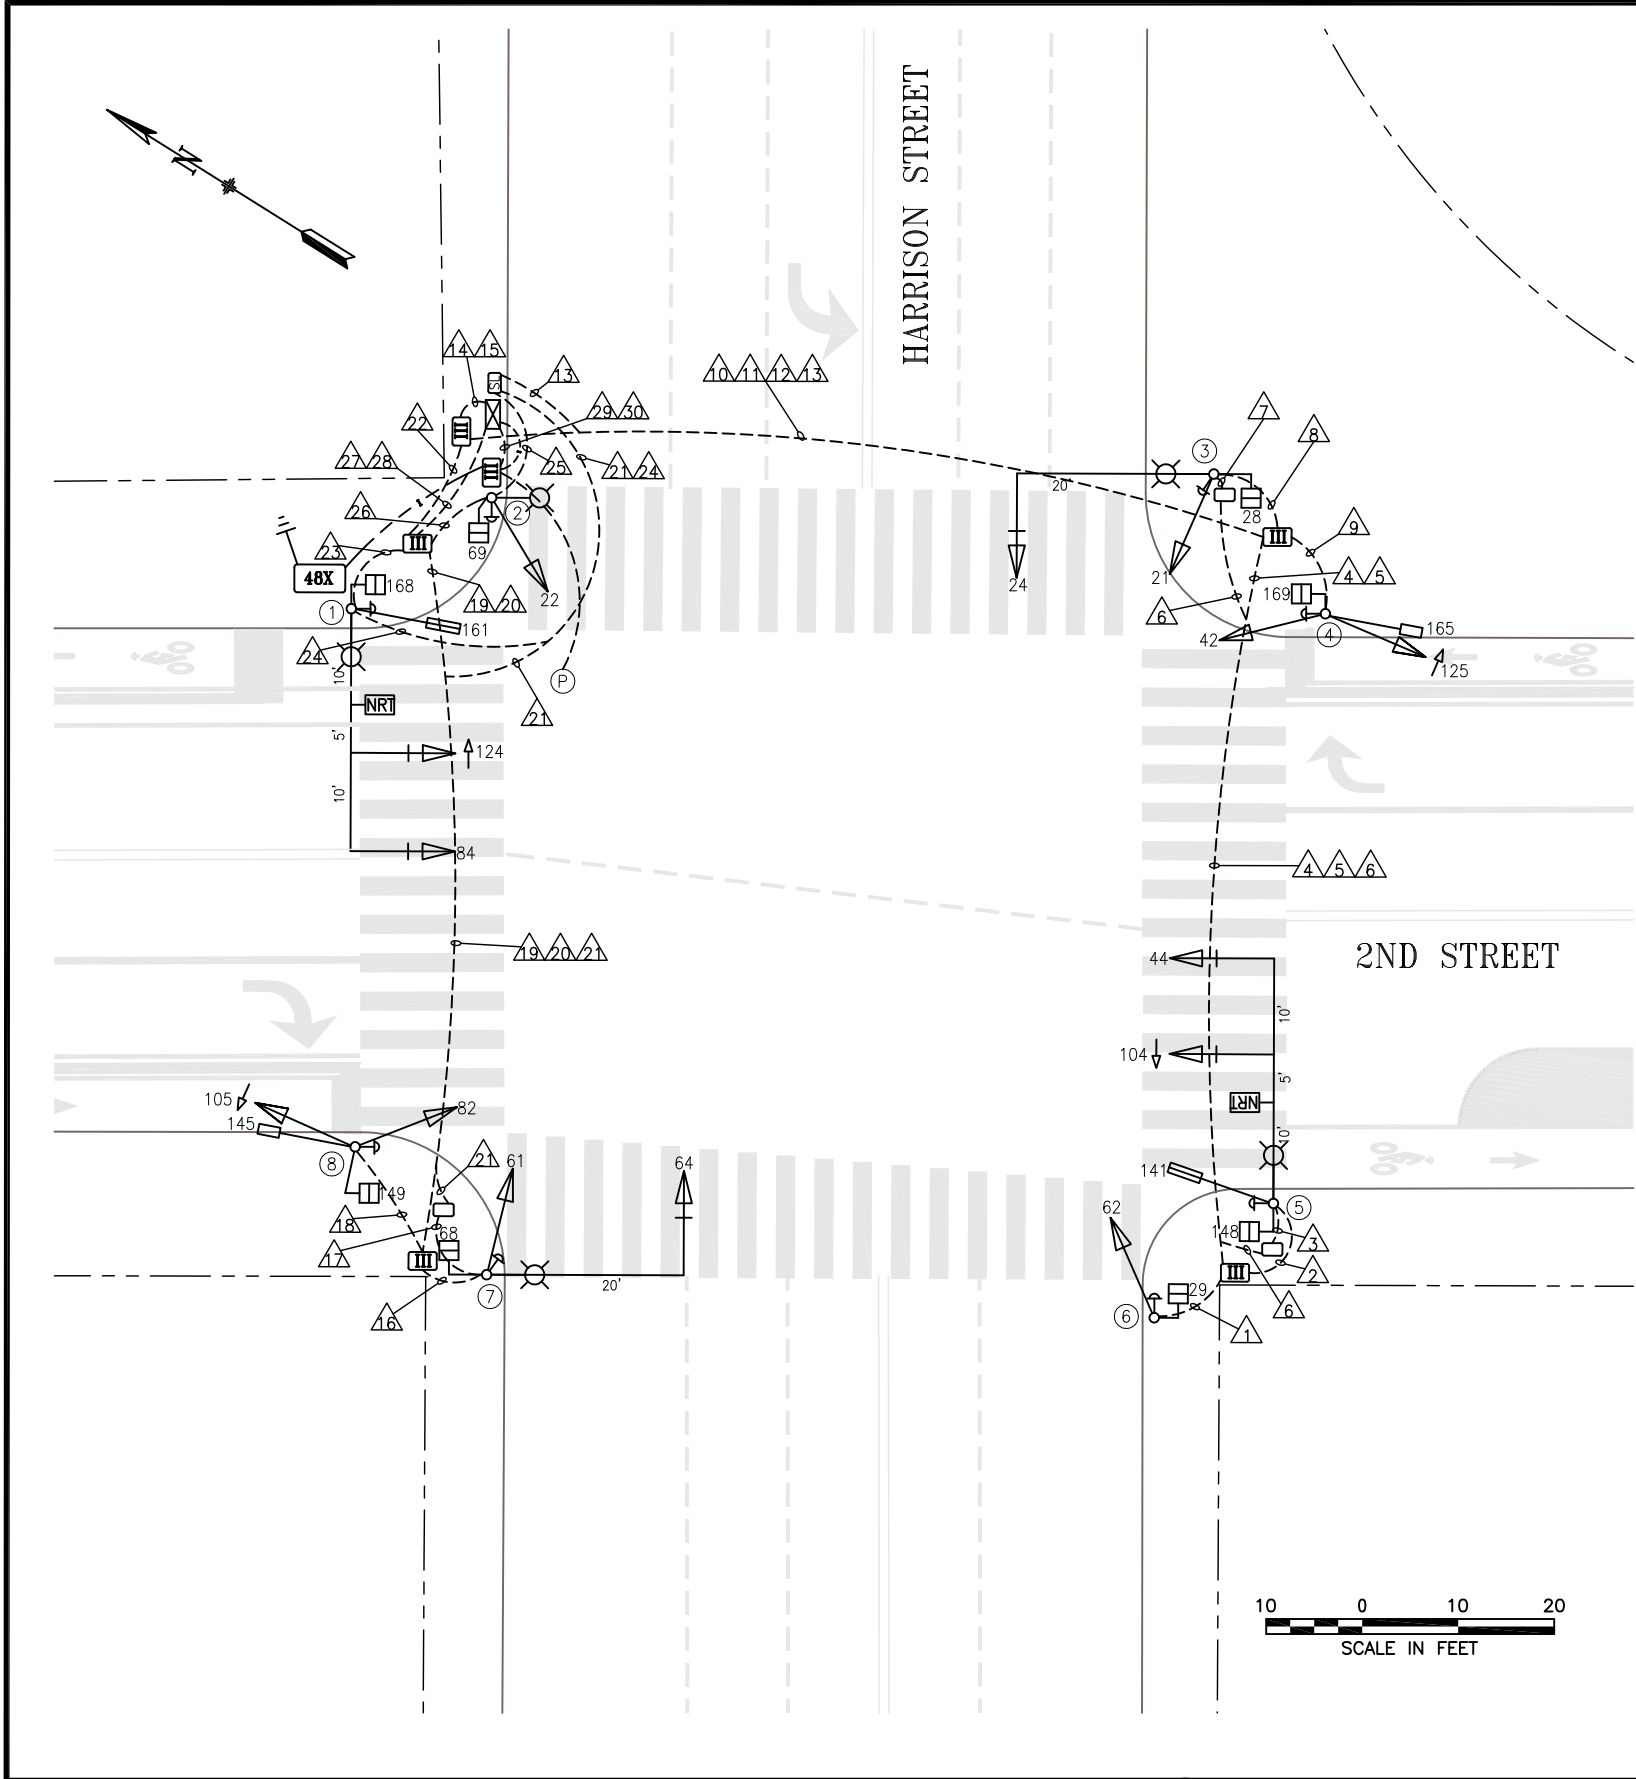

POLE AND EQUIPMENT SCHEDULE											
POLE No.	TYPE OF POLE	LUMINAIRE VOLTAGE/WATTAGE	VEHICLE SIGNAL					PEDESTRIAN SIGNAL			REMARKS
			No.	TYPE	MOUNTING	VISORS	LOUVERS	No.	TYPE	MOUNTING	
①	19-4-100 W/25' MAST ARM & 6' LUMINAIRE ARM		161 124 84	3S12" BIKE 3S12" RA 3S12" NRT	SV-1-T MAS MAS MAS	T T T		168	1S-COUNT	SP-1	BACKPLATE BACKPLATE APS-2W
②	CITY STANDARD STREET LIGHT W/ LUMINAIRE FIXTURE		22	3S12"	SV-1-T	T		69	1S-COUNT	SP-1	APS-2W
③	17B-1-70 W/20' MAST ARM & 6' LUMINAIRE ARM		24 21	3S12" 3S12"	MAS SV-1-T	T T		28	1S-COUNT	SP-1	BACKPLATE APS-2W
④	1-A (13')		165 42 125	3S8" BIKE 3S12" 3S12" RA	SV-1 TV-2-T	T T T		169	1S-COUNT	SP-1	APS-2W MOUNT 165 AT 8'
⑤	19-4-100 W/25' MAST ARM & 6' LUMINAIRE ARM		104 44 141	3S12" RA 3S12" NRT 3S12" BIKE	MAS MAS MAS SV-1-T	T T T		148	1S-COUNT	SP-1	BACKPLATE BACKPLATE APS-2W
⑥	1-A (10')		62	3S12"	TV-1-T	T		29	1S-COUNT	SP-1	APS-2W
⑦	17B-1-70 W/20' MAST ARM & 6' LUMINAIRE ARM		61 64	3S12" 3S12"	SV-1-T MAS	T T		68	1S-COUNT	SP-1	APS-2W BACKPLATE
⑧	1-A (13')		145 82 105	3S8" BIKE 3S12" 3S12" RA	SV-1 TV-2-T	T T T		149	1S-COUNT	SP-1	APS-2W MOUNT 145 AT 8'

02/03/21	CONVERTED FROM CONTRACT 1064J	S.SHARIATI	M.GROWNEY		
NO.	DATE	DESCRIPTION	BY	APPROVED	
TABLE OF REVISIONS					
CHECKOUT DRAWING THROUGH THE SID CUSTODIAN FOR THE LATEST REVISION					



SFMTA

DRAWN BY: SHAHRAM SHARIATI	DATE: 02/07/22	SCALE AS SHOWN	TRAFFIC SIGNAL INVENTORY DIAGRAM	CNN NO: 24510000
CHECKED BY: MAURICE GROWNEY	DATE: 03/21/22	SHEET OF SHEETS 01 OF 02	2ND STREET & HARRISON STREET	REV NO:

0

