


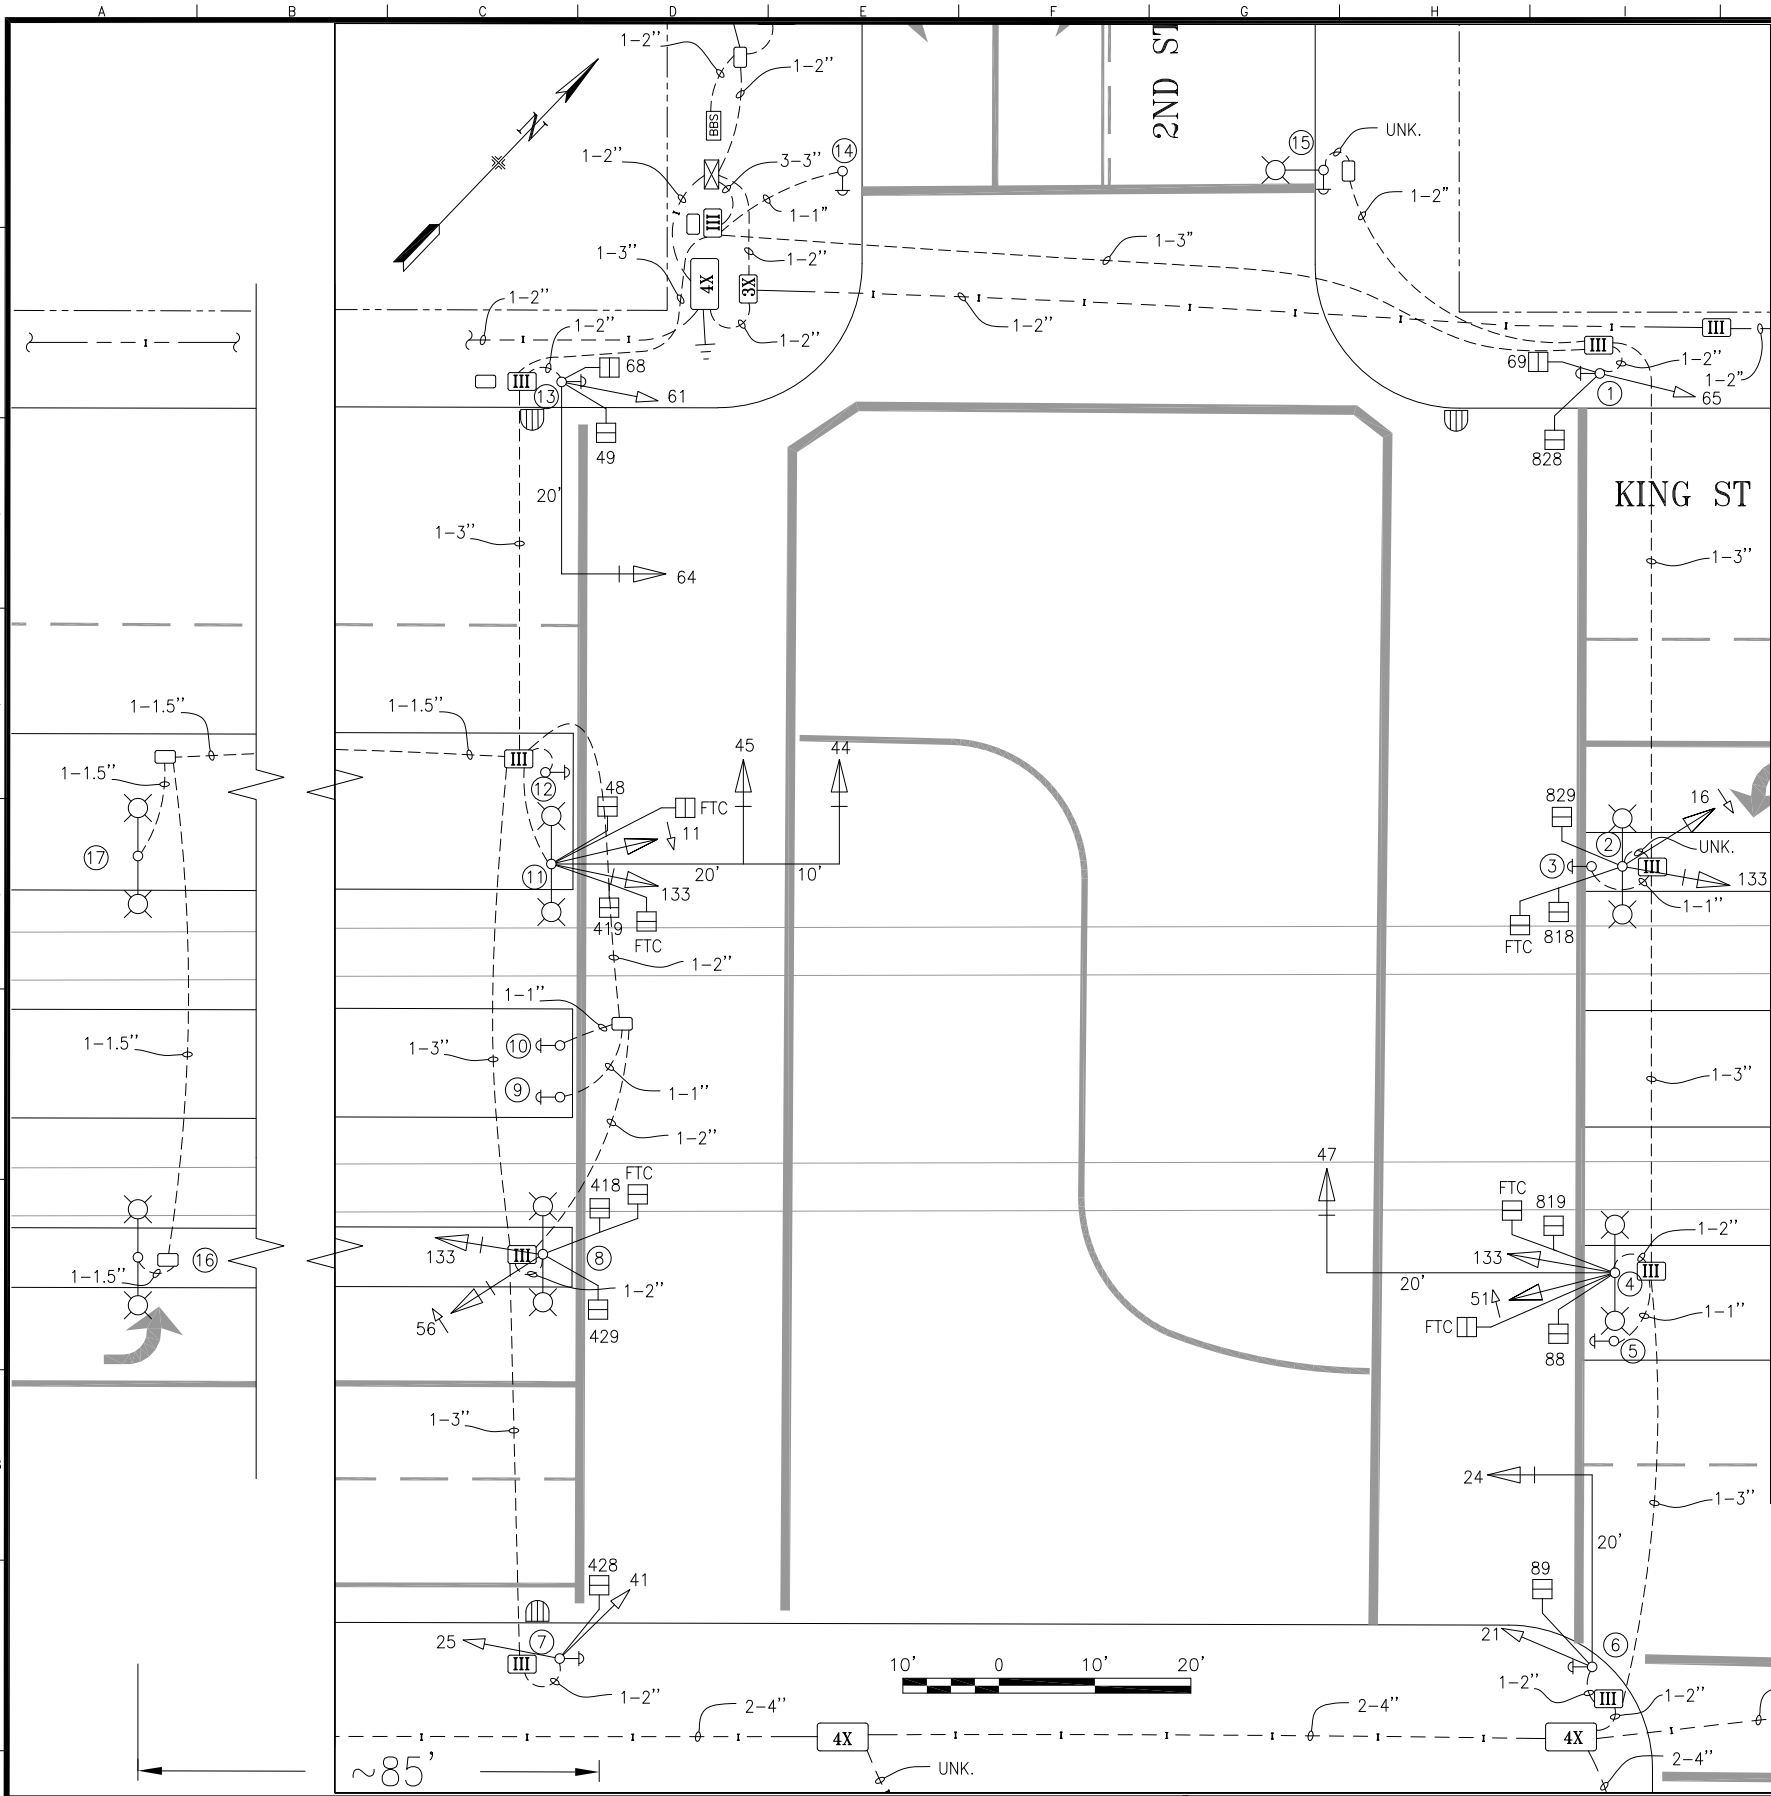

POLE No.	TYPE OF POLE	LUMINAIRE VOLTAGE/ WATTAGE	VEHICLE SIGNAL					PEDESTRIAN SIGNAL			REMARKS
			No.	TYPE	MOUNTING	VISORS	LOUVERS	No.	TYPE	MOUNTING	
①	1 - A (12')		65	3S8"	TV-1	T		69 828	1S-COUNT 1S-COUNT	CUSTOM	APS PPB
②	COMBINATION POLE		16 133	3S12"LA 2S12"LB	SV-1 SV-1	T T		818 829 FTC	1S-COUNT 1S-COUNT 1S16"x16"	CUSTOM	MOUNT 16 @ 4'6" BACKPLATE
③	PPB POLE										APS PPB
④	COMBINATION POLE W/ 30' MAS ARM		47 51 133 FTC	3S12" 3S12"LA 2S12"LB 1S 24"x24"	MAS SV-1 SV-1 SP-1	T T T		88 819 FTC	1S-COUNT 1S-COUNT 1S16"x16"	CUSTOM	BACKPLATE
⑤	PPB POLE										APS PPB
⑥	16-1-70 W/ W/ 20' MAS ARM		24 21	3S12" 3S8"	MAS SV-1	T T		89	1S-COUNT	SP-1	BACKPLATE APS PPB
⑦	1 - A (12')		25 41	3S8" 3S8"	TV-2-T	T T	VERT LOUVERS SIGNAL 41	428	1S-COUNT	SP-1	APS PPB
⑧	COMBINATION POLE		56 133	3S12LA" 2S12"LB	SV-1 SV-1	T T		418 429 FTC	1S-COUNT 1S-COUNT 1S16"x16"	CUSTOM	MOUNT 56 @ 4'6"
⑨	PPB POLE										APS PPB
⑩	PPB POLE										APS PPB
⑪	COMBINATION POLE W/ 30' MAS ARM		44 45 11 FTC 133	3S12" 3S12" 3S12"LA 1S 24"x24" 2S12"LB	MAS MAS SV-1 SP-1 SV-1	T T T T		48 419 FTC	1S-COUNT 1S-COUNT 1S16"x16"	CUSTOM	BACKPLATE BACKPLATE
⑫	PPB POLE										APS PPB
⑬	16-1-70 W/ W/ 20' MAS ARM		64 61	3S12" 3S8"	MAS SV-1	T T		49 68	1S-COUNT 1S-COUNT	CUSTOM	BACKPLATE APS PPB
⑭	PPB POLE										APS PPB
⑮	SL										APS PPB
⑯	COMBINATION POLE										BACKPLATE
⑰	COMBINATION POLE										BACKPLATE

2	11/20/21	SRC 2021-038: UPGRADED 24"x24" FTCs ON POLES 4 & 11	T. YOUNG	M. VELASCO
1	12/11/16	RELOCATED AND RELABELLED LRV SIGNALS PER SRC 2016-318	A. LAM	M. VELASCO
0	3/26/15	MOD ACTIVATED THRU 2108J; CONVERTED FROM 2108J CONTRACT PLANS, 7152E AS-BUILTS 6658E AS-BUILTS, & 0708J AS-BUILTS.	J. HORNBOSTEL	M. VELASCO
NO.	DATE	DESCRIPTION	BY	APPROVED
TABLE OF REVISIONS CHECKOUT DRAWING THROUGH THE SID CUSTODIAN FOR THE LATEST REVISION				



SFMTA

DRAWN BY:
J. HORNBOSTEL
CHECKED BY:
M. VELASCO
DATE:
09/15
DATE:
09/15

SCALE
AS SHOWN
SHEET OF SHEETS
1 OF 1

TRAFFIC SIGNAL INVENTORY DIAGRAM

2ND ST AND KING ST

CNN NO:
23589000
REV NO:
2