


2ND ST & MARKET

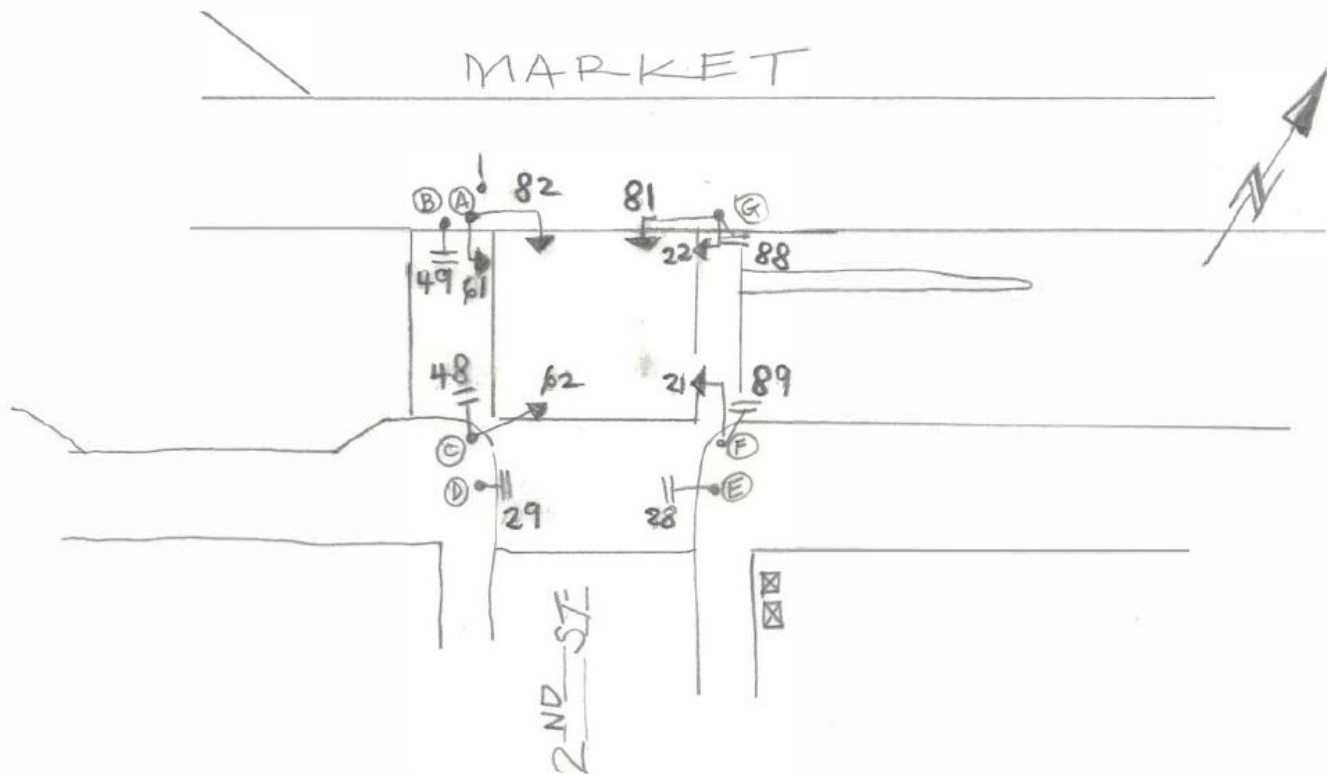

DATE: 01-09-19

POLE	FUNC.	MAT'L	SIGNAL NO.	MAKE	NO. OF SECT.	SIZE	VISOR	B.P. OR LOUVERS	MOUNT	PED SIGNAL NO.	LEGEND	MESSAGE ELEMENT	COLOR	MAKE	MOU
A	S	S	82	—	3	8" FY	FC 8"	BP	*	49	I	IS-I	W/OR	ICC	T
B	S	S	61	—	3	8"	FC 8"	BP	*	48	I	IS-I	W/OR	ICC	T
C	S	S	62	—	3	8"	FC 8"	BP	*	29	I	IS-I	W/OR	ICC	T
D	S	S	21	—	3	8"	FC 8"	BP	*	28	I	IS-I	W/OR	ICC	T
E	S	S	22	—	3	8"	FC 8"	BP	*	89	I	IS-I	W/OR	ICC	S
F	S	S	81	—	3	8" FY	FC 8"	BP	*	88	I	IS-I	W/OR	ICC	S
G	S	S													
H															
I	L	O													

CONTROLLER CABINET SIZE : ORDINARY BASE CABINET: 1-yes
1-NO

COMMENTS : * MARKET STREET MASTARM SIGNALS

• Changed 81 & 82 to be 8" FY signal heads & updated numbering to match timing card. Ian Tront SRC 2018-473