


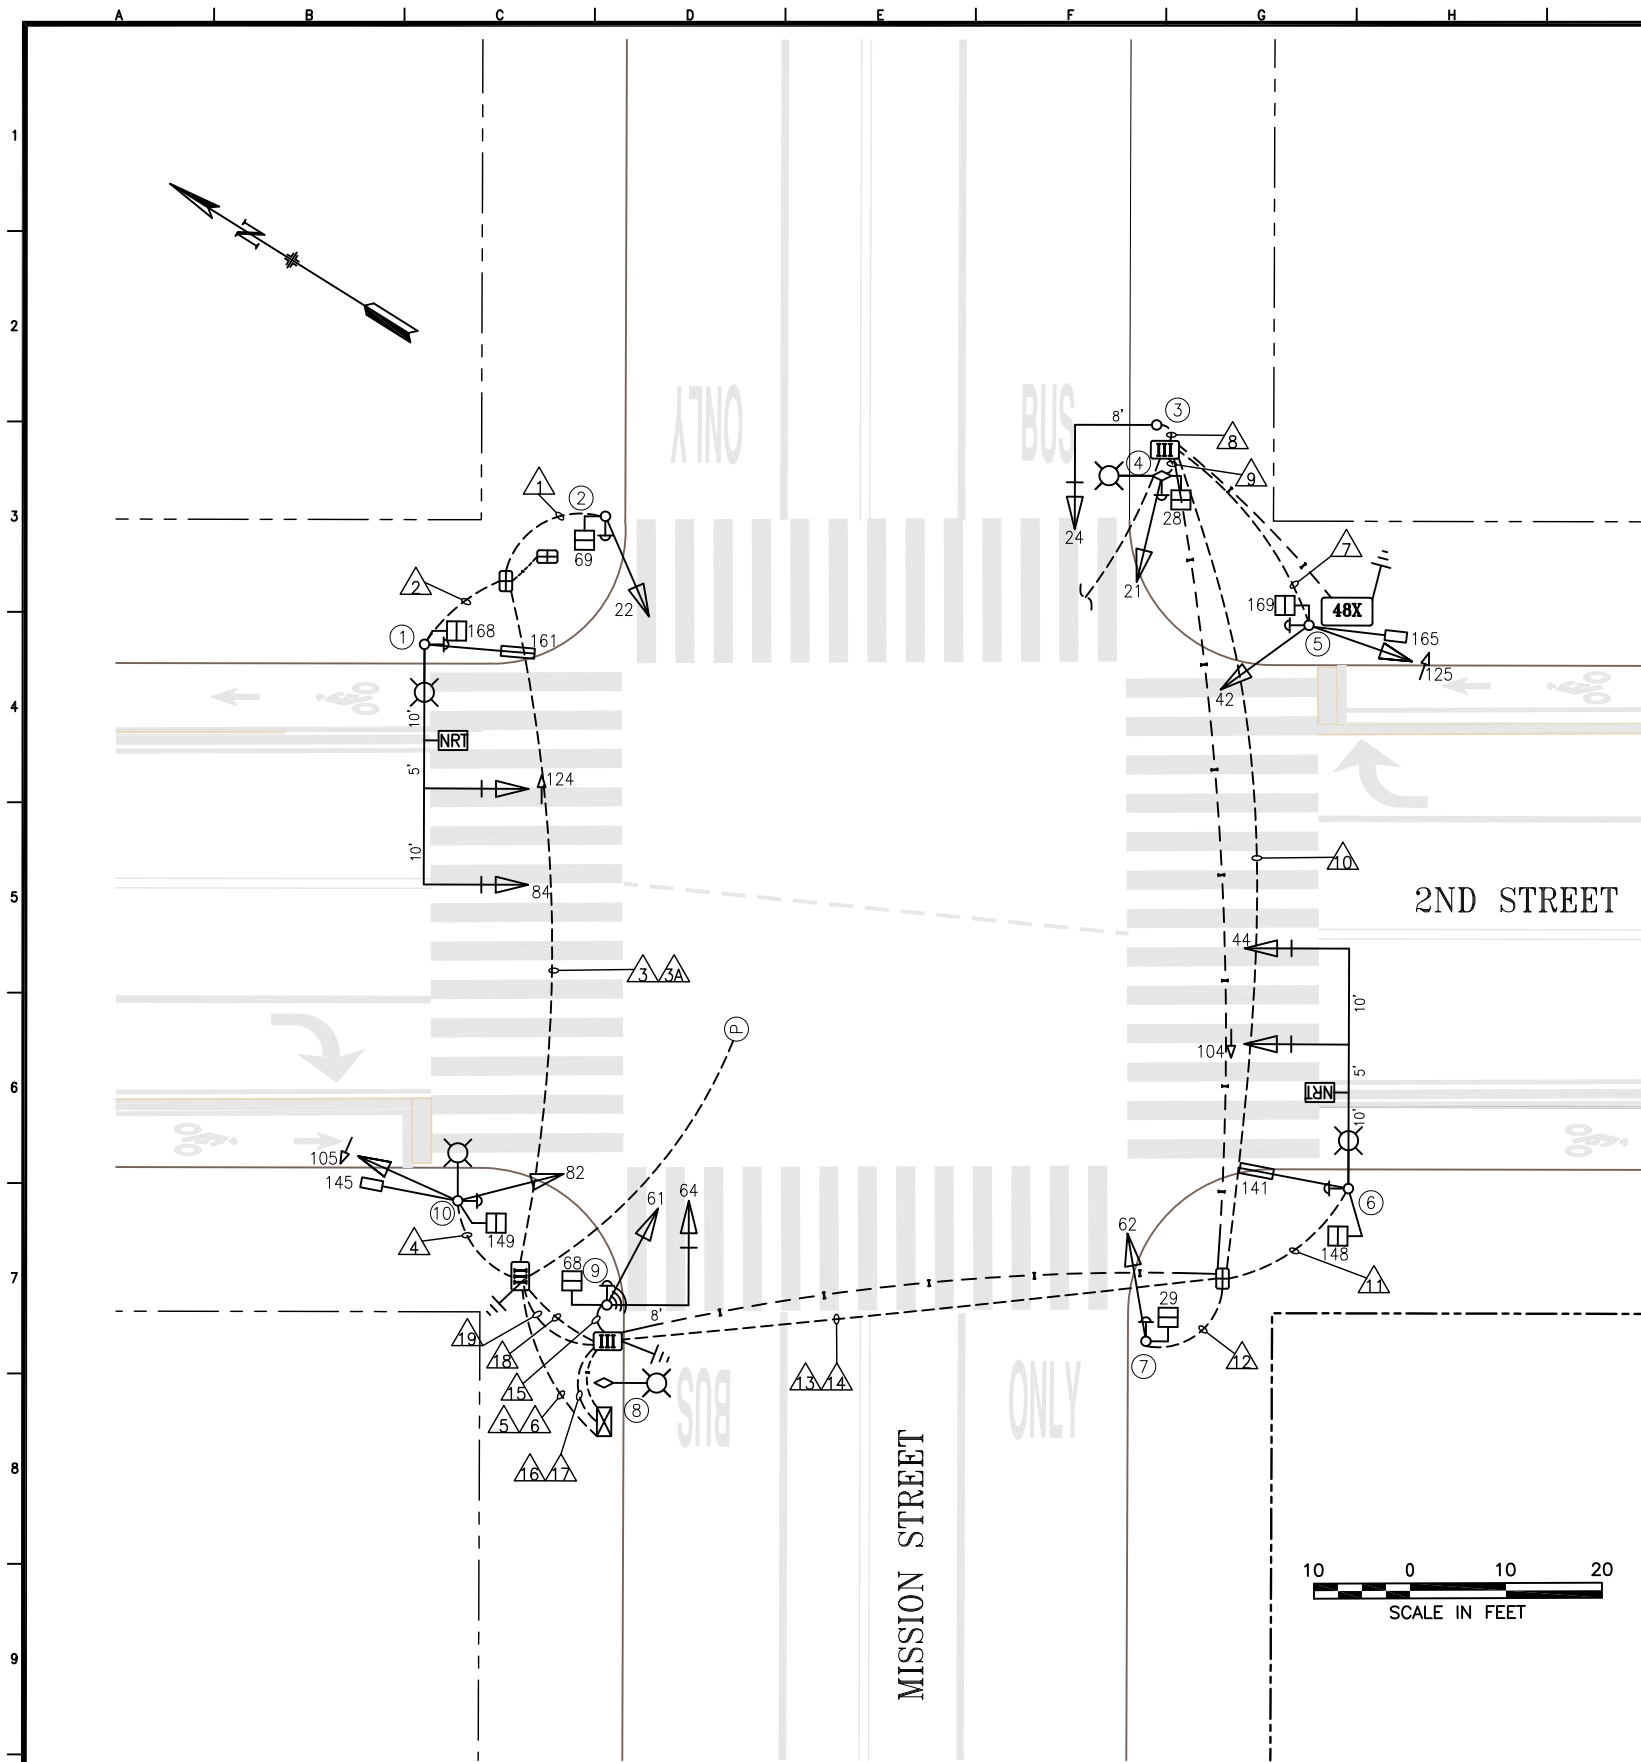

POLE AND EQUIPMENT SCHEDULE											
POLE No.	TYPE OF POLE	LUMINAIRE VOLTAGE/WATTAGE	VEHICLE SIGNAL					PEDESTRIAN SIGNAL			REMARKS
			No.	TYPE	MOUNTING	VISORS	LOUVERS	No.	TYPE	MOUNTING	
①	19-4-100 W/25 MAST ARM & 6' LUMINAIRE ARM		161 124 84	3S12" BIKE 3S12" RA 3S12" NRT	SV-1-T MAS MAS MAS	T T T		168	1S-COUNT	SP-1	BACKPLATE BACKPLATE APS-2W ①
②	1-A (10')		22	3S12"	TV-1-T	T		69	1S-COUNT	SP-1	APS-2W ①
③	16-1-70 WITH 8' MAST ARM		24	3S12"	MAS	T					BACKPLATE
④	MUNI POLE WITH LUMINAIRE FIXTURE		21	3S12"	SV-1-T	T		28	1S-COUNT	SP-1	APS-2W
⑤	1-A (13')		165 42 125	3S8" BIKE 3S12" 3S12" RA	SV-1 TV-2-T	T T T		169	1S-COUNT	SP-1	APS-2W
⑥	19-4-100 W/25 MAST ARM & 6' LUMINAIRE ARM		141 104 44	3S12" BIKE 3S12" RA 3S12" NRT	SV-1-T MAS MAS MAS	T T T		148	1S-COUNT	SP-1	BACKPLATE BACKPLATE APS-2W ①
⑦	1-A (10')		62	3S12"	TV-1-T	T		29	1S-COUNT	SP-1	APS-2W ①
⑧	MUNI POLE WITH LUMINAIRE FIXTURE										
⑨	16-1-70 WITH 8' MAST ARM		61 64	3S12" 3S12"	SV-1-T MAS	T T		68	1S-COUNT	SP-1	APS-2W BACKPLATE TSP EQUIPMENT
⑩	CITY STANDARD STREET LIGHT		145 82 105	3S8" BIKE 3S12" 3S12" RA	SV-1 SV-2-TA	T T T		149	1S-COUNT	SP-1	APS-2W

SHEET NOTES:

① POLE ON SUBSIDEWALK BASEMENT.

02/12/19	CONVERTED FROM CONTRACT 1064J	S.SHARIATI	M.GROWNEY	
NO.	DATE	DESCRIPTION	BY	APPROVED
TABLE OF REVISIONS				
CHECKOUT DRAWING THROUGH THE SID CUSTODIAN FOR THE LATEST REVISION				



SFMTA

DRAWN BY:	DATE:
SHAHRAM SHARAITI	02/07/22
CHECKED BY:	DATE:
MAURICE GROWNEY	03/21/22

SCALE
AS SHOWN
SHEET OF SHEETS
01 OF 02

TRAFFIC SIGNAL INVENTORY DIAGRAM
2ND STREET & MISSION STREET

CNN NO:
24597000
REV NO:
0

