
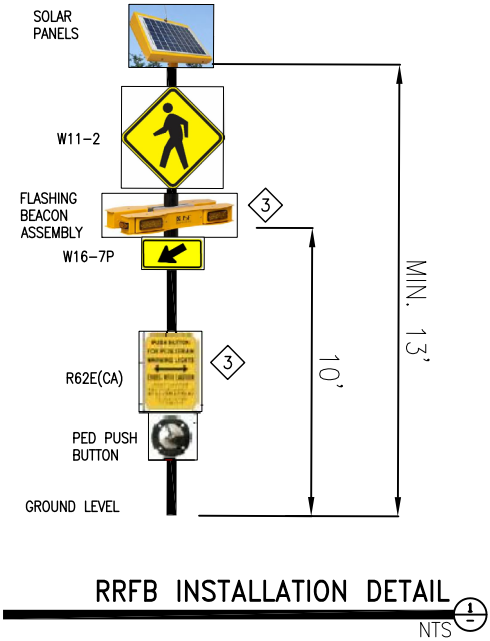


POLE AND EQUIPMENT SCHEDULE											
POLE No.	TYPE OF POLE	LUMINAIRE VOLTAGE/WATTAGE	VEHICLE SIGNAL					PEDESTRIAN SIGNAL			REMARKS
			No.	TYPE	MOUNTING	VISORS	LOUVERS	No.	TYPE	MOUNTING	
①	CITY STANDARD STREET LIGHT		22 61		SIDE MOUNT SIDE MOUNT						APS SOLAR POWERED
②	CITY STANDARD STREET LIGHT		21 62		SIDE MOUNT SIDE MOUNT						APS SOLAR POWERED

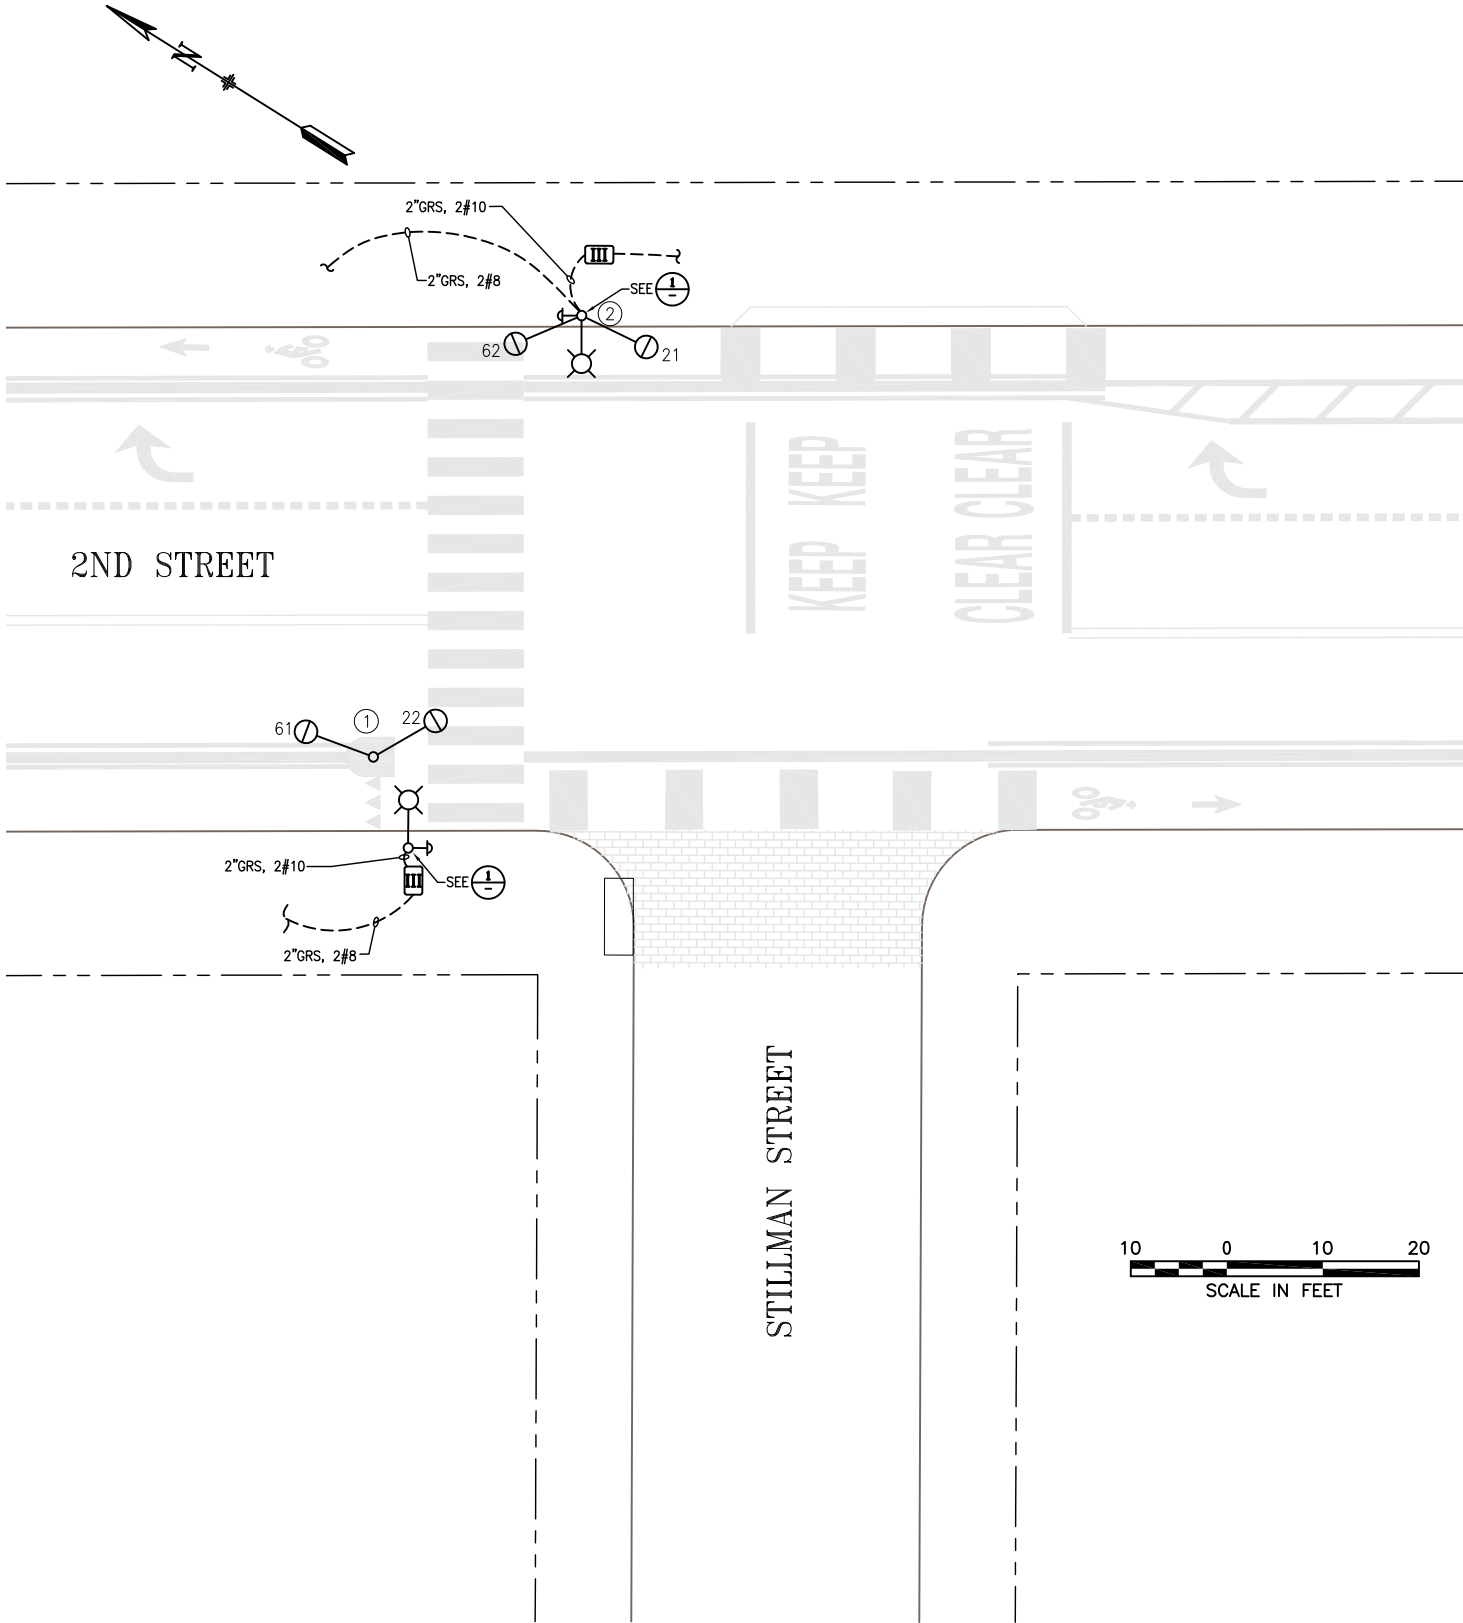

NO.	DATE	DESCRIPTION	BY	APPROVED	
1	11/19/20	CONVERTED FROM CONTRACT 1064J	S.SHARIATI	M.GROWNEY	
TABLE OF REVISIONS					
CHECKOUT DRAWING THROUGH THE SID CUSTODIAN FOR THE LATEST REVISION					

DRAWN BY: SHAHRAM SHARAITI

CHECKED BY: MAURICE GROWNEY

DATE: 02/07/22

DATE: 03/21/22

SCALE AS SHOWN

SHEET OF SHEETS 01 OF 01

TRAFFIC SIGNAL INVENTORY DIAGRAM

2ND STREET & STILLMAN STREET

CNN NO: 24492000

REV NO: 0