




|                                                                                          |          |                               |            |           |
|------------------------------------------------------------------------------------------|----------|-------------------------------|------------|-----------|
|                                                                                          |          |                               |            |           |
|                                                                                          |          |                               |            |           |
| A                                                                                        | 02/11/21 | CONVERTED FROM CONTRACT 1064J | S.SHARIATI | M.GROWNEY |
| NO.                                                                                      | DATE     | DESCRIPTION                   | BY         | APPROVED  |
| TABLE OF REVISIONS<br>CHECKOUT DRAWING THROUGH THE SID CUSTODIAN FOR THE LATEST REVISION |          |                               |            |           |

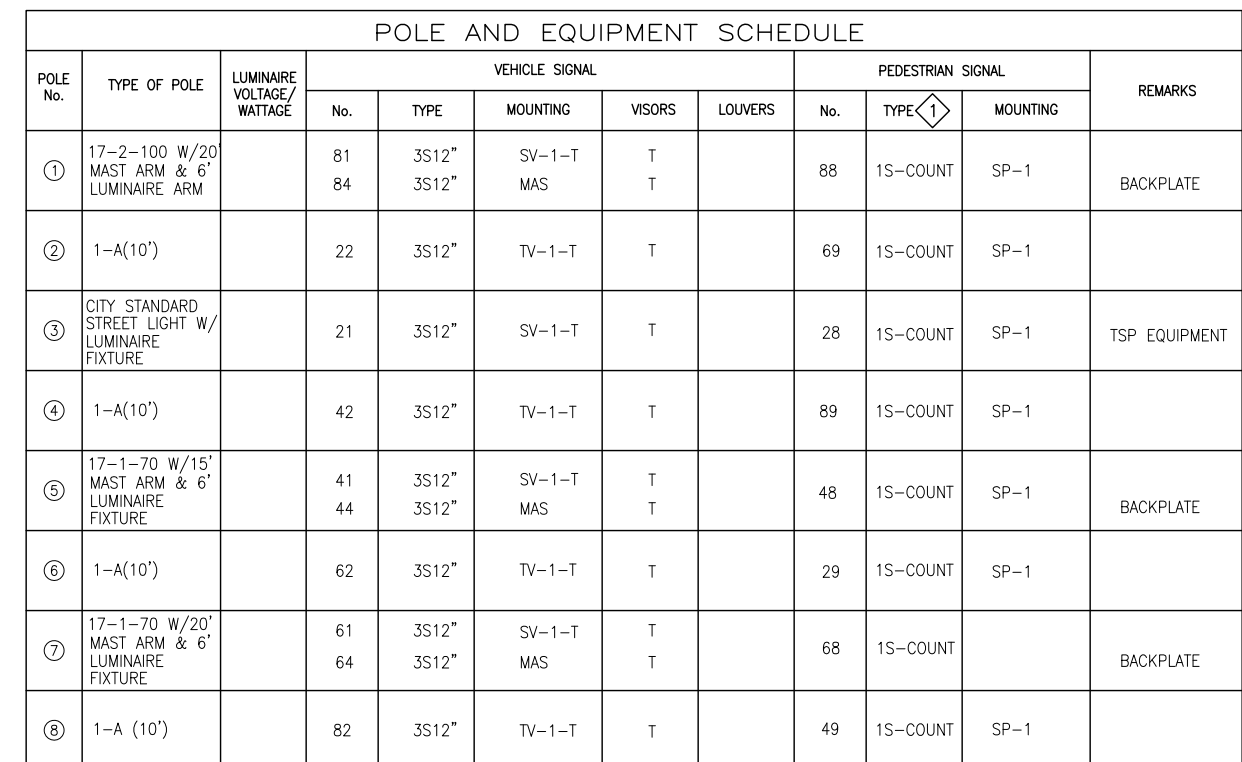

# SFMTA

|                  |          |
|------------------|----------|
|                  |          |
| DRAWN BY:        | DATE:    |
| SHAHRAM SHARAITI | 02/07/22 |
| CHECKED BY:      | DATE:    |
| MAURICE GROWNEY  | 03/21/22 |

SCALE  
AS SHOWN  
SHEET OF SHEETS  
01 OF 02

### TRAFFIC SIGNAL INVENTORY DIAGRAM

2ND STREET & TOWNSEND STREET

|         |          |
|---------|----------|
| CNN NO: | 23800000 |
| REV NO: | 0        |

[illegible]