



SWITCHOVER 4-13-04 0945
SLOP: W2, L17
ENGRG: ET

PHASE DIAGRAM:

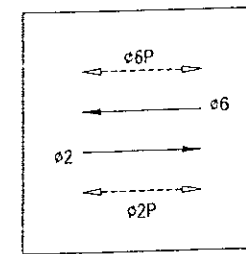

PHASES 2 & 6

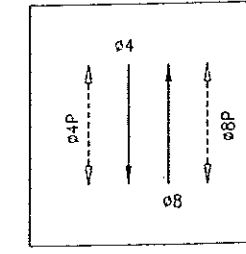

PHASES 4 & 8

PHASE SEQUENCE:

G	Y	R	GEARY BLVD
R		G	3RD AVE
RH		WM	PEDS XING GEARY BLVD
WM	FRH	RH	PEDS XING 3RD AVE

DETAIL NOTES:

- A1 EX CONDUIT AND WIRING. R/C EX WIRING. F/I NEW WIRING AS NOTED.
- A4 R/C EX CONDUIT AND WIRING. REPAIR SIDEWALK TO MATCH EX.
- A5 EX CONDUIT AND WIRING. R/C EX WIRING. CUT CONDUIT FLUSH TO PULL BOX WALL OR 12" DEPTH. CAP END(S).
- A10 R/C EX CONDUIT. REPULL EX 12/C TO THE PB AT SE CORNER.
- 38 THE CONTRACTOR TO NOTIFY RAY YAMAGISHI OF BLHP @ 554-0728 AFTER INSTALLING THE STREET LIGHTS TO DISCONNECT POWER AND AND EX LUMINAIRE ON PG&E WOODEN POLE.
- G5 CHIP EX FOUNDATION CAREFULLY TO BRING CONDUIT INTO BASE OF CONCRETE STANDARD AND REPAIR AFTER INSTALLATION. AVOID DAMAGE TO THE POLE REINFORCING STEEL.
- 13 TERMINATE REPULLED 12/C TO NEW IC LOCATION.
- 13 CONTRACTOR SHALL COORDINATE WITH PG&E TO DISCONNECT EX SERVICE WIRING. R/C EX CONDUIT AND WIRING. RESTORE SIDEWALK AND/OR PAVEMENT TO MATCH EX.
- 15 STREET LIGHT IS TO BE F/I UNDER/NEAR OVERHEAD UTILITY WIRES. CONTRACTOR IS RESPONSIBLE FOR COORDINATING WITH THE APPROPRIATE UTILITY COMPANIES TO PROVIDE NECESSARY SAFETY MEASURES FOR THE CONTRACTOR'S INSTALLATION OF THE STREET LIGHT POLE AND FOR THE CITY'S FUTURE MAINTENANCE OF THE STREET LIGHTS AFTER THIS PROJECT IS COMPLETED. ALL COORDINATION WITH THE UTILITY COMPANIES SHALL BE CONSIDERED AS INCIDENTAL WORK.
- 17 F/I IN-LINE FUSE HOLDER W/ 40A FUSE FOR STREET LIGHT SERVICE. F/I GROUND ROD.
- X4 STUB OUT AND CAP 3' FROM THE IC FOUNDATION.

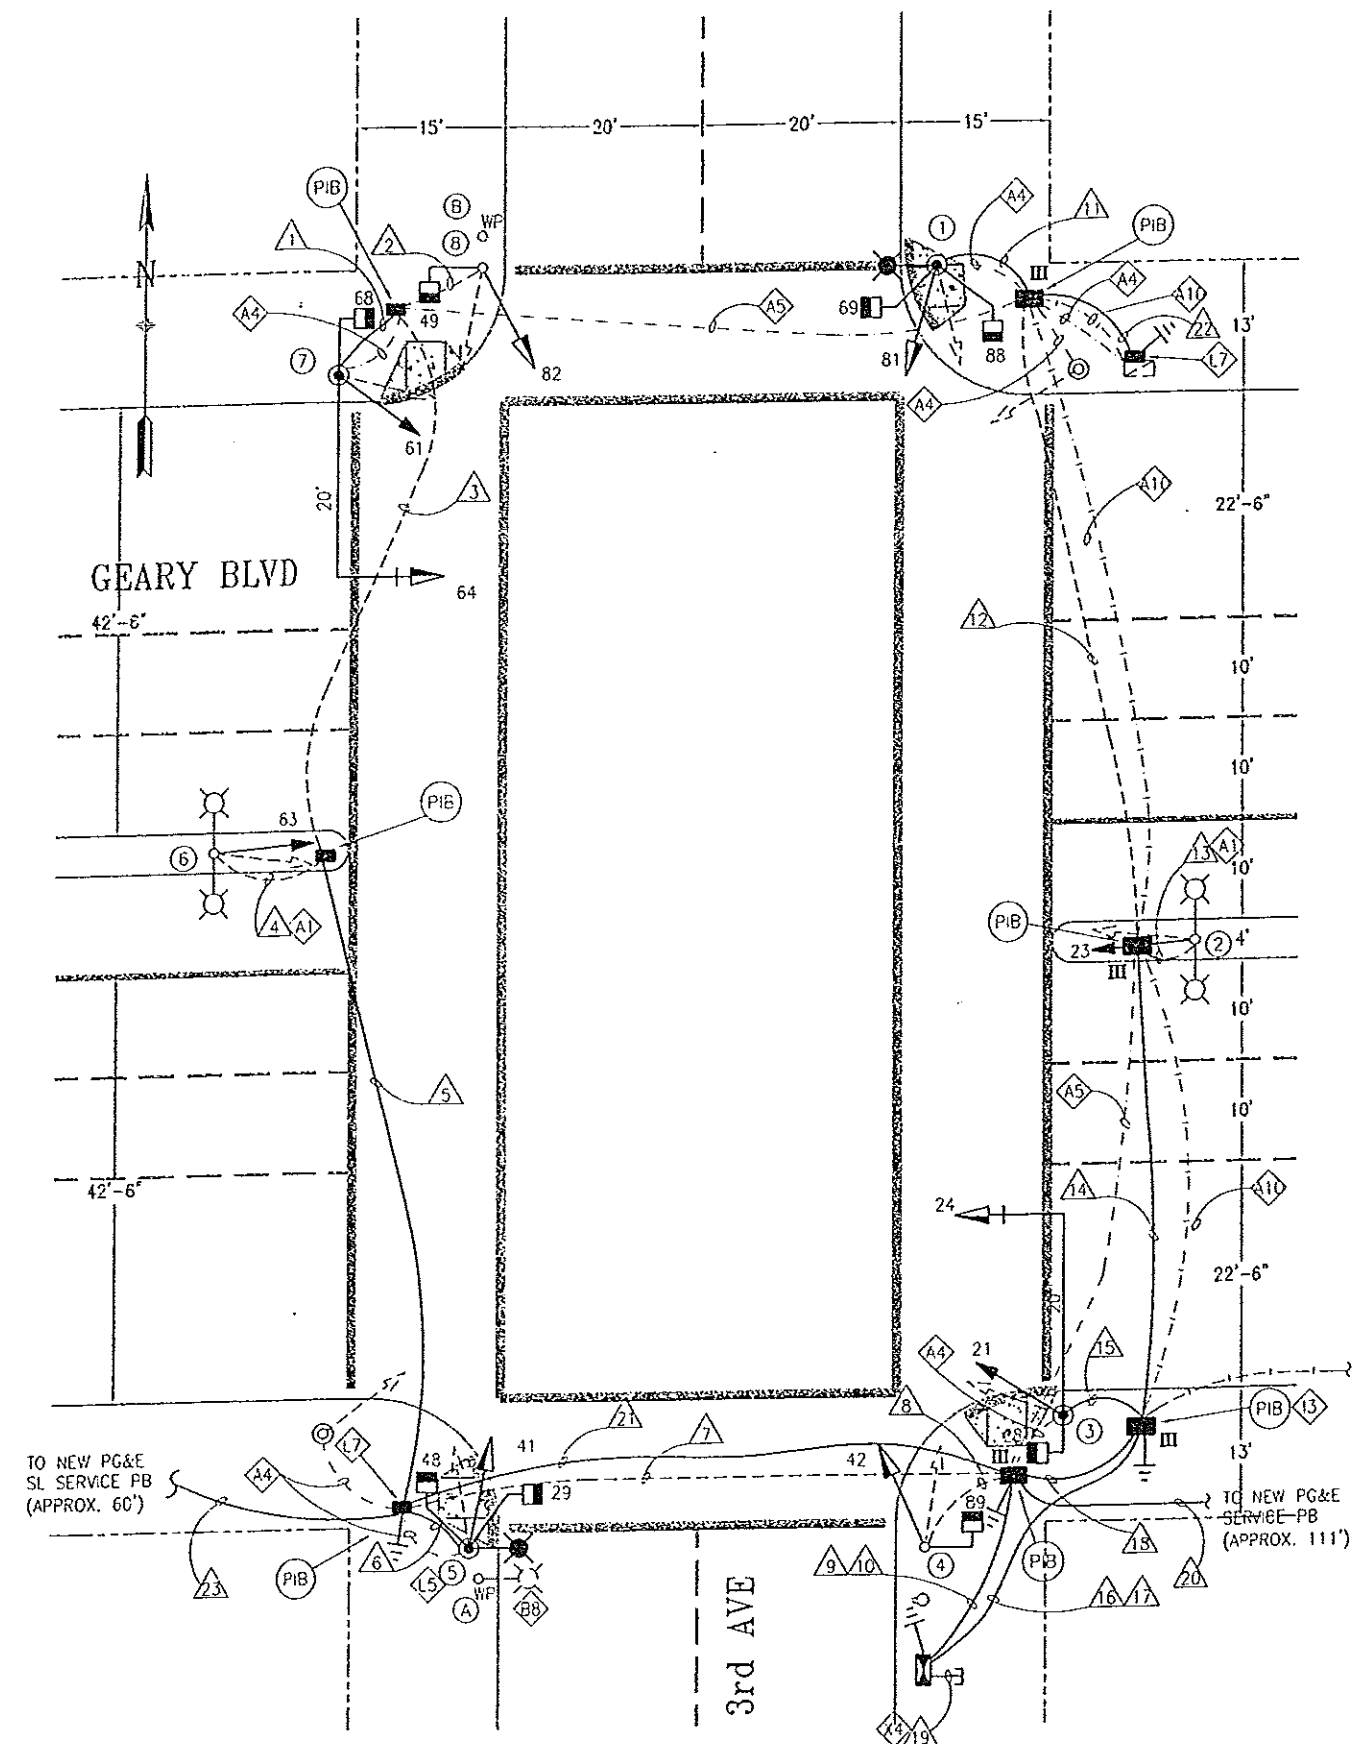


TABLE OF REVISIONS		REFERENCE INFORMATION & FILE NO. OF SURVEYS		BUREAU OF ENGINEERING DEPARTMENT OF PUBLIC WORKS CITY AND COUNTY OF SAN FRANCISCO	DESIGNED: DATE: 10/01	APPROVED: 11/1/01	SCALE: 1"=10'	GEARY BOULEVARD PAVEMENT RENOVATION	SPECIFICATION NO. 2019N
NO	DATE				DESCRIPTION	BY	APP		DRAWN: DATE: 10/01
CHECK WITH TRACING TO SEE IF YOU HAVE LATEST REVISION						CHECKED: DATE: 11/1/01	CITY ENGINEER: 11/1/01		FILE NO. 78.365
								3RD AVE & GEARY BLVD TRAFFIC SIGNAL WORK	REV. NO.