


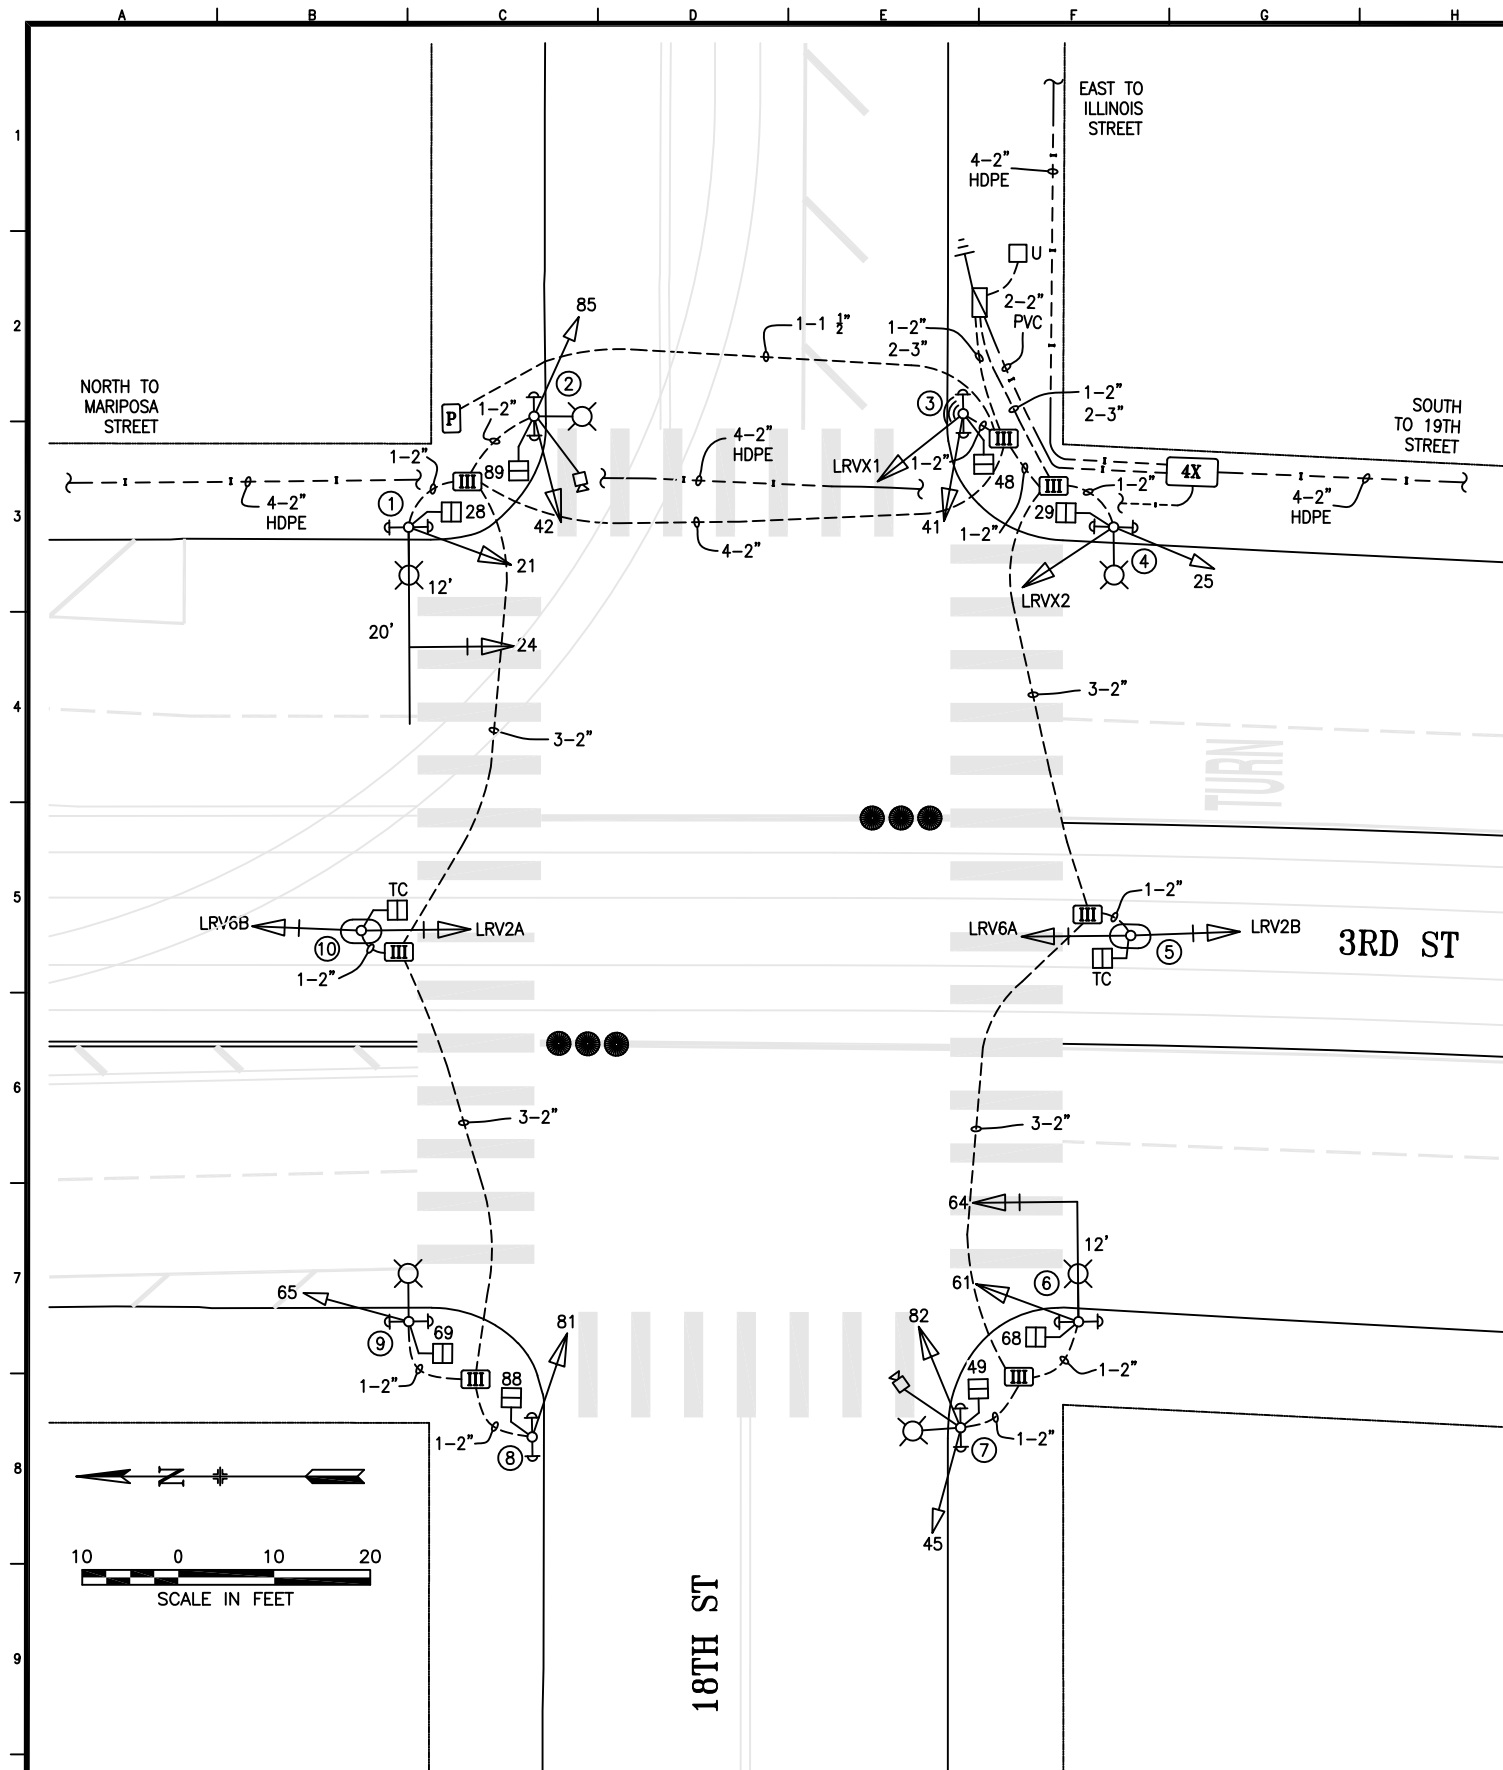

POLE AND EQUIPMENT SCHEDULE											
POLE No.	TYPE OF POLE	LUMINAIRE TYPE	VEHICLE SIGNAL					PEDESTRIAN SIGNAL			REMARKS
			No.	TYPE	MOUNTING	VISORS	LOUVERS/BP	No.	TYPE	MOUNTING	
①	MUNI COMBO POLE WITH 20' MAST ARM		21 24	3S12" 3S12" GVA	SV-1-T MAS	T T	BP	28	1S-COUNT	SP-1	PPB (2) DETAIL "E" ①
②	MUNI COMBO POLE		42 85	3S12" 3S8"	SV-2-TA	T T		89	1S-COUNT	SP-1	PPB (2) VDC
③	MUNI COMBO POLE		41 LRVX1	3S12" 2S12"LB-	SV-1-T SV-1	T T		48	1S-COUNT	SP-1	PPB (2) LRVX1 ⑩ 17 FT HIGH TSP EQUIPMENT
④	MUNI COMBO POLE		25 LRVX2	3S8" 2S12"LB-	SV-1-T SV-1	T T		29	1S-COUNT	SP-1	PPB (2) LRVX2 ⑩ 17 FT HIGH
⑤	1-A (12')		LRV2B LRV6A TC	2S12"LB- 2S12"LB- 1S 24"x24"	TV-2-T SV-1	T T T	BP BP				
⑥	MUNI COMBO POLE WITH 12' MAST ARM		61 64	3S12" 3S12" GVA	SV-1-T MAS	T T	BP	68	1S-COUNT	SP-1	PPB (2) DETAIL "A" ②
⑦	MUNI COMBO POLE		45 82	3S8" 3S12"	SV-2-TA	T T		49	1S-COUNT	SP-1	PPB (2) VDC
⑧	1-A (10')		81	3S12"	TV-1-T	T		88	1S-COUNT	SP-1	PPB (2)
⑨	MUNI COMBO POLE		65	3S8"	SV-1-T	T		69	1S-COUNT	SP-1	PPB (2)
⑩	1-A (12')		LRV2A LRV6B TC	2S12"LB- 2S12"LB- 1S 24"x24"	TV-2-T SV-1	T T T	BP BP				

GENERAL NOTES:

- CABINET FOUNDATION TYPE: M-SF
- TC = TRAIN COMING
- VDC = VIDEO DETECTION CAMERA

SHEET NOTES:

- ① SEE CONTRACT MR-1141, DRAWING T-11 FOR MAST ARM DETAIL
- ② SEE CONTRACT MR-1141, DRAWING T-10 FOR MAST ARM DETAIL

NO.	DATE	DESCRIPTION	BY	APPROVED
1	10/25/20	SRC 2019-343: INSTALLED TC ON POLES 5 & 10 AND PER FIELD CHECK	T. YOUNG	M. VELASCO
2	11/12/18	SRC 2018-214: CONVERT "T" TO BAR FOR SIGNALS LRV2A, LRV2B, LRV6A, LRV6B, LRVX1 & LRVX2	T. YOUNG	M. VELASCO
3	5/26/14	SRC 2014-100: DELETE SIGNAL 63, INSTALL GVAs	B. WOO	C. WONG
4	3/16/04	TRAFFIC SIGNAL UPGRADE FOR THIRD STREET LIGHT RAIL CT#MR-1141	D. YEUNG	A. HERCE
TABLE OF REVISIONS			CHECKOUT DRAWING THROUGH THE SID CUSTODIAN FOR THE LATEST REVISION	



SFMTA

DRAWN BY: D. YEUNG	DATE: 7/2006
CHECKED BY: A. HERCE	DATE: 7/2007

SCALE AS SHOWN
SHEET OF SHEETS 1 OF 1

TRAFFIC SIGNAL INVENTORY DIAGRAM
3RD AND 18TH STS INTERSECTION

CNN NO: 23570000
REV NO: 4