


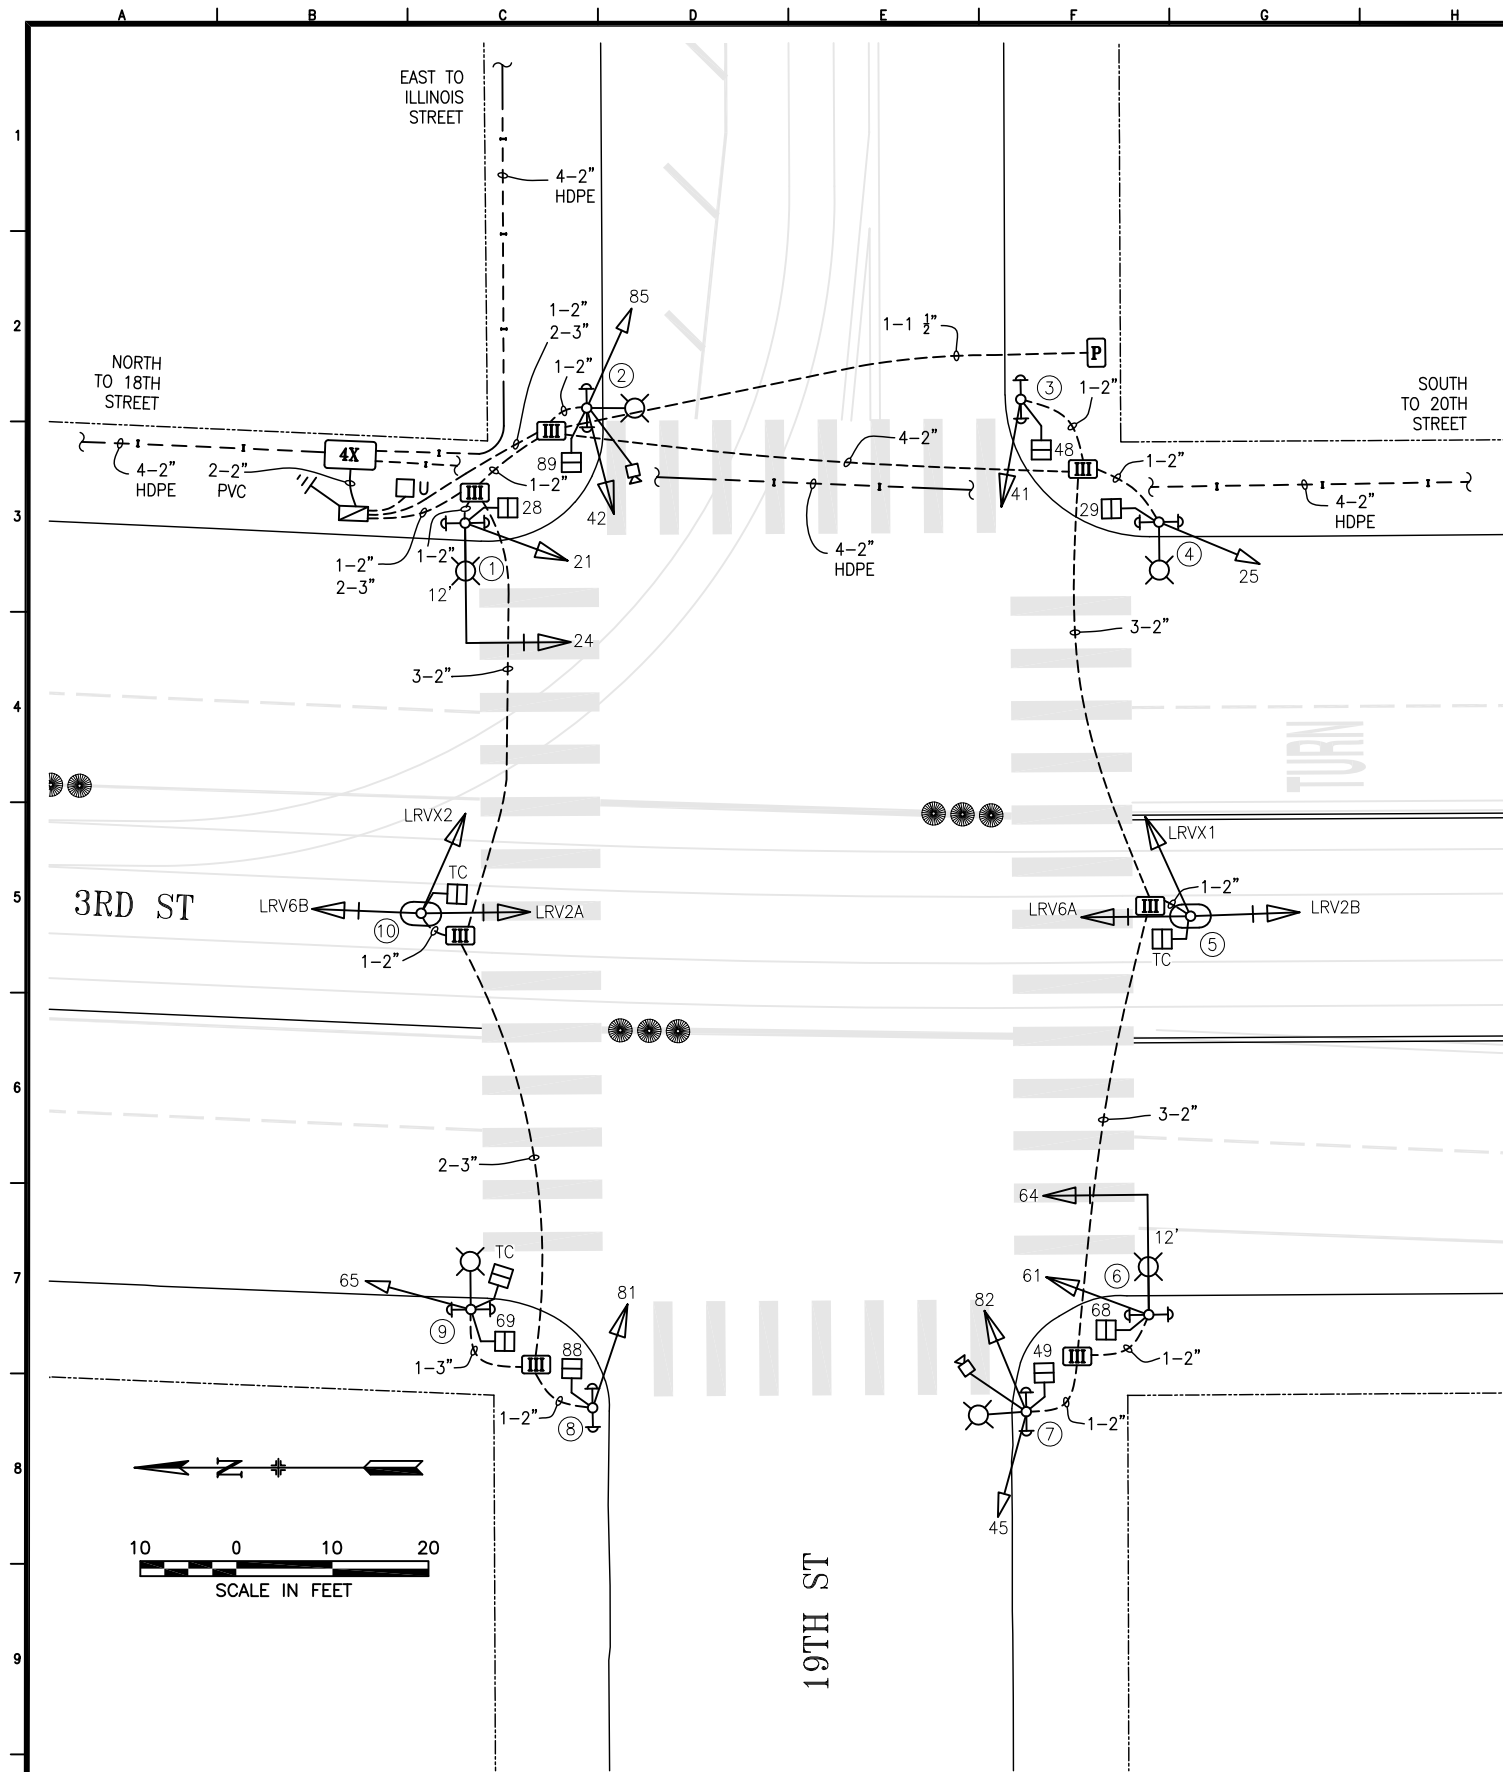

POLE AND EQUIPMENT SCHEDULE											
POLE No.	TYPE OF POLE	LUMINAIRE TYPE	VEHICLE SIGNAL					PEDESTRIAN SIGNAL			REMARKS
			No.	TYPE	MOUNTING	VISORS	LOUVERS/BP	No.	TYPE	MOUNTING	
①	MUNI COMBO POLE WITH 12' MAST ARM		21 24	3S12" 3S12" GVA	SV-1-T MAS	T T	BP	28	1S-COUNT	SP-1	PPB (2) DETAIL "A" ①
②	MUNI COMBO POLE		42 85	3S12" 3S8"	SV-2-TA	T T		89	1S-COUNT	SP-1	PPB (2) VDC
③	1-A (10')		41	3S12"	TV-1-T	T		48	1S-COUNT	SP-1	PPB (2)
④	MUNI COMBO POLE		25	3S8"	SV-1-T	T		29	1S-COUNT	SP-1	PPB (2)
⑤	1-A (12')		LRV2B LRV6A LRVX1 TC	2S12"LB- 2S12"LB- 2S12"LB- 1S 24"x24"	TV-3-T SV-1	T T T T	BP BP				
⑥	MUNI COMBO POLE WITH 12' MAST ARM		61 64	3S12" 3S12" GVA	SV-1-T MAS	T T	BP	68	1S-COUNT	SP-1	PPB (2) DETAIL "A" ①
⑦	MUNI COMBO POLE		45 82	3S8" 3S12"	SV-2-TA	T T		49	1S-COUNT	SP-1	PPB (2) VDC
⑧	1-A (10')		81	3S12"	TV-1-T	T		88	1S-COUNT	SP-1	PPB (2)
⑨	MUNI COMBO POLE		65 TC	3S8" 1S 24"x24"	SV-1-T SV-1	T T		69	1S-COUNT	SP-1	PPB (2)
⑩	1-A (12')		LRV2A LRV6B LRVX2 TC	2S12"LB- 2S12"LB- 2S12"LB- 1S 24"x24"	TV-3-T SV-1	T T T T	BP BP				

GENERAL NOTES:

1. CABINET FOUNDATION TYPE: M-SF
2. TC = TRAIN COMING
3. VDC = VIDEO DETECTION CAMERA

SHEET NOTES:

① SEE CONTRACT MR-1141, DRAWING T-10 FOR MAST ARM DETAIL

NO.	DATE	DESCRIPTION	BY	APPROVED
1	10/25/20	SRC 2019-343: INSTALLED TC ON POLES 5, 9 & 10 AND PER FIELD CHECK	T. YOUNG	M. VELASCO
2	5/18/14	SRC 2014-100: DELETE SIGNALS 23 & 63, INSTALL LUNAR BARS AND GVAs	B. WOO	C. WONG
3	3/31/04	TRAFFIC SIGNAL UPGRADE FOR THIRD STREET LIGHT RAIL CT#MR-1141	D. YEUNG	A. HERCE

TABLE OF REVISIONS
CHECKOUT DRAWING THROUGH THE SID CUSTODIAN FOR THE LATEST REVISION



SFMTA

DRAWN BY: D. YEUNG	DATE: 7/2006
CHECKED BY: A. HERCE	DATE: 7/2007

SCALE AS SHOWN
SHEET OF SHEETS 1 OF 1

TRAFFIC SIGNAL INVENTORY DIAGRAM
3RD AND 19TH STS INTERSECTION

CNN NO: 23567000
REV NO: 3