




POLE AND EQUIPMENT SCHEDULE											
POLE No.	TYPE OF POLE	LUMINAIRE TYPE	VEHICLE SIGNAL					PEDESTRIAN SIGNAL			REMARKS
			No.	TYPE	MOUNTING	VISORS	LOUVERS/BP	No.	TYPE	MOUNTING	
①	MUNI COMBO POLE W/25' MAST ARM		21 24 54 TC	3S12" 3S12" 3S12"LA 1S 24"X24"	SV-1-T MAS MAS MAC	T T T T	BP BP BP	28	1S-COUNT	SP-1	APS DETECTION CAMERA 
②	STREET LIGHT POLE		45 82	3S8" 3S12" PV	SV-2-T	T T		49	1S-COUNT	SP-1	APS DETECTION CAMERA
③	1-A (10')		81	3S12"	TV-1-T	T		88	1S-COUNT	SP-1	APS
④	1-A (10')		12	3S12"LA	TV-1-T	T	BP	29	1S-COUNT	SP-1	APS
⑤	MUNI COMBO POLE		25	3S8"	SV-1-T	T					
⑥	1-A (12')		LRV2B LRV6A	2S12"LB 2S12"LB	TV-2-T	T T	BP BP				
⑦	PPB POLE										APS W/SIGN (←→)
⑧	MUNI COMBO POLE W/25' MAST ARM		14 61 64 TC	3S12"LA 3S12" 3S12" 1S 24"X24"	MAS SV-1-T MAS MAC	T T T T	BP BP BP -	68	1S-COUNT	SP-1	APS DETECTION CAMERA 
⑨	1-A (10')		PV 42 85	3S12"PV 3S8"	TV-2-T	T T		89	1S-COUNT	SP-1	APS
⑩	1-A (10')		41	3S12"	TV-1-T	T		48	1S-COUNT	SP-1	APS
⑪	1-A (10')		52	3S12"LA	TV-1-T	T	BP	69	1S-COUNT	SP-1	APS
⑫	MUNI COMBO POLE		65	3S8"	SV-1-T	T					
⑬	1-A (12')		LRV2A LRV6B	2S12"LB 2S12"LB	TV-2-T	T T	BP BP				
⑭	PPB POLE										APS W/SIGN (←→)

- SHEET NOTES:**
- ① CABINET FOUNDATION TYPE: M-SF
 - ② TC = TRAIN COMING
 - ③ TO VTS CABINET - SEE CONTRACT MR-1147, SHEET EL-28 FOR FURTHER DETAILS
 - ④ SEE DETAIL 'E', CONTRACT MR-1142, DRAWING T-11 FOR MAST ARM DETAILS

NO.	DATE	DESCRIPTION	BY	APPROVED
Δ	5/12/22	SRC 2021-171: INSTALLED 24"X24" FTC ON POLE 1	T. YOUNG	C. LIU
Δ	10/29/16	SRC 2016-172: INSTALL 36"X36" FTC ON POLE 8	T. YOUNG	C. LIU
Δ	5/4/14	SRC 2014-065: INSTALL LUNAR BARS, DELETE SIGNALS 15 AND 53	B. WOO	C. WONG
Δ	9/22/05	TRAFFIC SIGNAL UPGRADE FOR THIRD STREET LIGHT RAIL CT#MR-1142	D. YEUNG	A. HERCE
TABLE OF REVISIONS CHECKOUT DRAWING THROUGH THE SID CUSTODIAN FOR THE LATEST REVISION				

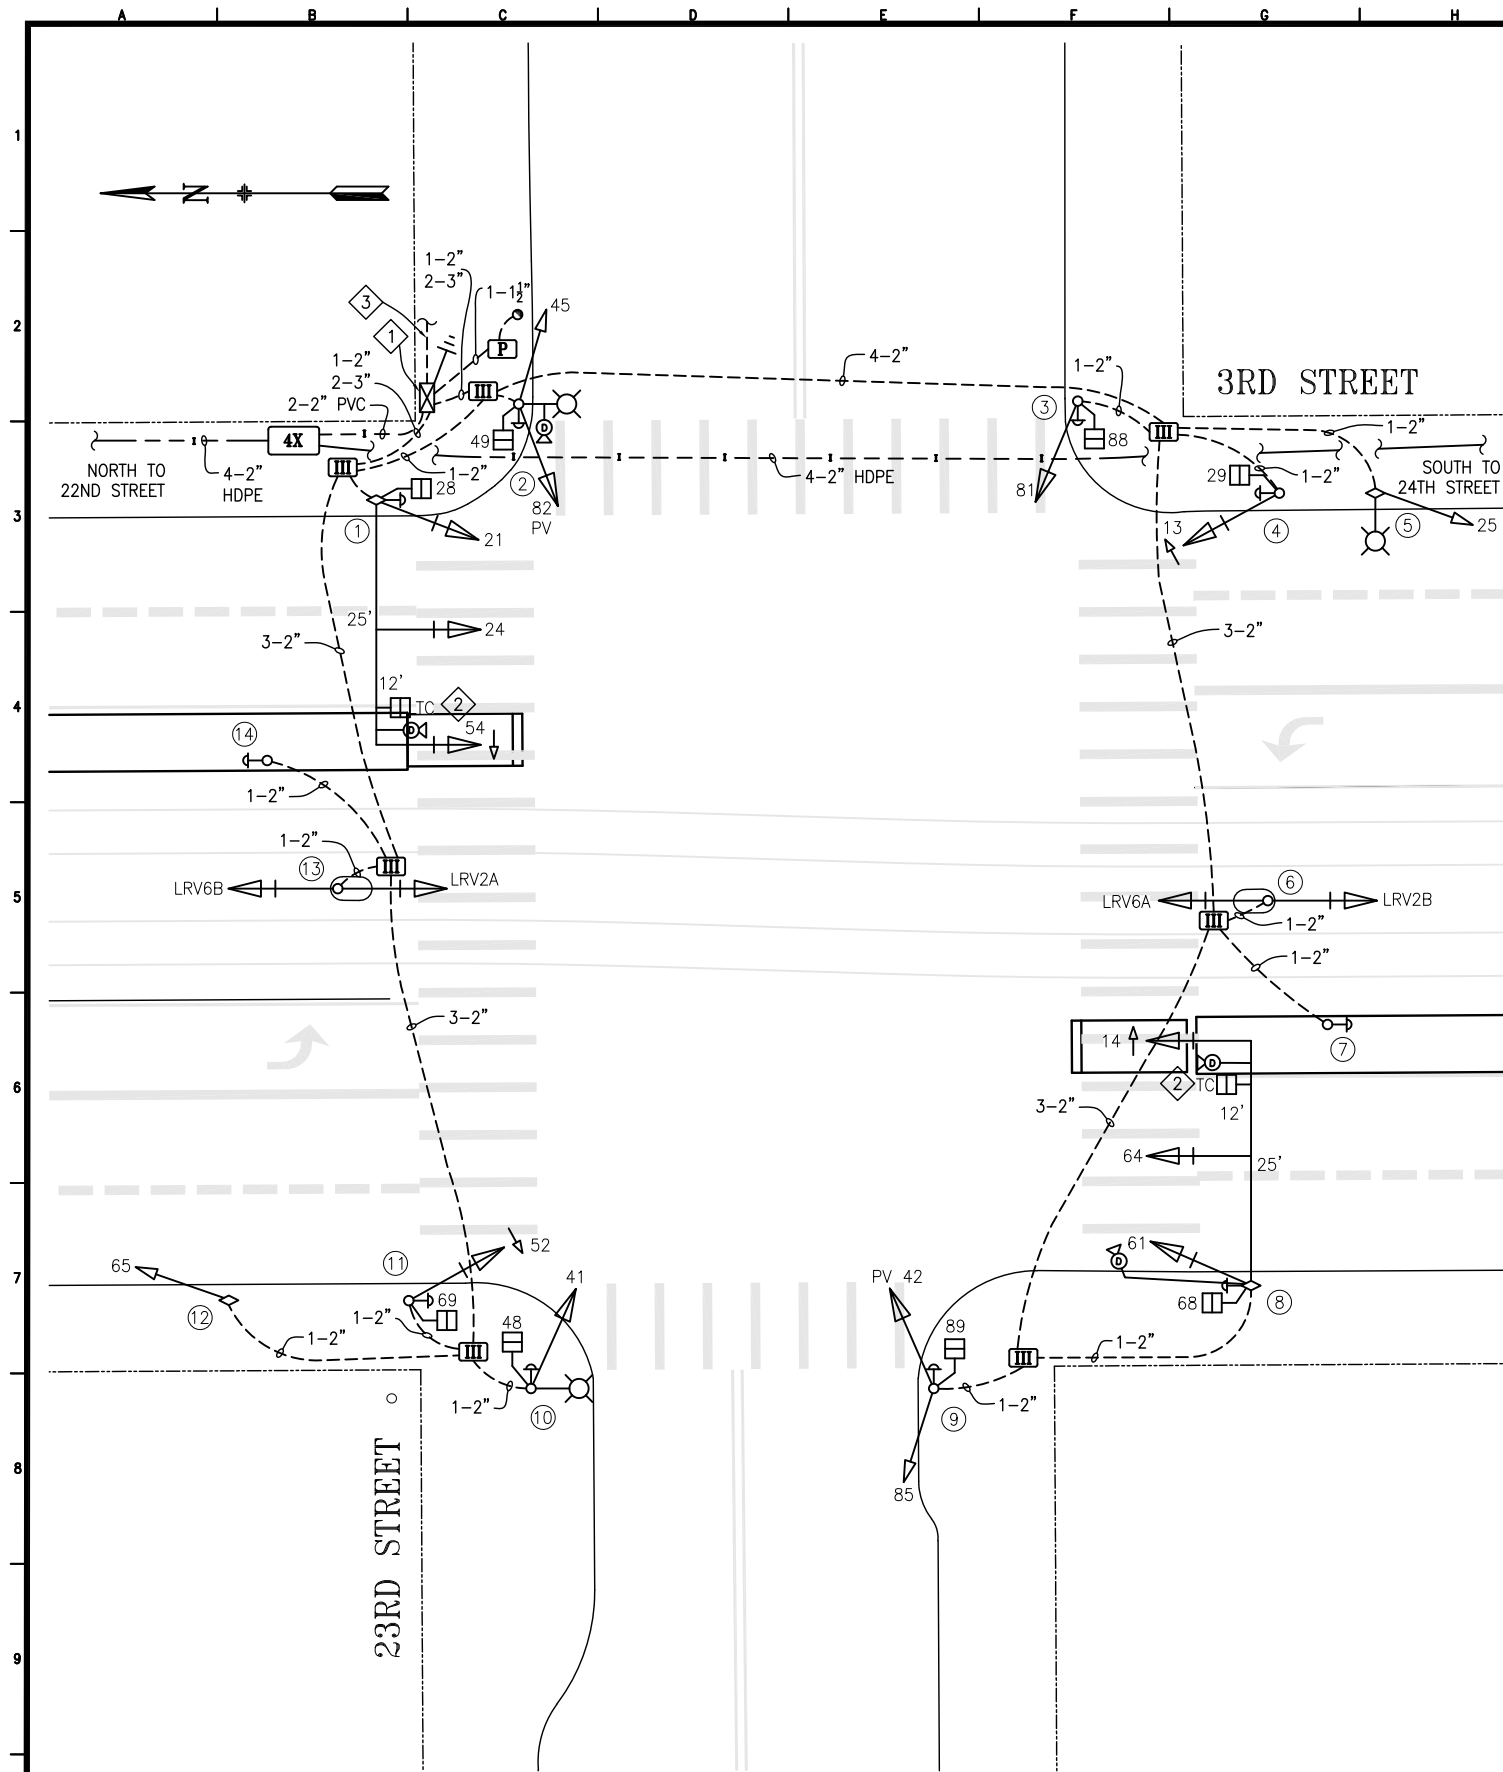

SFMTA

DRAWN BY: T. YOUNG	DATE: 6/2022
CHECKED BY: C. LIU	DATE: 6/2022

SCALE 1"=10'
SHEET OF SHEETS 1 OF 1

TRAFFIC SIGNAL INVENTORY DIAGRAM
3RD STREET & 23RD STREET

CNN NO: 23551000
REV NO: 4