


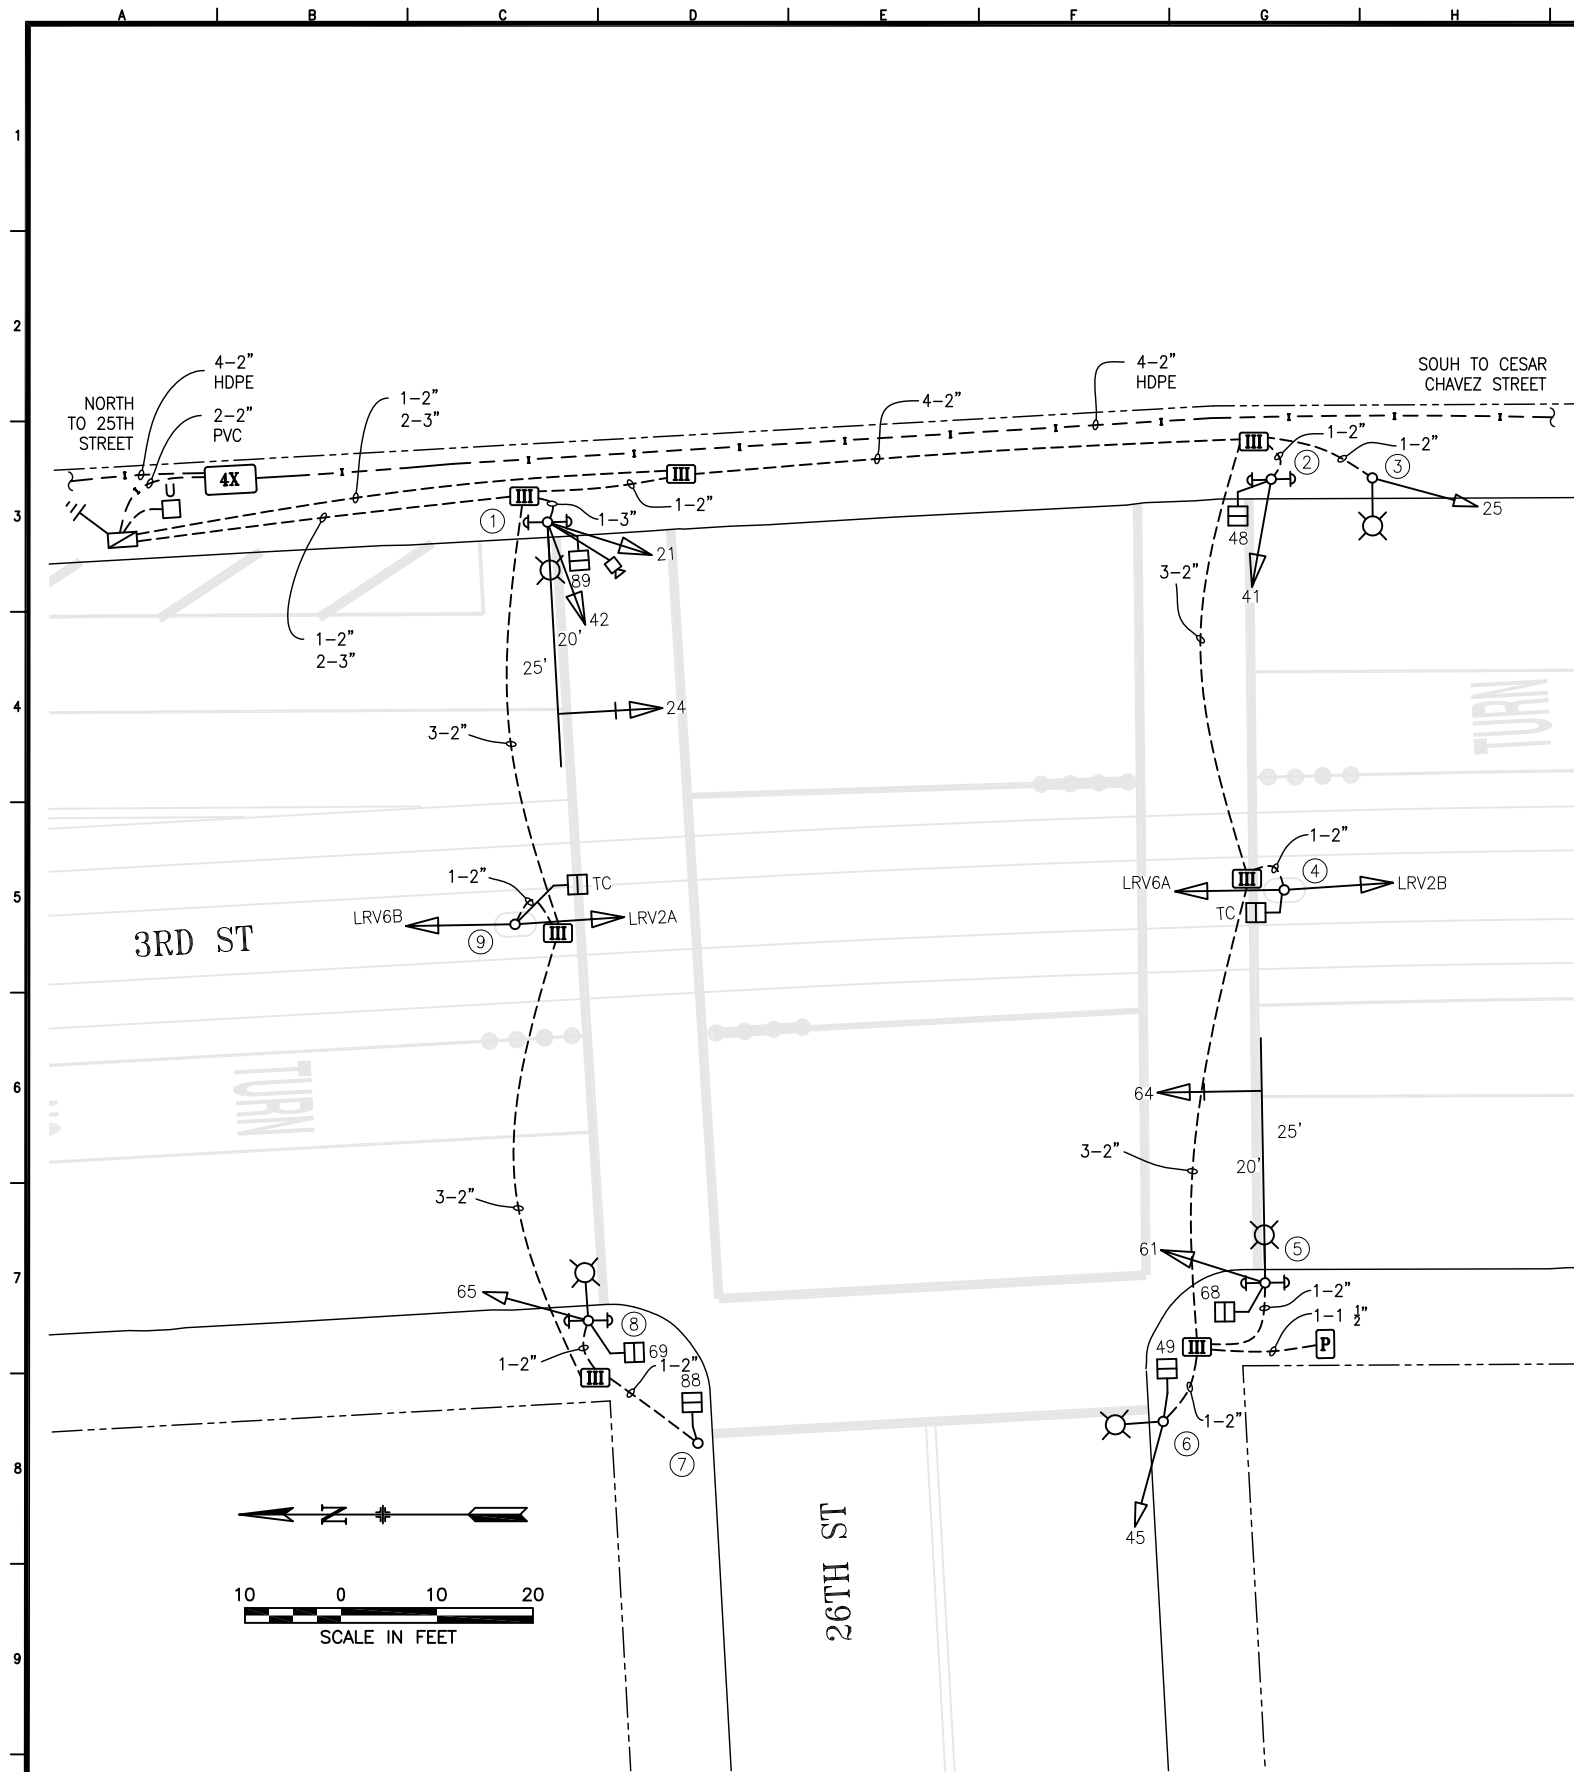

POLE AND EQUIPMENT SCHEDULE											
POLE No.	TYPE OF POLE	LUMINAIRE TYPE	VEHICLE SIGNAL					PEDESTRIAN SIGNAL			REMARKS
			No.	TYPE	MOUNTING	VISORS	LOUVERS/BP	No.	TYPE	MOUNTING	
①	MUNI COMBO POLE WITH 25' MAST ARM		21 42 24	3S12" 3S12" 3S12" GVA	SV-2-T MAS	T T T	BP	89	1S-COUNT	SP-1	PPB (2) VDC MUNI POLE #2991 DETAIL "F" ①
②	1-A (10')		41	3S12"	TV-1-T	T		48	1S-COUNT	SP-1	PPB (2)
③	MUNI COMBO POLE		25	3S8"	SV-1-T	T					MUNI POLE #3001
④	1-A (12')		LRV2B LRV6A TC	2S12"LB- 2S12"LB- 1S 24"X24"	TV-2-T SV-1	T T T					
⑤	MUNI COMBO POLE WITH 25' MAST ARM		61 64	3S12" 3S12" GVA	SV-1-T MAS	T T	BP	68	1S-COUNT	SP-1	PPB (2) MUNI POLE #3000 DETAIL "F" ①
⑥	STREETLIGHT POLE		45	3S8"	SV-1-T	T		49	1S-COUNT	SP-1	
⑦	1-A (7')							88	1S-COUNT	TP-1	
⑧	MUNI COMBO POLE		65	3S8"	SV-1-T	T		69	1S-COUNT	SP-1	PPB (2) MUNI POLE #2990
⑨	1-A (12')		LRV2A LRV6B TC	2S12"LB- 2S12"LB- 1S 24"X24"	TV-2-T SV-1	T T T					

GENERAL NOTES:

- 1. CABINET FOUNDATION TYPE: M-SF
- 2. TC = TRAIN COMING
- 3. VDC = VIDEO DETECTION CAMERA

SHEET NOTES:

① SEE CONTRACT MR-1142, DRAWING T-11 FOR MAST ARM DETAIL

NO.	DATE	DESCRIPTION	BY	APPROVED
1	5/29/21	SRC 2019-343: INSTALLED TC ON POLES 4 & 9 AND PER FIELD CHECK	T. YOUNG	M. VELASCO
2	4/6/14	SRC 2014-065: ADDED LUNAR BARS FOR LRV2A/LRV2B/LRV6A/LRV6B & GREEN VERTICAL ARROWS FOR 24 & 64	B. WOO	C. WONG
3	10/13/05	TRAFFIC SIGNAL UPGRADE FOR THIRD STREET LIGHT RAIL CT#MR-1142	D. YEUNG	A. HERCE
TABLE OF REVISIONS				
CHECKOUT DRAWING THROUGH THE SID CUSTODIAN FOR THE LATEST REVISION				



SFMTA

DRAWN BY: D. YEUNG	DATE: 7/2006
CHECKED BY: A. HERCE	DATE: 8/2006

SCALE AS SHOWN
SHEET OF SHEETS 1 OF 1

TRAFFIC SIGNAL INVENTORY DIAGRAM
3RD AND 26TH STS INTERSECTION

CNN NO: 23536000
REV NO: 3