


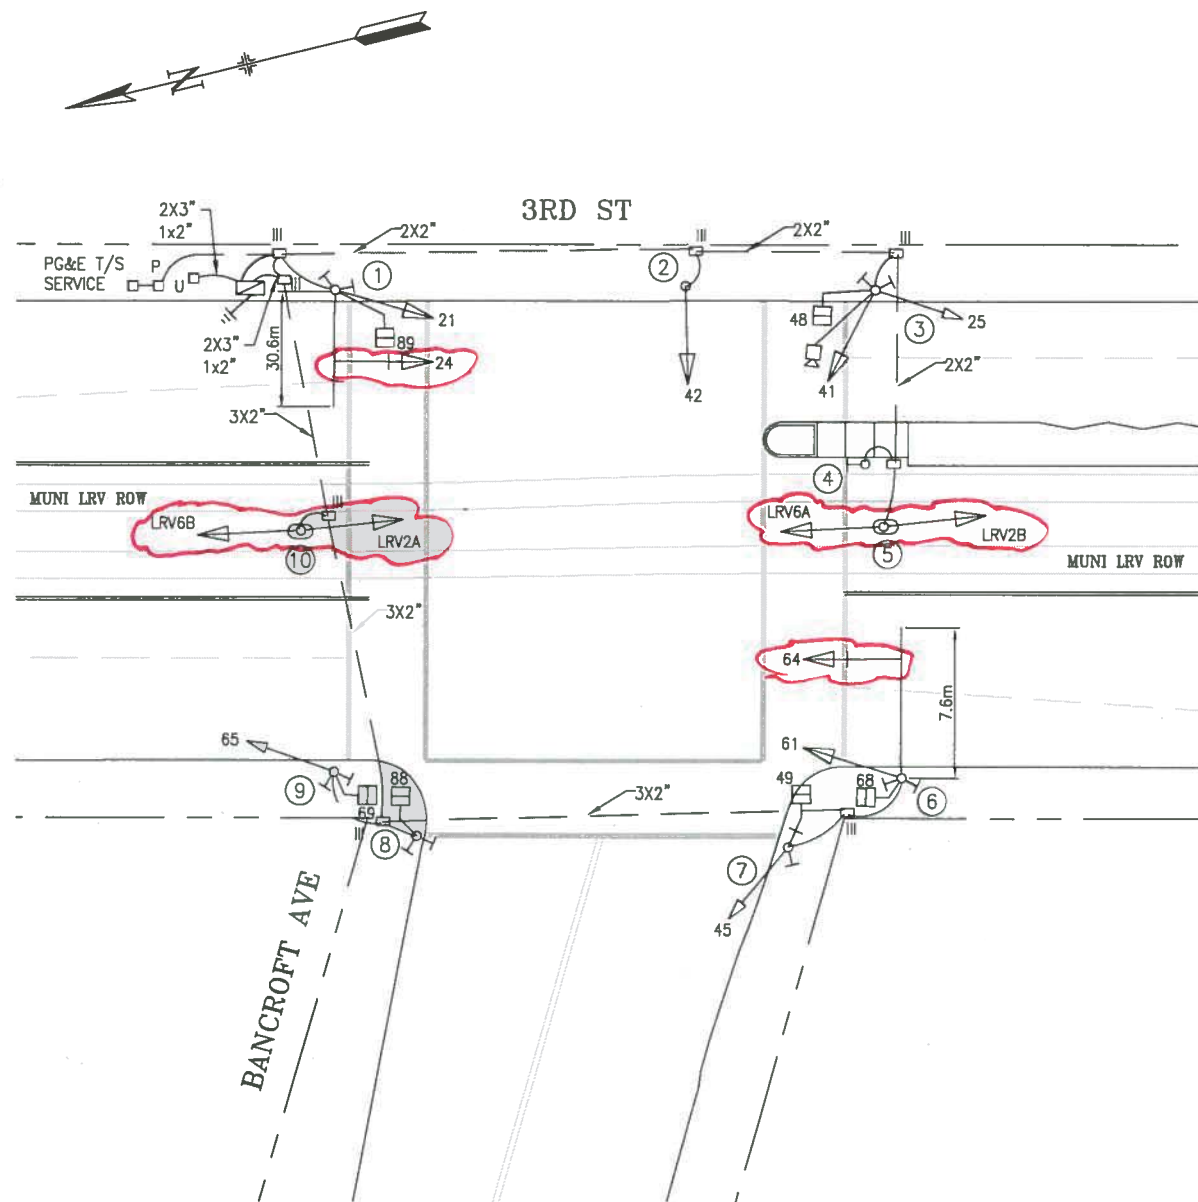


NOTE:
CABINET FOUNDATION TYPE: M-SF

POLE AND EQUIPMENT SCHEDULE

POLE No.	TYPE OF POLE	LUMINAIRE (HPS) VOLTAGE/ WATTS	VEHICLE SIGNAL			PEDESTRIAN SIGNAL			REMARKS
			No.	TYPE	MOUNTING (F/I)	No.	TYPE	MOUNTING (F/I)	
①	MUNI COMBO POLE WITH 6.1m M.A.		21 24	3S12" 3S12" <i>GVA</i>	SV-1-T MAS	89	1S-LED	SP-1	PPB
②	TYPE 1-A (3.05m)		42	3S12"	TV-1-T				
③	MUNI COMBO POLE		25 41	3S8" 3S12"	SV-2-T	48	1S-LED	SP-1	PPB
④	PPB POST								PPB W/ SIGNS (---) POLE LOCATION, REFER TO ST DRAWINGS
⑤	TYPE 1-A (3.6m) <i>2S12"LB-1</i>		LRV2B LRV6A	2S12" T 2S12" T	TV-2-T				
⑥	MUNI COMBO POLE WITH 7.6m M.A.		64 61	3S12" <i>GVA</i> 3S12"	MAS SV-1-T	68	1S-LED	SP-1	PPB
⑦	STREET LIGHT		45	3S8"	SV-1-T	49	1S-LED	SP-1	PPB
⑧	TYPE 1-A (2.13m)					88	1S-LED	TP-1	PPB
⑨	MUNI COMBO POLE		65	3S8"	SV-1-T	69	1S-LED	SP-1	PPB
⑩	TYPE 1-A (3.6m)		LRV2A LRV6B	2S12" T 2S12" T	TV-2-T				
				<i>2S12"LB-1</i>					

M.A. = MAST ARM

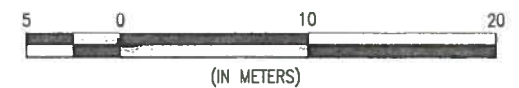

NO.	DATE	DESCRIPTION	BY	APP.
2	2/16/14	RED MARK CHANGES PER SRC 2014-019	BW	CW
1	1/6/05	TRAFFIC SIGNAL UPGRADE FOR THIRD STREET LIGHT RAIL	DY	AH
TABLE OF REVISIONS				
CHECK WITH TRACING TO SEE IF YOU HAVE LATEST REVISION				



DEPARTMENT OF PARKING AND TRAFFIC
DIVISION OF TRAFFIC ENGINEERING
CITY AND COUNTY OF SAN FRANCISCO

DRAWN:	DATE:	SCALE:
DY	6/06	1:200
CHECKED:	DATE:	SHEET OF SHEETS
		OF

TRAFFIC SIGNAL INVENTORY DIAGRAM

TRAFFIC SIGNAL PLAN
3RD ST AND BANCROFT AVE INTERSECTION

CNN NO.	20517000
REV. NO.	2