




POLE AND EQUIPMENT SCHEDULE											
POLE No.	TYPE OF POLE	LUMINAIRE TYPE	VEHICLE SIGNAL					PEDESTRIAN SIGNAL			REMARKS
			No.	TYPE	MOUNTING	VISORS	LOUVERS/BP	No.	TYPE	MOUNTING	
①	MUNI W/25' MA & ORNAMENTAL LUMINAIRE		21 24 54 819 TC	3S12" 3S12" 3S12"LA 2S8" IS 16"X16"	SV-1-T MAS MAS SV-1 MAS	T T T T	BP BP	28	1S-COUNT	SP-1	APS-2W VIDEO DETECTOR
②	STEEL SL		42 85	3S12" 3S12"	SV-2-TA	T T		89	1S-COUNT	SP-1	APS-2W VIDEO DETECTOR
③	16-2-80		41	3S12"	SV-1-T	T		48	1S-COUNT	SP-1	APS-2W
④	MUNI W/ ORNAMENTAL LUMINAIRE		12 25	3S12"LA 3S12"	SV-2-T	T T		29	1S-COUNT	SP-1	APS-2W
⑤	1-A (12')		LRV2B LRV6A	2S12"LB- 2S12"LB-	TV-2-T	T T					
⑥	PPB POLE										APS-2W
⑦	MUNI W/25' MA & ORNAMENTAL LUMINAIRE		14 61 64 419 TC	3S12"LA 3S12" 3S12"LA 2S8" IS 16"X16"	MAS SV-1-T MAS SV-1 MAS	T T T T	BP BP	68	1S-COUNT	SP-1	APS-2W VIDEO DETECTOR
⑧	STEEL SL		45	3S8"	SV-1-T	T		49	1S-COUNT	SP-1	APS-2W
⑨	16-2-80 W/ 12' MA		81 84	3S12"PV 3S12"PV	SV-1-T MAS	C C	BP	88	1S-COUNT	SP-1	APS-2W VIDEO DETECTOR
⑩	MUNI W/ ORNAMENTAL LUMINAIRE		52 65	3S12"LA 3S8"	SV-2-T	T T		69	1S-COUNT	SP-1	APS-2W
⑪	1-A (12')		LRV2A LRV6B	2S12"LB- 2S12"LB-	TV-2-T	T T					
⑫	PPB POLE										APS-2W

TABLE OF REVISIONS		CHECK WITH TRACING TO SEE IF YOU HAVE LATEST REVISION	
NO.	DATE	DESCRIPTION	BY APP.
3	5/26/21	REMOVE SIGNAL 44 & POLE 2 MA, INSTALL 12" SIGNAL 42 & 85 PER SRC 2021-116; PER FIELD CHANGES	Wakayoshi Gdelon
2	2/16/14	SRC 2014-019: DELETE SIGNAL #13 & 53, INSTALL LUNAR BARS	BW CW
1	6/9/05	TRAFFIC SIGNAL UPGRADE FOR THIRD STREET LIGHT RAIL	DY AH

REFERENCE INFORMATION & FILE NO. OF SURVEYS

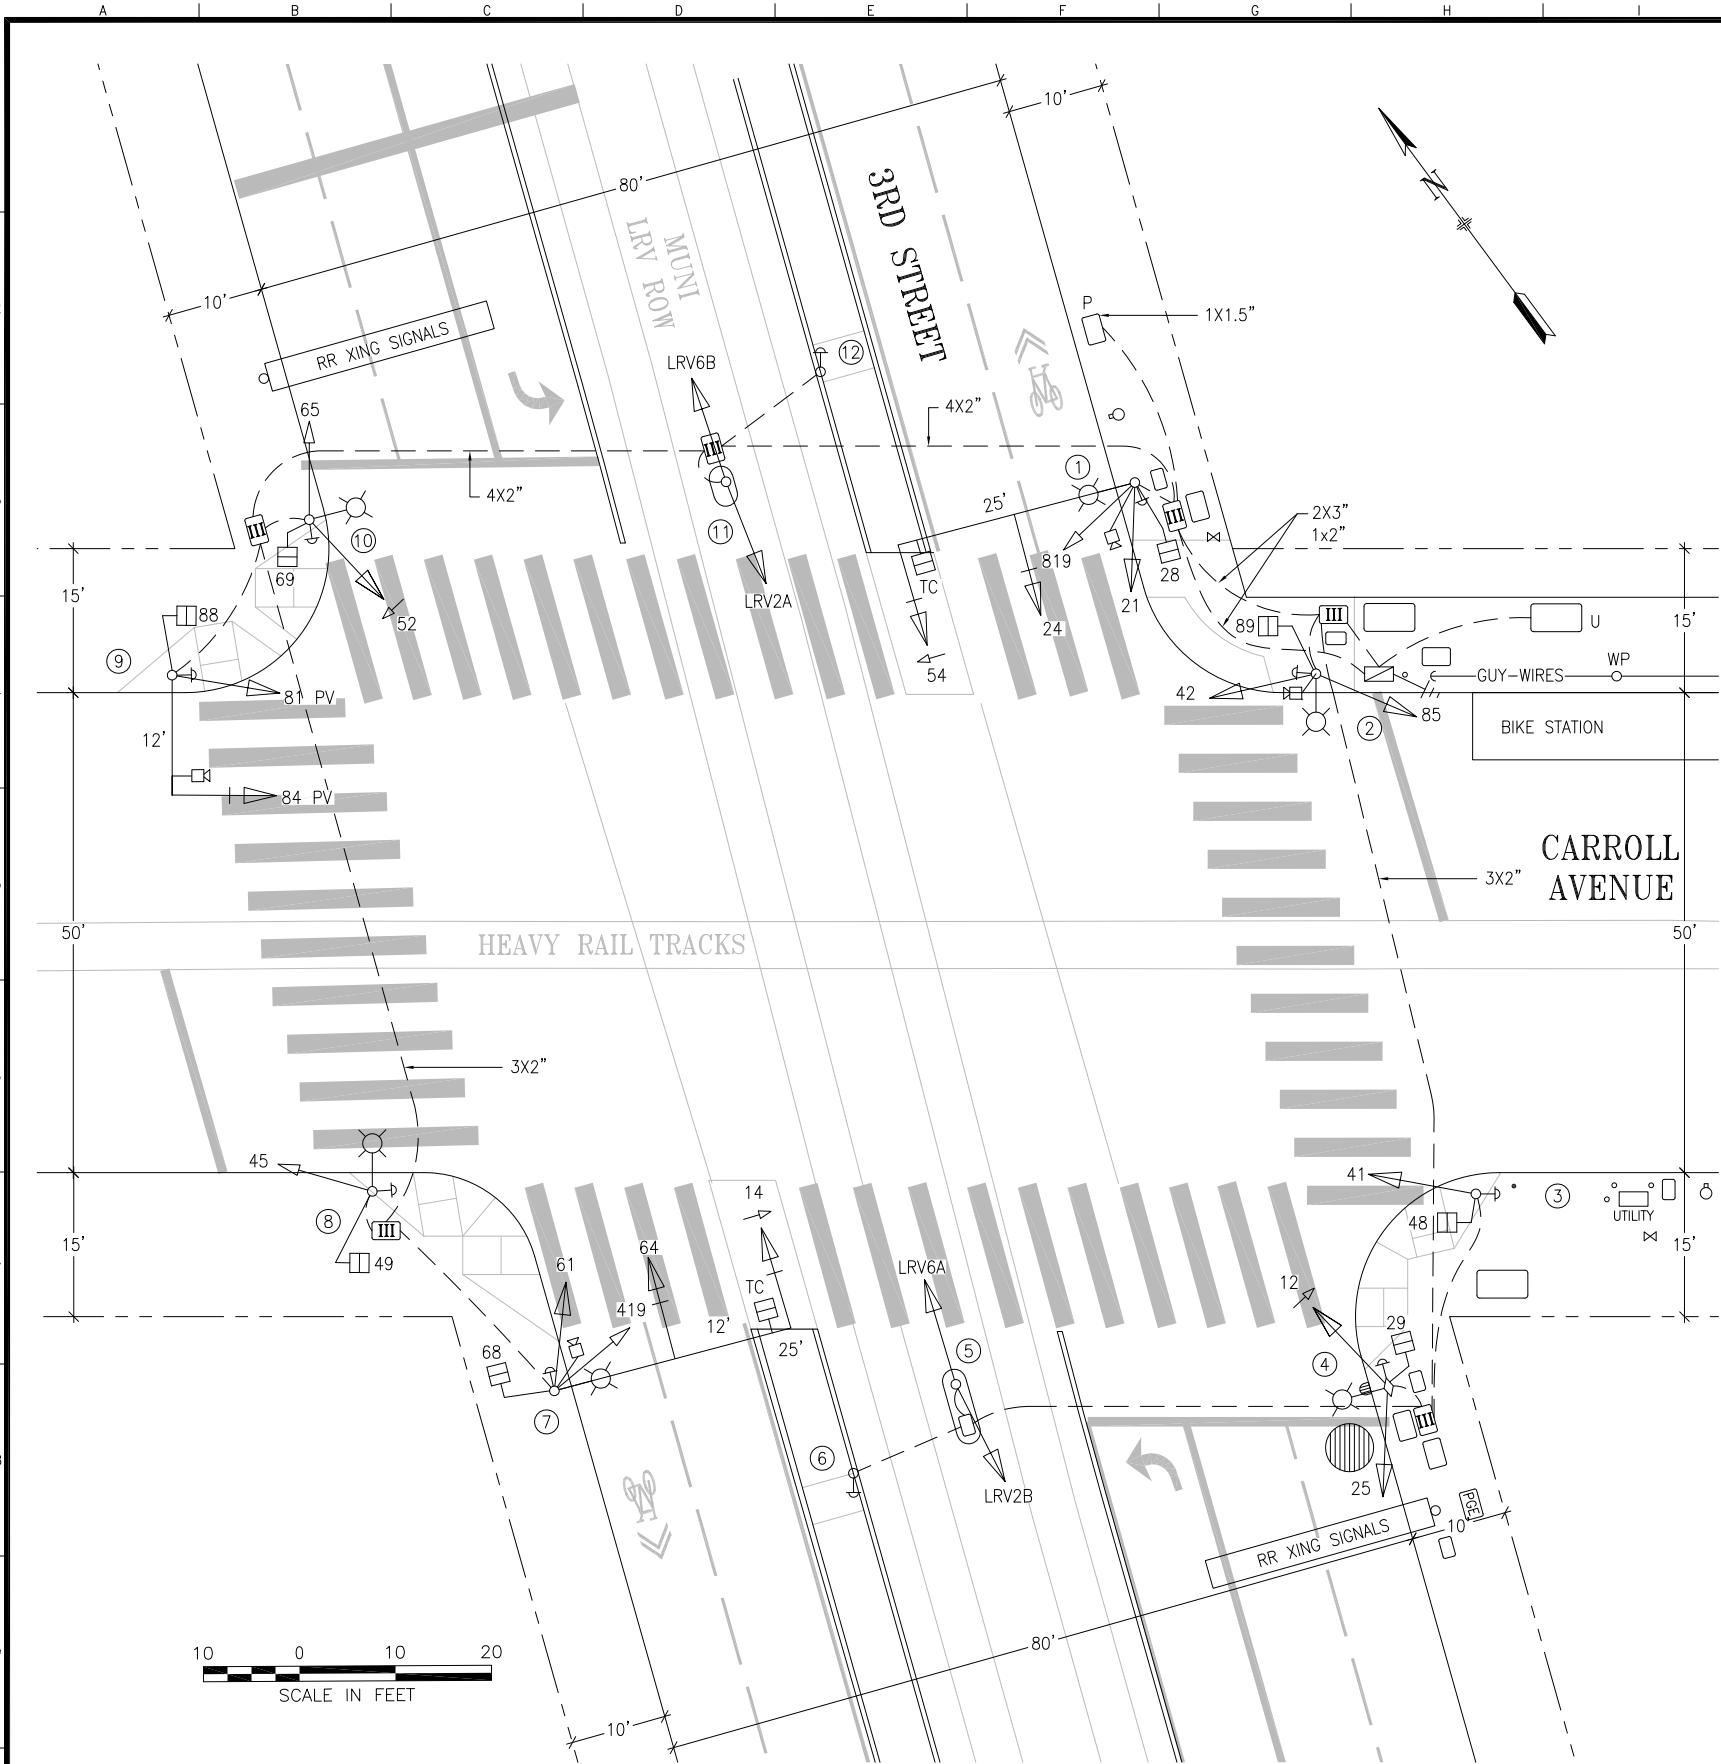

SAN FRANCISCO MUNICIPAL TRANSPORTATION AGENCY
CITY AND COUNTY OF SAN FRANCISCO

DRAWN:	DATE:
DY	6/06
CHECKED:	DATE:

SCALE:
AS SHOWN
SHEET OF SHEETS
XX OF XX

TRAFFIC SIGNAL INVENTORY DIAGRAM
TRAFFIC SIGNAL PLAN 3RD STREET & CARROLL AVENUE INTERSECTION

CNN NO.
20489000
REV NO.
3