


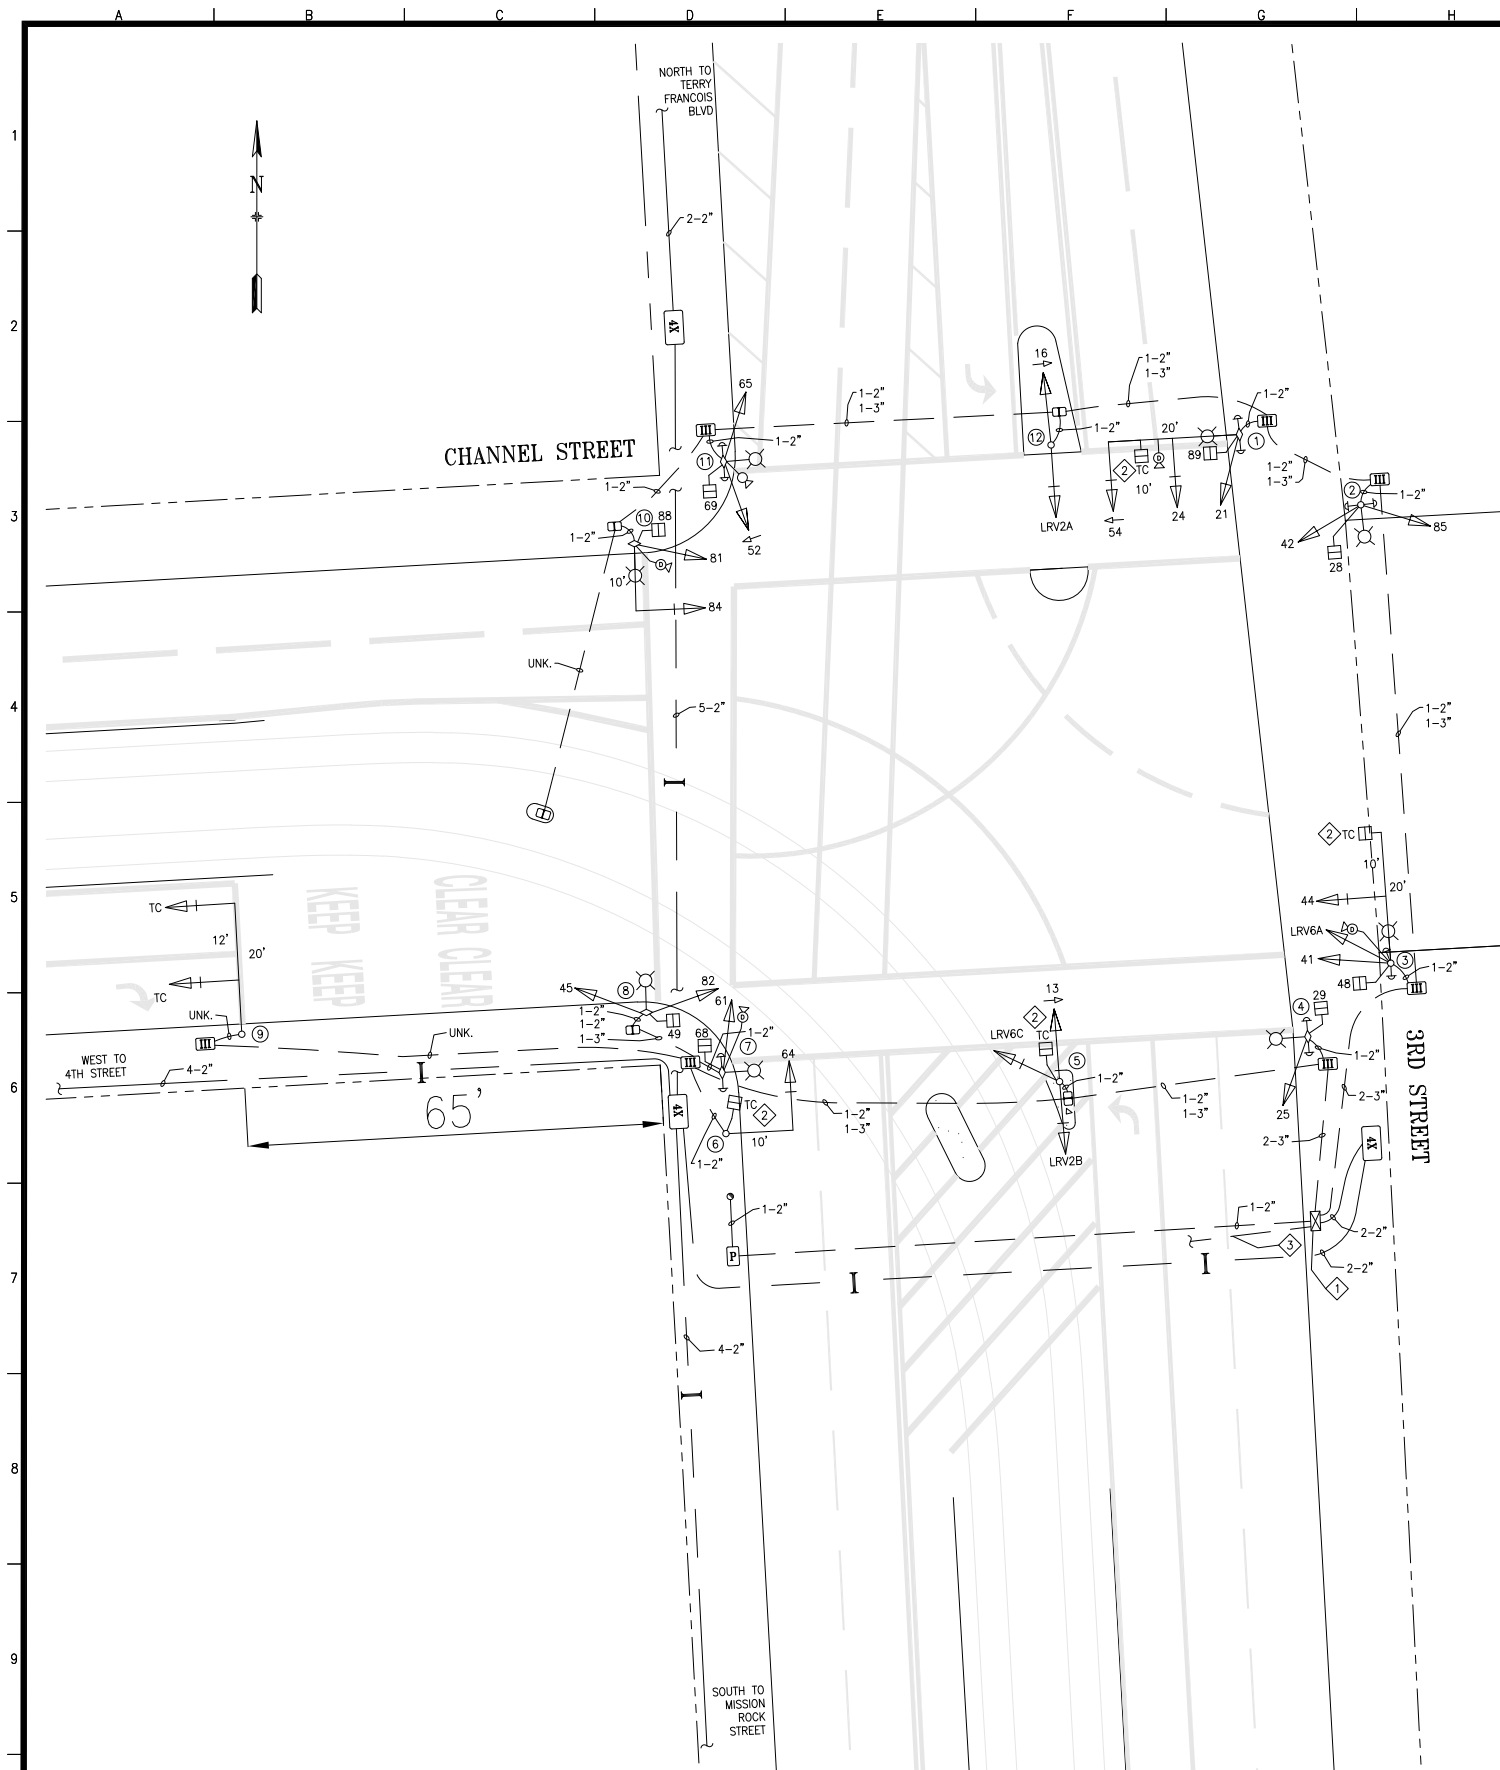

POLE AND EQUIPMENT SCHEDULE											
POLE No.	TYPE OF POLE	LUMINAIRE TYPE	VEHICLE SIGNAL					PEDESTRIAN SIGNAL			REMARKS
			No.	TYPE	MOUNTING	VISORS	LOUVERS/BP	No.	TYPE	MOUNTING	
①	MUNI COMBO POLE W/20' MAST ARM		21 24 54 TC	3S12" 3S12" 3S12"LA 1S 24"x24"	SV-1-T MAS MAS MAC	T T T T	BP BP	89	1S-COUNT	SP-1-T	PPB (2) DETECTION CAMERA
②	MISSION BAY POLE		42 85	3S12" 3S12"	SV-2-T	T T		28	1S-COUNT	SP-1-T	PPB (2)
③	MISSION BAY POLE W/20' MAST ARM		41 44 LRV6A TC	3S12" 3S12" 2S12"LB 1S 24"x24"	SV-1-T MAS SV-1 MAC	T T T T	BP	48	1S-COUNT	SP-1-T	PPB (2) DETECTION CAMERA
④	MUNI COMBO POLE		25	3S12"	SV-1-T	T		29	1S-COUNT	SP-1-T	PPB (2)
⑤	1-A (12')		13 LRV2B LRV6C TC	3S12"LA 2S12"LB 2S12"LB 1S 24"x24"	SV-1-T TV-2-T SV-1	T T T T	BP BP				
⑥	16-2-80 W/10' MAST ARM		64 TC	3S12" 1S 24"x24"	MAS SV-1	T	BP				
⑦	MUNI COMBO POLE		61	3S12"	SV-1-T	T		68	1S-COUNT	SP-1-T	PPB (2) DETECTION CAMERA
⑧	MUNI COMBO POLE		45 82	3S12" 3S12"	TV-2-T	T T		49	1S-COUNT	SP-1-T	
⑨	MISSION BAY POLE W/20' MAST ARM		TC TC	1S12"FR 1S12"FR	MAT MAT	T T	BP BP				
⑩	MUNI COMBO POLE W/10' MAST ARM		81 84	3S12" 3S12"	SV-1-T MAS	T T	BP	88	1S-COUNT	SP-1-T	DETECTION CAMERA
⑪	MUNI COMBO POLE		52 65	3S12"LA 3S12"	SV-2-T	T T		69	1S-COUNT	SP-1-T	PPB (2) CCTV CAMERA
⑫	1-A (10')		16 LRV2A	3S12"LA 2S12"LB	SV-1-T TV-1-T	T T	BP				

- SHEET NOTES:**
- ① CABINET FOUNDATION TYPE: M-SF
 - ② TC = TRAIN COMING
 - ③ TO VTS LOOPS - SEE CONTRACT MR-1147, SHEET EL-06 FOR FURTHER DETAILS

Δ	5/12/22	SRC 2021-171: INSTALLED 24"x24" FTCs ON POLES 1, 3, 5 & 6; REMOVED PPBs FROM POLES 8 & 10 PER FIELD	T. YOUNG	C. LIU
Δ	3/28/18	CHANGED CNN NUMBER; PED SGNL 28 MOVED TO POLE 2 & 89 TO POLE 1 PER FIELD	J. HORNPOSTEL	G. DE LEON
Δ	5/26/14	SRC 2014-065: DELETE SIGNAL 53, INSTALL LUNAR BARS	B. WOO	C. WONG
Δ	12/13/05	TRAFFIC SIGNAL UPGRADE FOR THIRD STREET LIGHT RAIL CT#MR-1141	D. YEUNG	A. HERCE
NO.	DATE	DESCRIPTION	BY	APPROVED
TABLE OF REVISIONS CHECKOUT DRAWING THROUGH THE SID CUSTODIAN FOR THE LATEST REVISION				



SFMTA

DRAWN BY: T. YOUNG	DATE: 6/2022
CHECKED BY: M. VELASCO	DATE: 6/2022

SCALE 1" = 15'
SHEET OF SHEETS 1 OF 1

TRAFFIC SIGNAL INVENTORY DIAGRAM
3RD STREET & CHANNEL STREET

CNN NO: 34155000
REV NO: 4