


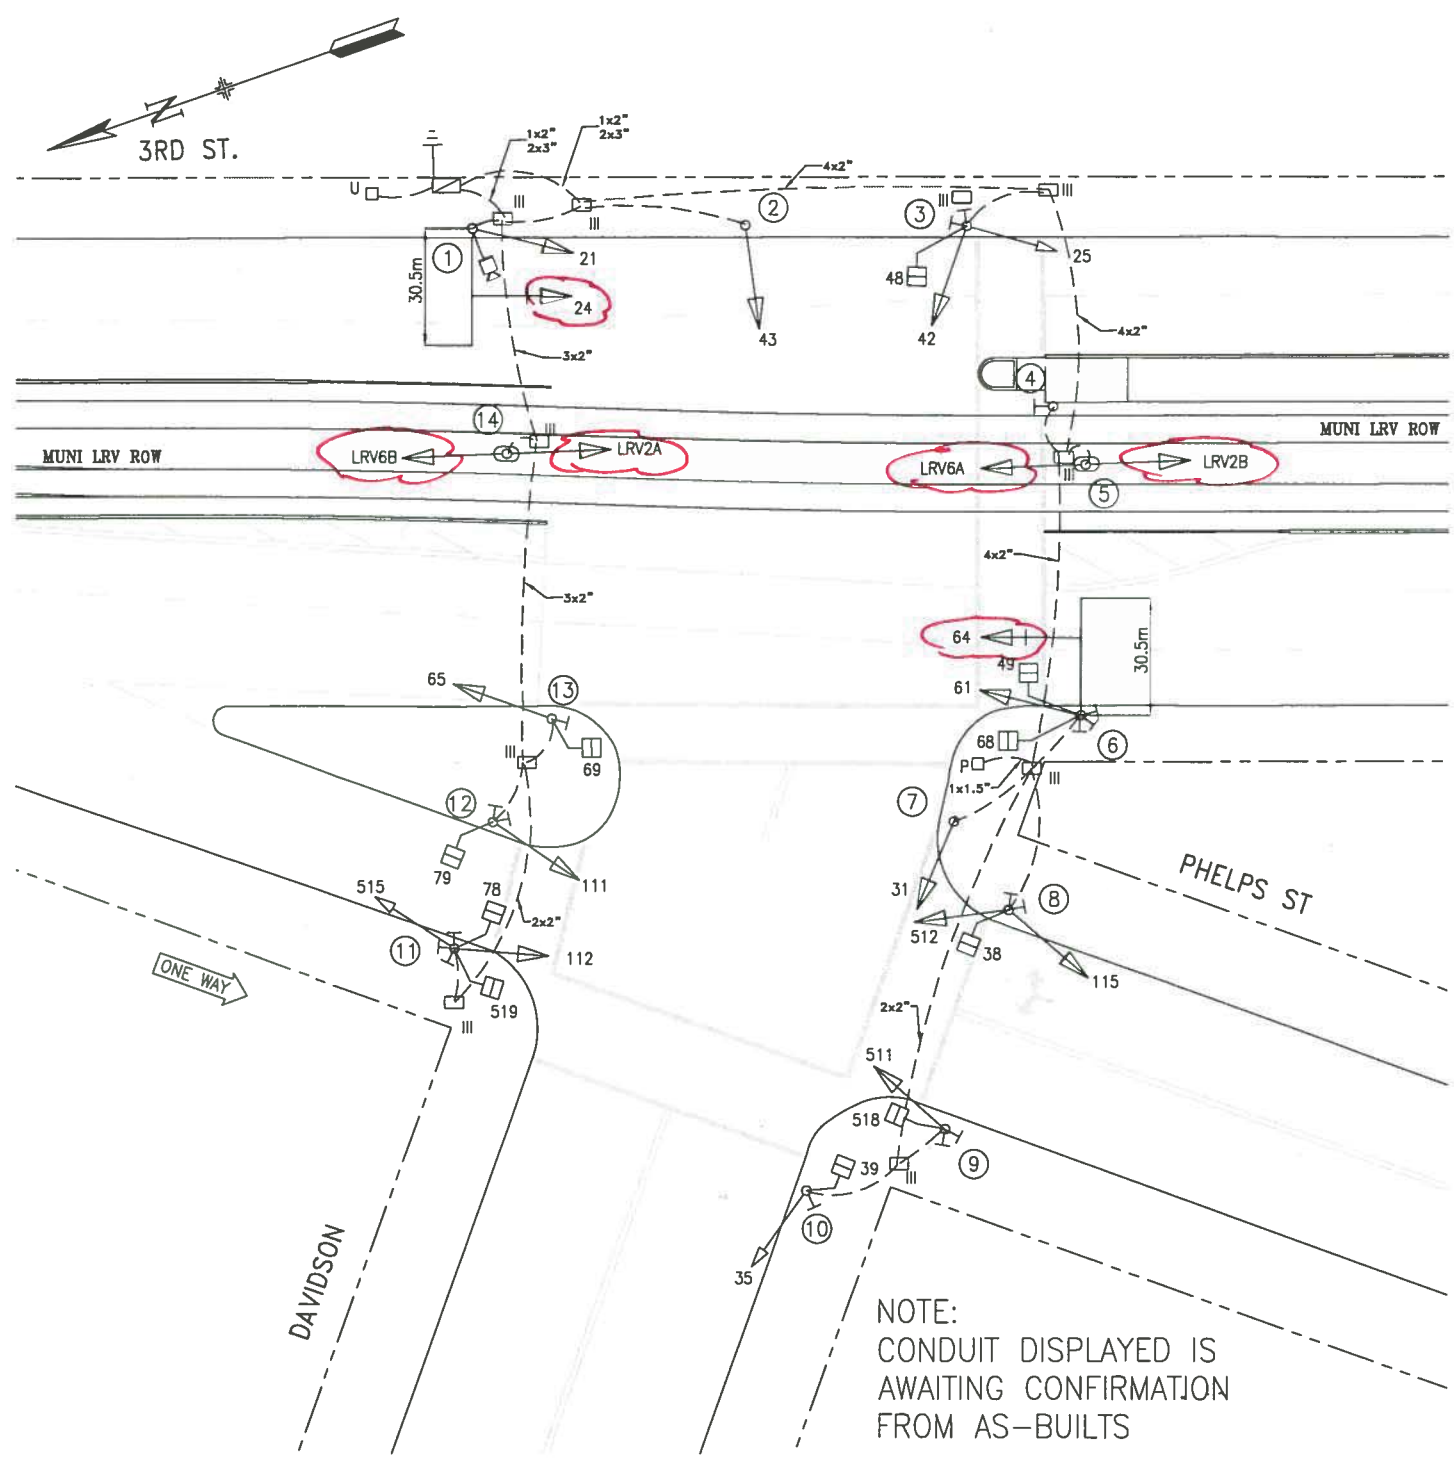

NOTE:
CABINET FOUNDATION TYPE: M-SF

POLE AND EQUIPMENT SCHEDULE									
POLE No.	TYPE OF POLE	LUMINAIRE (HPS)	VEHICLE SIGNAL			PEDESTRIAN SIGNAL			REMARKS
		VOLTAGE/ WATTS	No.	TYPE	MOUNTING (F/I)	No.	TYPE	MOUNTING (F/I)	
①	MUNI COMBO POLE WITH 6.1m M.A.		21 24	3S12" 3S12" GVA	SV-1-T MAS				CAMERA MUNI POLE #3605 DETAIL 'D'; T-10
②	TYPE 1-A (3.05m)		43	3S12"	TV-1				
③	MUNI COMBO POLE		25 42	3S8" 3S12"	SV-2-T	48	1S-LED	SP-1	PPB (2) MUNI POLE #3701
④	PPB POST (TYPE 1-A 1.2m)								PPB W/SIGN (←→) SEE PL DWG. FOR LOCATION
⑤	TYPE 1-A (3.6m) 2S12" LB-1		LRV2B LRV6A	2S12" T 2S12" T	TV-2-T				
⑥	MUNI COMBO POLE WITH 6.1m M.A.		64 61	3S12" 3S12" GVA	MAS SV-1-T	68 49	1S-LED 1S-LED	SP-2-T-SF	PPB (3) MUNI POLE #3700 DETAIL 'D'; T-10
⑦	TYPE 1-A (3.05m)		31	3S12"	TV-1				
⑧	TYPE 1-A (3.05m)		512 115	3S12" 3S12" R,Y,Y	TV-2-T	38	1S-LED	SP-1	PPB (2)
⑨	TYPE 1-A (3.05m)		511	3S12"	TV-1	518	1S-LED	SP-1	PPB (2)
⑩	TYPE 1-A (3.05m)		35	3S8"	TV-1	39	1S-LED	SP-1	PPB (1) OLD POLE AND TEMPORARY FOUNDATION AT TIME OF INSPECTION
⑪	TYPE 1-A (3.05m)		515 112	3S8" 3S12" R,Y,Y	TV-2-T	78 519	1S-LED 1S-LED	SP-2-T-SF	PPB (3)
⑫	TYPE 1-A (3.05m)		111	3S12" R,Y,Y	TV-1-T	79	1S-LED	SP-1	PPB (2)
⑬	TYPE 1-A (3.05m)		65	3S12"	TV-1	69	1S-LED	SP-1	PPB (1)
⑭	TYPE 1-A (3.6m)		LRV2A LRV6B	2S12" T 2S12" T	TV-2-T				

M.A. = MAST ARM

2S12" LB-1

NO.	DATE	DESCRIPTION	BY	APP.
2	3/23/14	RED MARK CHANGES PER SRC 2014-053	BW	CW
1	8/31/05	TRAFFIC SIGNAL UPGRADE FOR THIRD STREET LIGHT RAIL CT#MR-1142	DY	AH
TABLE OF REVISIONS CHECK WITH TRACING TO SEE IF YOU HAVE LATEST REVISION				



DEPARTMENT OF PARKING AND TRAFFIC
DIVISION OF TRAFFIC ENGINEERING
CITY AND COUNTY OF SAN FRANCISCO

COMPLETION DATE /
ELECTRICIAN INITIAL

DRAWN:	DATE:	SCALE:	TRAFFIC SIGNAL INVENTORY DIAGRAM	CNN NO.
DY	7/06	1:200		20244000
CHECKED:	DATE:	SHEET OF SHEETS	3RD AND DAVIDSON/PHELPS STS INTERSECTION	REV. NO.
AH	8/06	1 OF 1		2

FILE NAME: M:\05671.dwg
DATE: 8/31/05
SCALE: 1:200
SHEET: 1 OF 1
CITY AND COUNTY OF SAN FRANCISCO
DEPARTMENT OF PARKING AND TRAFFIC
DIVISION OF TRAFFIC ENGINEERING
TRAFFIC SIGNAL INVENTORY DIAGRAM
3RD AND DAVIDSON/PHELPS STS INTERSECTION
11/20/2007 2:51:33 PM