


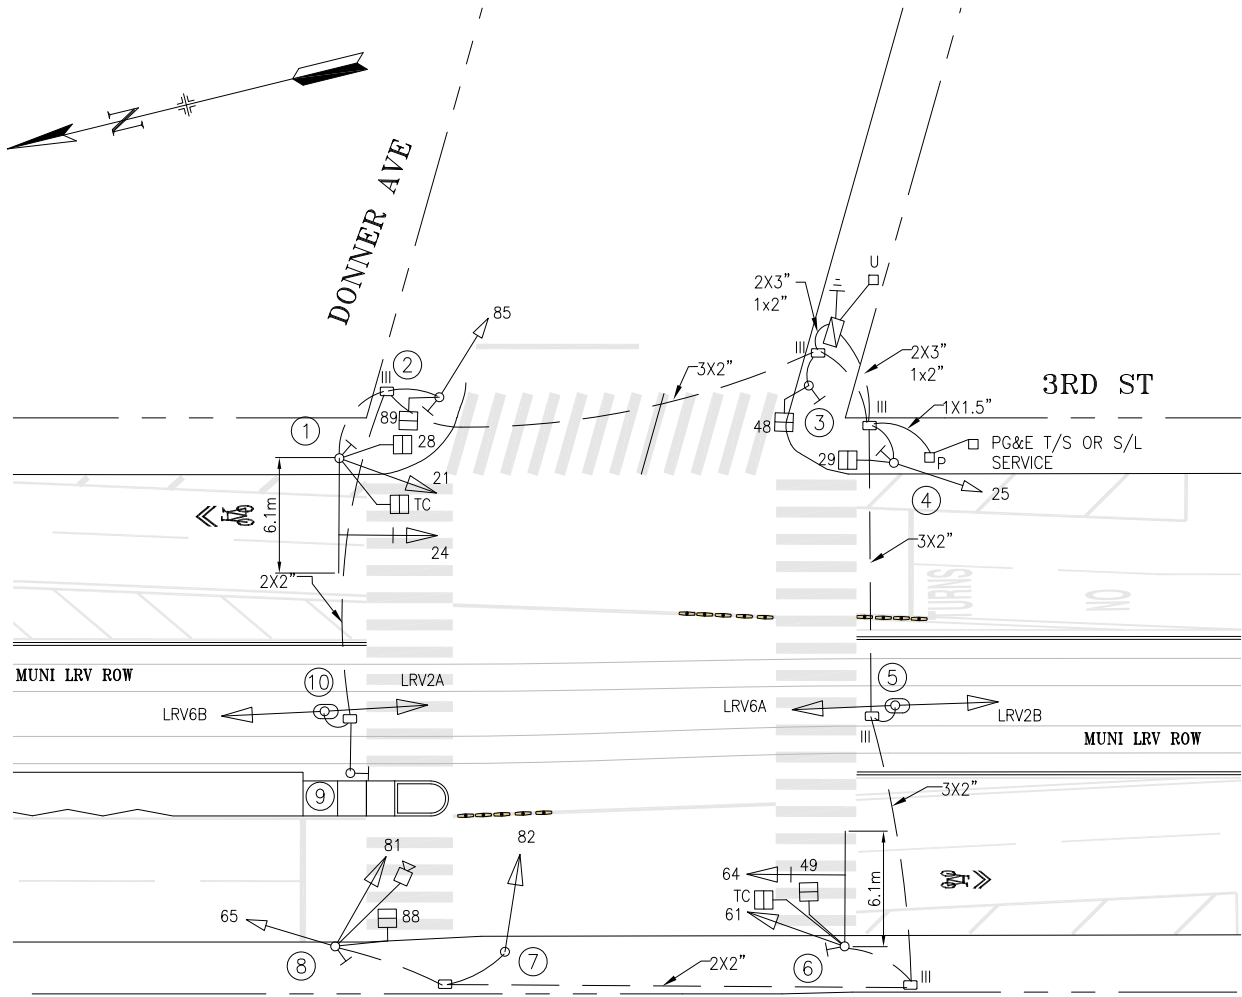


NOTE:
CABINET FOUNDATION TYPE: M-SF

POLE AND EQUIPMENT SCHEDULE

POLE No.	TYPE OF POLE	LUMINAIRE (HPS)	VEHICLE SIGNAL			PEDESTRIAN SIGNAL			REMARKS
		VOLTAGE/WATTS	No.	TYPE	MOUNTING (F/I)	No.	TYPE	MOUNTING (F/I)	
①	MUNI COMBO POLE WITH 6.1m M.A.		24 21 TC	3S12" GVA 3S12" 1S 24"x24"	MAS SV-1-T SV-1	28	1S-LED	SP-1	APS DETAIL 'D'; T-22
②	TYPE 1-A (3.05m)		85	3S8"	TV-1	89	1S-LED	SP-1	APS
③	STREET LIGHT					48	1S-LED	TP-1	APS
④	MUNI POLE		25	3S8"	SV-1-T	29	1S-LED	SP-1	APS
⑤	TYPE 1-A (3.6m)		LRV2B LRV6A	2S12" LB- 2S12" LB-	TV-2-T				
⑥	MUNI COMBO POLE WITH 6.1m M.A.		61 64 TC	3S12" 3S12" GVA 1S 24"x24"	SV-1-T MAS SV-1	49	1S-LED	SP-1	APS DETAIL 'D'; T-22
⑦	TYPE 1-A (3.05m)		82	3S12"	TV-1-T				
⑧	MUNI COMBO POLE		65 81	3S8" 3S12"	SV-2-T	88	1S-LED	SP-1	APS
⑨	PPB POST								APS W/ SIGNS (↔) POLE LOCATION, REFER TO ST DRAWINGS
⑩	TYPE 1-A (3.6m)		LRV2A LRV6B	2S12" LB- 2S12" LB-	TV-2-T				

M.A. = MAST ARM

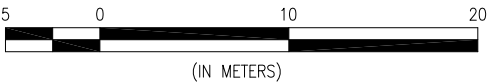

NO.	DATE	DESCRIPTION	BY	APP.
3	1/20/20	SRC 2019-316: INSTALLED FTC SIGNS ON POLES 1 & 6 AND UPDATED PER FIELD CONDITIONS	CXL	MV
2	1/26/14	SRC 2014-019: REPLACE MUNI RED T/WHITE T SIGNALS WITH LUNAR BARS. INSTALL GVA FOR SIGNALS 24/64.	BW	CW
1	2/3/05	TRAFFIC SIGNAL UPGRADE FOR THIRD STREET LIGHT RAIL	DY	AH
TABLE OF REVISIONS CHECK WITH TRACING TO SEE IF YOU HAVE LATEST REVISION				

COMPLETION DATE /
ELECTRICIAN INITIAL



DEPARTMENT OF PARKING AND TRAFFIC
DIVISION OF TRAFFIC ENGINEERING
CITY AND COUNTY OF SAN FRANCISCO

DRAWN: DY	DATE: 6/06	SCALE: 1:200	TRAFFIC SIGNAL INVENTORY DIAGRAM	CNN NO. 20515000
CHECKED:	DATE:	SHEET OF SHEETS OF	TRAFFIC SIGNAL PLAN 3RD ST AND DONNER AVE INTERSECTION	REV. NO. 3