



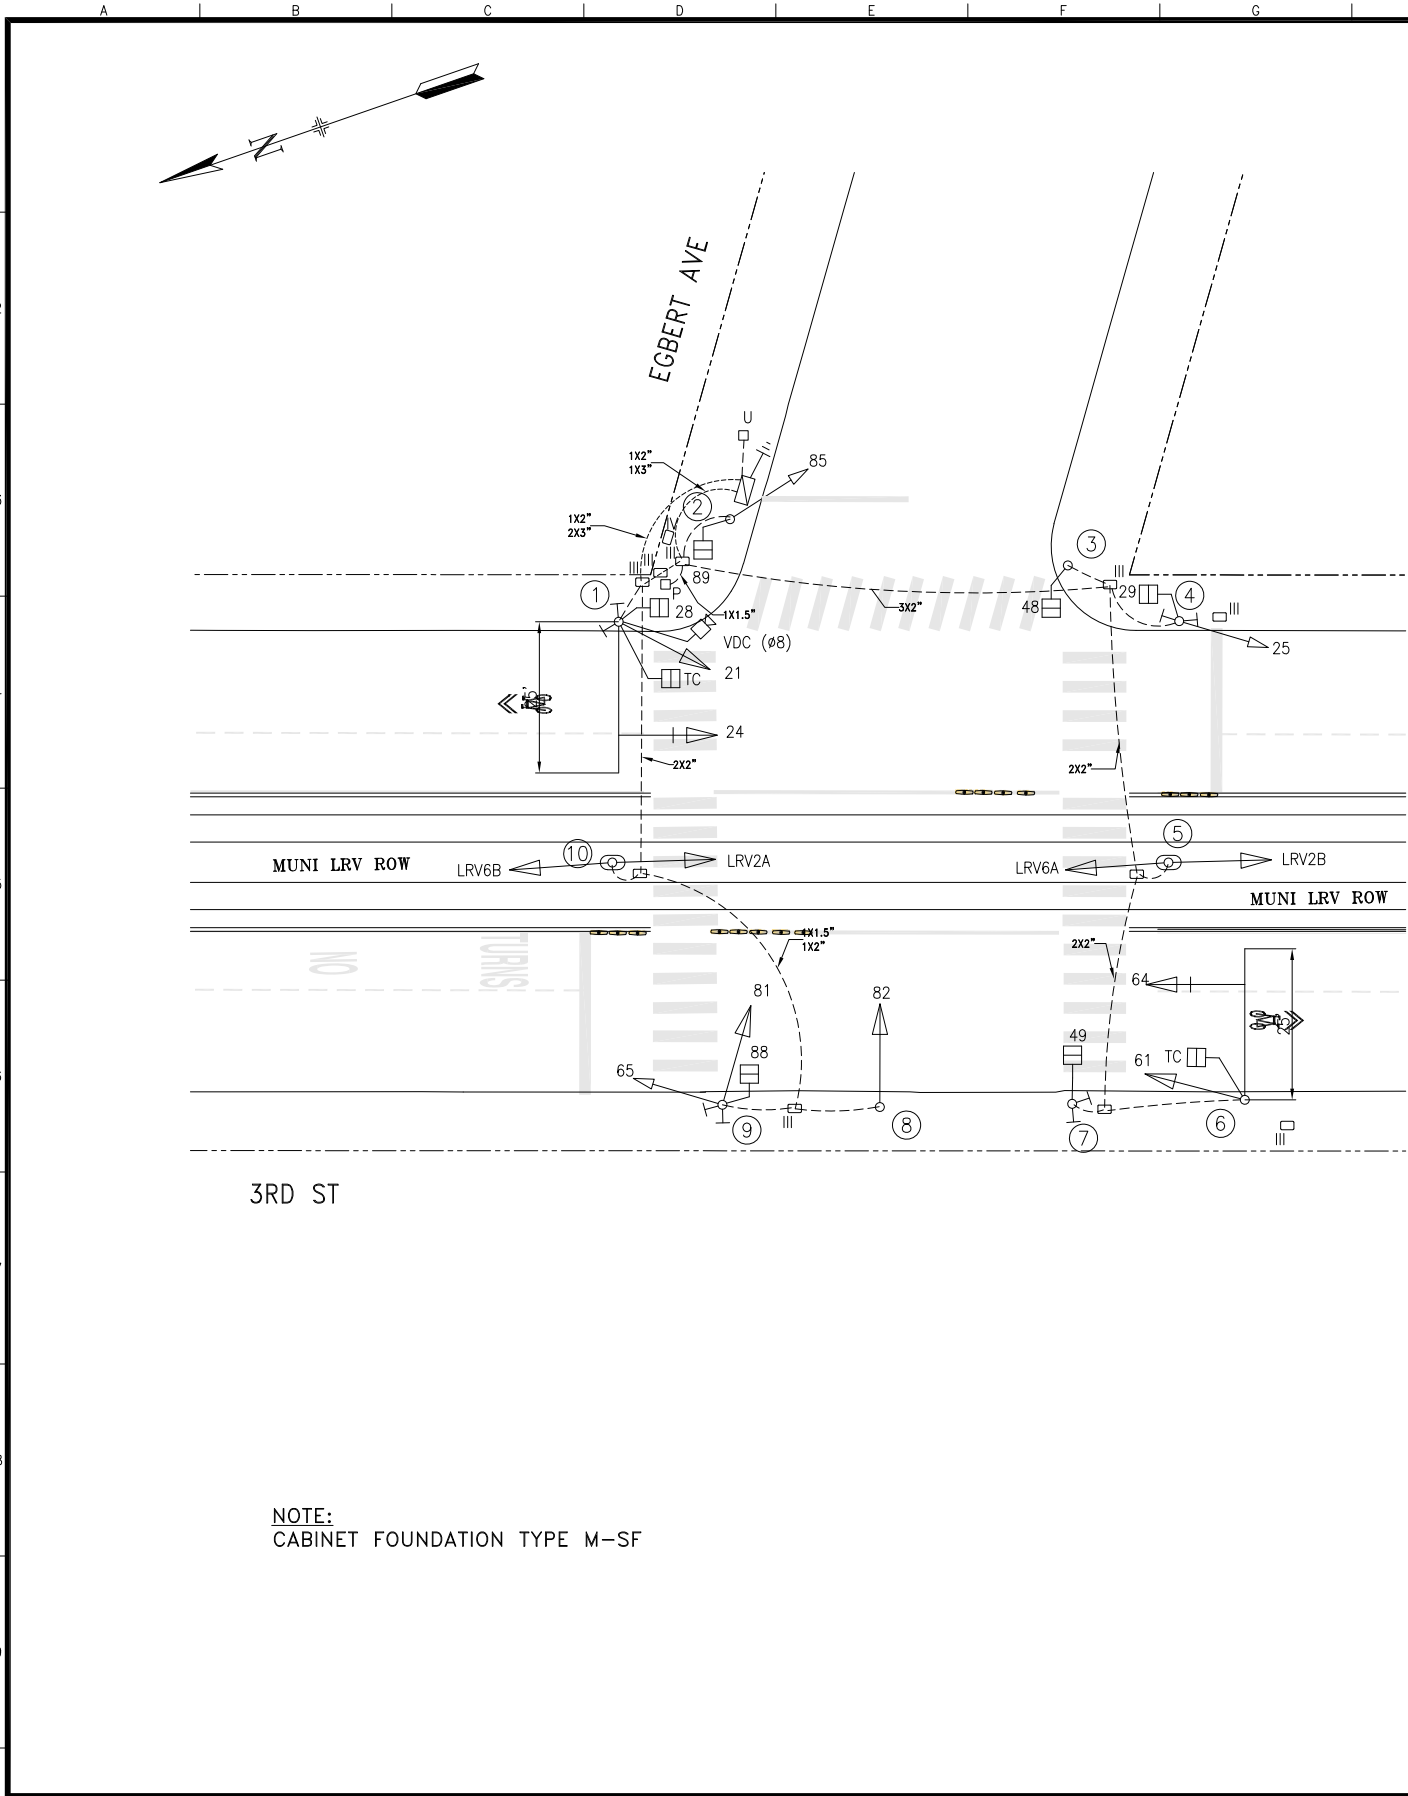

POLE AND EQUIPMENT SCHEDULE									
POLE No.	TYPE OF POLE	LUMINAIRE (HPS)	VEHICLE SIGNAL			PEDESTRIAN SIGNAL			REMARKS
		VOLTAGE/ WATTS	No.	TYPE	MOUNTING (F/I)	No.	TYPE	MOUNTING (F/I)	
①	MUNI COMBO POLE WITH 25' M.A.		21 24 TC	3S12" 3S12" GVA 1S 24"x24"	SV-1-T MAS SV-1	28	1S-C	SP-1	PPB PPB VDC (Ø8 WB EGBERT)
②	TYPE 1-A (10')		85	3S8"	TV-1	89	1S-C	SP-1	
③	TYPE 1-A (7')					48	1S-C	TP-1	
④	MUNI COMBO POLE		25	3S8"	SV-1-T	29	1S-C	SP-1	PPB PPB
⑤	TYPE 1-A (12')		LRV2B LRV6A	2S12" LB- 2S12" LB-	TV-2-T				
⑥	MUNI COMBO POLE WITH 25' M.A.		64 61 TC	3S12" GVA 3S12" 1S 24"x24"	MAS SV-1-T SV-1				
⑦	TYPE 1-A (7')					49	1S-C	TP-1	PPB PPB
⑧	TYPE 1-A (10')		82	3S12"	TV-1				
⑨	TYPE 1-A (10')		65 81	3S8" 3S12"	TV-2-T	88	1S-C	SP-1	PPB PPB
⑩	TYPE 1-A (12')		LRV2A LRV6B	2S12" LB- 2S12" LB-	TV-2-T				

M.A. = MAST ARM

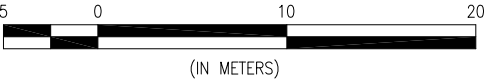

3	1/19/20	SRC 2019-316: INSTALLED FTC SIGNS ON POLES 1 & 6 AND UPDATED PER FIELD CONDITIONS	CXL	MV	
2	1/26/14	SRC 2014-019: REPLACE MUNI RED T/WHITE T SIGNALS WITH LUNAR BARS. INSTALL GVA FOR SIGNALS 24/64.	BW	CW	
1	6/14/10	PER FIELD CHECK	DC	CH	
0	11/29/04	3RD STREET LIGHT RAIL PROJECT - SEGMENT E CONTRACT NO. MR-1144			
NO.	DATE	DESCRIPTION	BY	APP.	

TABLE OF REVISIONS	
CHECK WITH TRACING TO SEE IF YOU HAVE LATEST REVISION	

DEPARTMENT OF PARKING AND TRAFFIC

DIVISION OF TRAFFIC ENGINEERING

CITY AND COUNTY OF SAN FRANCISCO

DRAWN: KK/DY	DATE: 12/05	SCALE: 1:200
CHECKED:	DATE:	SHEET OF SHEETS

TRAFFIC SIGNAL INVENTORY DIAGRAM	CNN NO. 20457000
3RD ST AND EGBERT AVE INTERSECTION	REV. NO. 3

Drawing Path: F:\I-E-FILES\SFproj\Projects\FTC\SD\Group 2\03rd St_Egbert_2020-01-19_SD.dwg, Login: Young, Plot Time: Tue, 27 Apr 2021 - 5:28pm
TB34X22 [.\..\..\Special Projects & Street Use\Design Stds\Miscellaneous Details\Signal Inventory Diagram Title Block.dwg]
Model Units: Undefined
Measurement Units are English
Dimension Scale: 1
Plot Time: Tue, 27 Apr 2021 - 5:28pm