


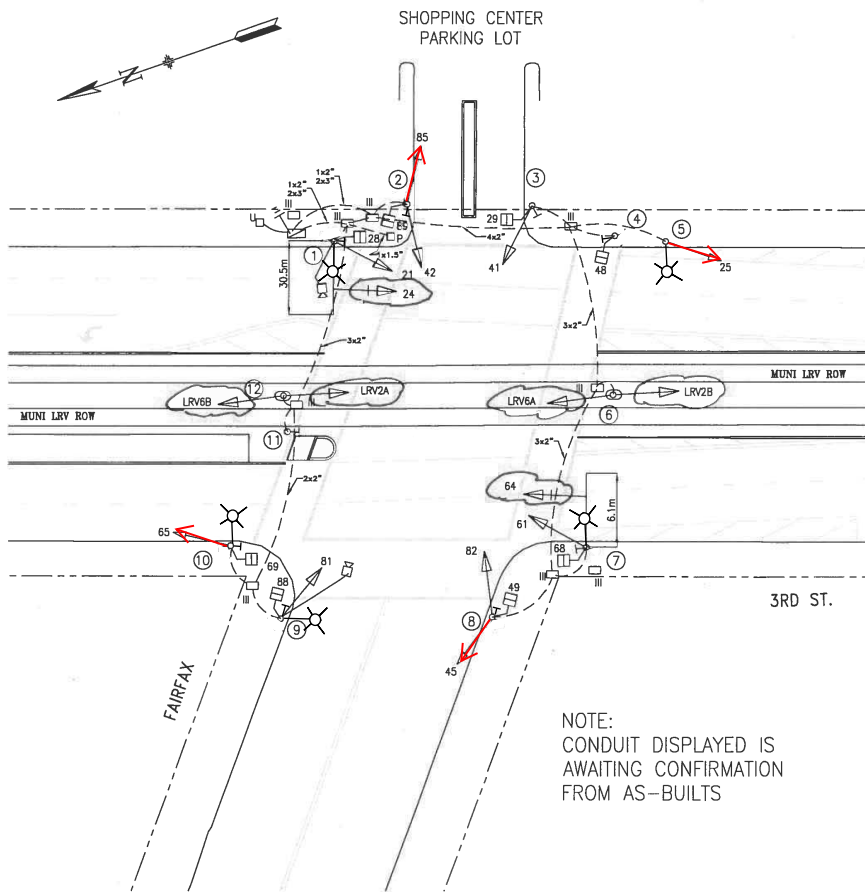

NOTE:
CABINET FOUNDATION TYPE: M-SF

NOTE:
CONDUIT DISPLAYED IS
AWAITING CONFIRMATION
FROM AS-BUILTS

POLE AND EQUIPMENT SCHEDULE

POLE No.	TYPE OF POLE	LUMINAIRE (HPS) VOLTAGE/ WATTS	VEHICLE SIGNAL			PEDESTRIAN SIGNAL			REMARKS
			No.	TYPE	MOUNTING (F/I)	No.	TYPE	MOUNTING (F/I)	
①	MUNI COMBO POLE WITH 6.1m M.A.		21 24	3S12" 3S12" <i>GVA</i>	SV-1-T MAS	28	1S-LED	SP-1	PPB CAMERA MUNI POLE #3831 DETAIL 'D'; T-10
②	TYPE 1-A (3.05m)		42 85	3S12" 3S12"	TV-2-T	89	1S-LED	SP-1	PPB
③	TYPE 1-A (3.05m)		41	3S12"	TV-1	29	1S-LED	SP-1	PPB
④	TYPE 1-A (2.13m)					48	1S-LED	TP-1	PPB
⑤	MUNI COMBO POLE		25	3S12"	SV-1-T				MUN POLE #3911
⑥	TYPE 1-A (3.6m) <i>2512" LB-1</i>		LRV2B LRV6A	<i>2512" LB-1</i> <i>2512" LB-1</i>	TV-2-T				
⑦	MUNI COMBO POLE WITH 6.1m M.A.		64 61	3S12" 3S12" <i>GVA</i>	MAS SV-1-T	68	1S-LED	SP-1	PPB MUNI POLE #3900 DETAIL 'D'; T-10
⑧	TYPE 1-A (3.05m)		82 45	3S12" 3S12"	TV-2-T	49	1S-LED	SP-1	PPB
⑨	STREET LIGHT		81	3S12"	SV-1-T	88	1S-LED	SP-1	PPB CAMERA
⑩	MUNI COMBO POLE		65	3S12"	SV-1-T	69	1S-LED	SP-1	PPB MUNI POLE #3830
⑪	PPB POST (TYPE 1-A 1.2m)								PPB WITH SIGN (---) REFER TO PL DWG. FOR LOCATION
⑫	TYPE 1-A (3.6m)		LRV2A LRV6B	<i>2512" LB-1</i> <i>2512" LB-1</i>	TV-2-T				

M.A. = MAST ARM

2512" LB-1

3	10/09/20	Upgrade signals to 3S12" (SRC 2020-189) (Per field: Revised PPB)	E.Lau, C.Gordon
2	3/23/14	RED MARK CHANGES PER SRC 2014-053	BW CW
1	9/14/05	TRAFFIC SIGNAL UPGRADE FOR THIRD STREET LIGHT RAIL CT#MR-1142	DY AH
NO.	DATE	DESCRIPTION	BY APP.

CHECK WITH TRACING TO SEE IF YOU HAVE LATEST REVISION

COMPLETION DATE /
ELECTRICIAN INITIAL



DEPARTMENT OF PARKING AND TRAFFIC
DIVISION OF TRAFFIC ENGINEERING
CITY AND COUNTY OF SAN FRANCISCO

DRAWN: DATE: SCALE:
DY 7/06 1:200
CHECKED: DATE: SHEET OF SHEETS
AH 8/06 1 OF 1

TRAFFIC SIGNAL INVENTORY DIAGRAM
3RD AND FAIRFAX STS INTERSECTION

CNN NO.
20238000
REV. NO.

3

FILE NAME: X:\0551\14g
DATE: 11/20/2007 2:46:03 PM
SCALE: 1:200
ORIGIN: ELECTRICAL
CITY AND COUNTY OF SAN FRANCISCO
TRAFFIC SIGNAL INVENTORY DIAGRAM
3RD AND FAIRFAX STS INTERSECTION
C:\0551\14g