


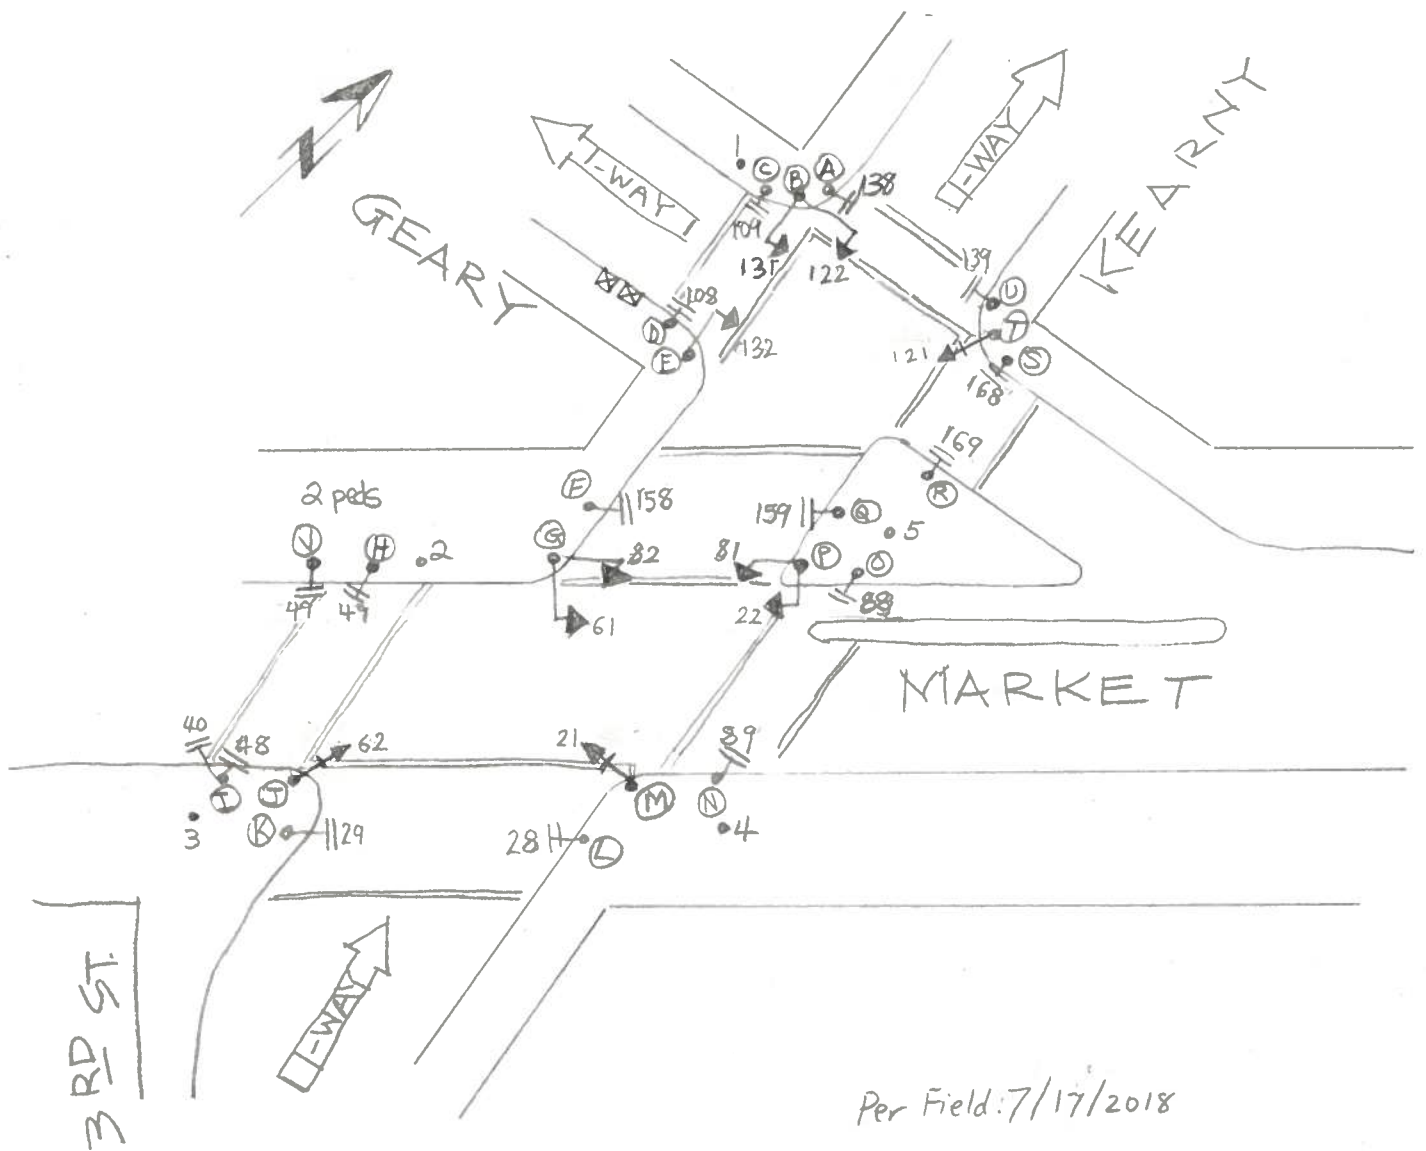

Per Field: 7/17/2018

Changes Per Field:

- Signal 62 on Pole ① removed and replaced with side-mount 3S12"

7-17-18

POLE	FUNC	MATL	SIGNAL NO.	MAKE	NO. OF SECT.	SIZE	VISOR	B.P. or LOUVERS	MOUNT	PED SIGNAL NO.	LEGEND	MESSAGE		MAKE	MOUNT
												ELEMENT	COLOR		
A	S	S	21	—	3	12"	T	BP	S	28	COUNTDOWN	IS-COUNT	W/OR	ICC	T
B	S	S	22	—	3	8"	FC 8"	BP	*	29	COUNTDOWN	IS-COUNT	W/OR	ICC	T
C	S	S	61	—	3	8"	FC 8"	BP	*	48	COUNTDOWN	IS-COUNT	W/OR	ICC	T
D	S	S	62	—	3	12"	T	BP	S	49	COUNTDOWN	IS-COUNT	W/OR	ICC	T
E	S	S	81	—	3	8"	FC 8"	BP	*	88	COUNTDOWN	IS-COUNT	W/OR	ICC	T
F	S	S	82	—	3	8"	FC 8"	BP	*	89	COUNTDOWN	IS-COUNT	W/OR	ICC	T
G	S	S	121	—	3	12"	T	BP	S	108	COUNTDOWN	IS-COUNT	W/OR	ICC	T
H	S	S	122	—	3	8"	FC 8"	BP / G.Y. LOUVER	*	109	COUNTDOWN	IS-COUNT	W/OR	ICC	T
I	S	S	131	—	3	8"	FC 8"	BP	*	138	COUNTDOWN	IS-COUNT	W/OR	ICC	T
J	S	S	132	—	3	8"	FC 8"	BP	*	139	COUNTDOWN	IS-COUNT	W/OR	ICC	T
K	S	S								158	COUNTDOWN	IS-COUNT	W/OR	ICC	T
L	S	S								159	COUNTDOWN	IS-COUNT	W/OR	ICC	T
M	S	S								168	COUNTDOWN	IS-COUNT	W/OR	ICC	T
N	S	S								169	COUNTDOWN	IS-COUNT	W/OR	ICC	T

POLE	FUNC	MATL	SIGNAL NO.	MAKE	NO. OF SECT.	SIZE	VISOR	B.P. or LOUVERS	MOUNT	PED SIGNAL NO.	LEGEND	MESSAGE		MAKE	MOUNT
												ELEMENT	COLOR		
O	S	S								49	COUNTDOWN	IS-COUNT	W/OR	ICC	T
P	S	S								40	COUNTDOWN	IS-COUNT			T
Q	S	S													
R	S	S													
S	S	S													
T	S	S													
U	S	S													
V	S	S													
1	L	O													
2	L	O													
3	L	O													
4	L	O													
5	L	O													

CONTROLLER CABINET SIZE : 1 ORDIN. EAGLE BASE CABINET : 1 - NO

COMMENTS : * MARKET STREET MASTARM SIGNALS

Per Field: Signal 62 upgraded to 3S12" side Mount