




POLE AND EQUIPMENT SCHEDULE									
POLE No.	TYPE OF POLE	LUMINAIRE (HPS)	VEHICLE SIGNAL			PEDESTRIAN SIGNAL			REMARKS
		VOLTAGE/WATTS	No.	TYPE	MOUNTING (F/I)	No.	TYPE	MOUNTING (F/I)	
1	CITY STANDARD SL WITH 6' LUMINAIRE ARM.	120/150	62	3S12"	SV-1-T	29 48	IS-COUNT IS-COUNT	SP-1 SP-1	
2	CITY STANDARD SL WITH 6' LUMINAIRE ARM.	120/150	21 42	3S8" 3S8"	SV-2-TA	28 89	IS-COUNT IS-COUNT	SP-1 SP-1	
3	16-1-70 WITH 8' MAST ARM		81 84	3S12" 3S12"	SV-1-T MAS	69 88	IS-COUNT IS-COUNT	SP-1 SP-1	RLC AUX FLASH BACKPLATE
4	17B-1-70 WITH 20' MAST AND 6' LUMINAIRE ARMS.	120/200	82 87	3S12" 3S12"	SV-1-T MAS				BACKPLATE
5	17B-1-70 WITH 20' MAST AND 6' LUMINAIRE ARMS.	120/150	61 64	3S12" 3S12"	SV-1-T MAS	49 68	IS-COUNT IS-COUNT	SP-1 SP-1	BACKPLATE

1	4/6/16	REMOVED 22 & 41; UPGRADED 61, 62, 81, & 82 TO 12"	JH	MV
0	2/2015	SID CONVERTED FROM 1167N AS-BUILTS; UPDATED PER FIELD	JH	MV
NO.	DATE	DESCRIPTION	BY	APP.
TABLE OF REVISIONS				
CHECK WITH TRACING TO SEE IF YOU HAVE LATEST REVISION				

REFERENCE INFORMATION
& FILE NO. OF SURVEYS

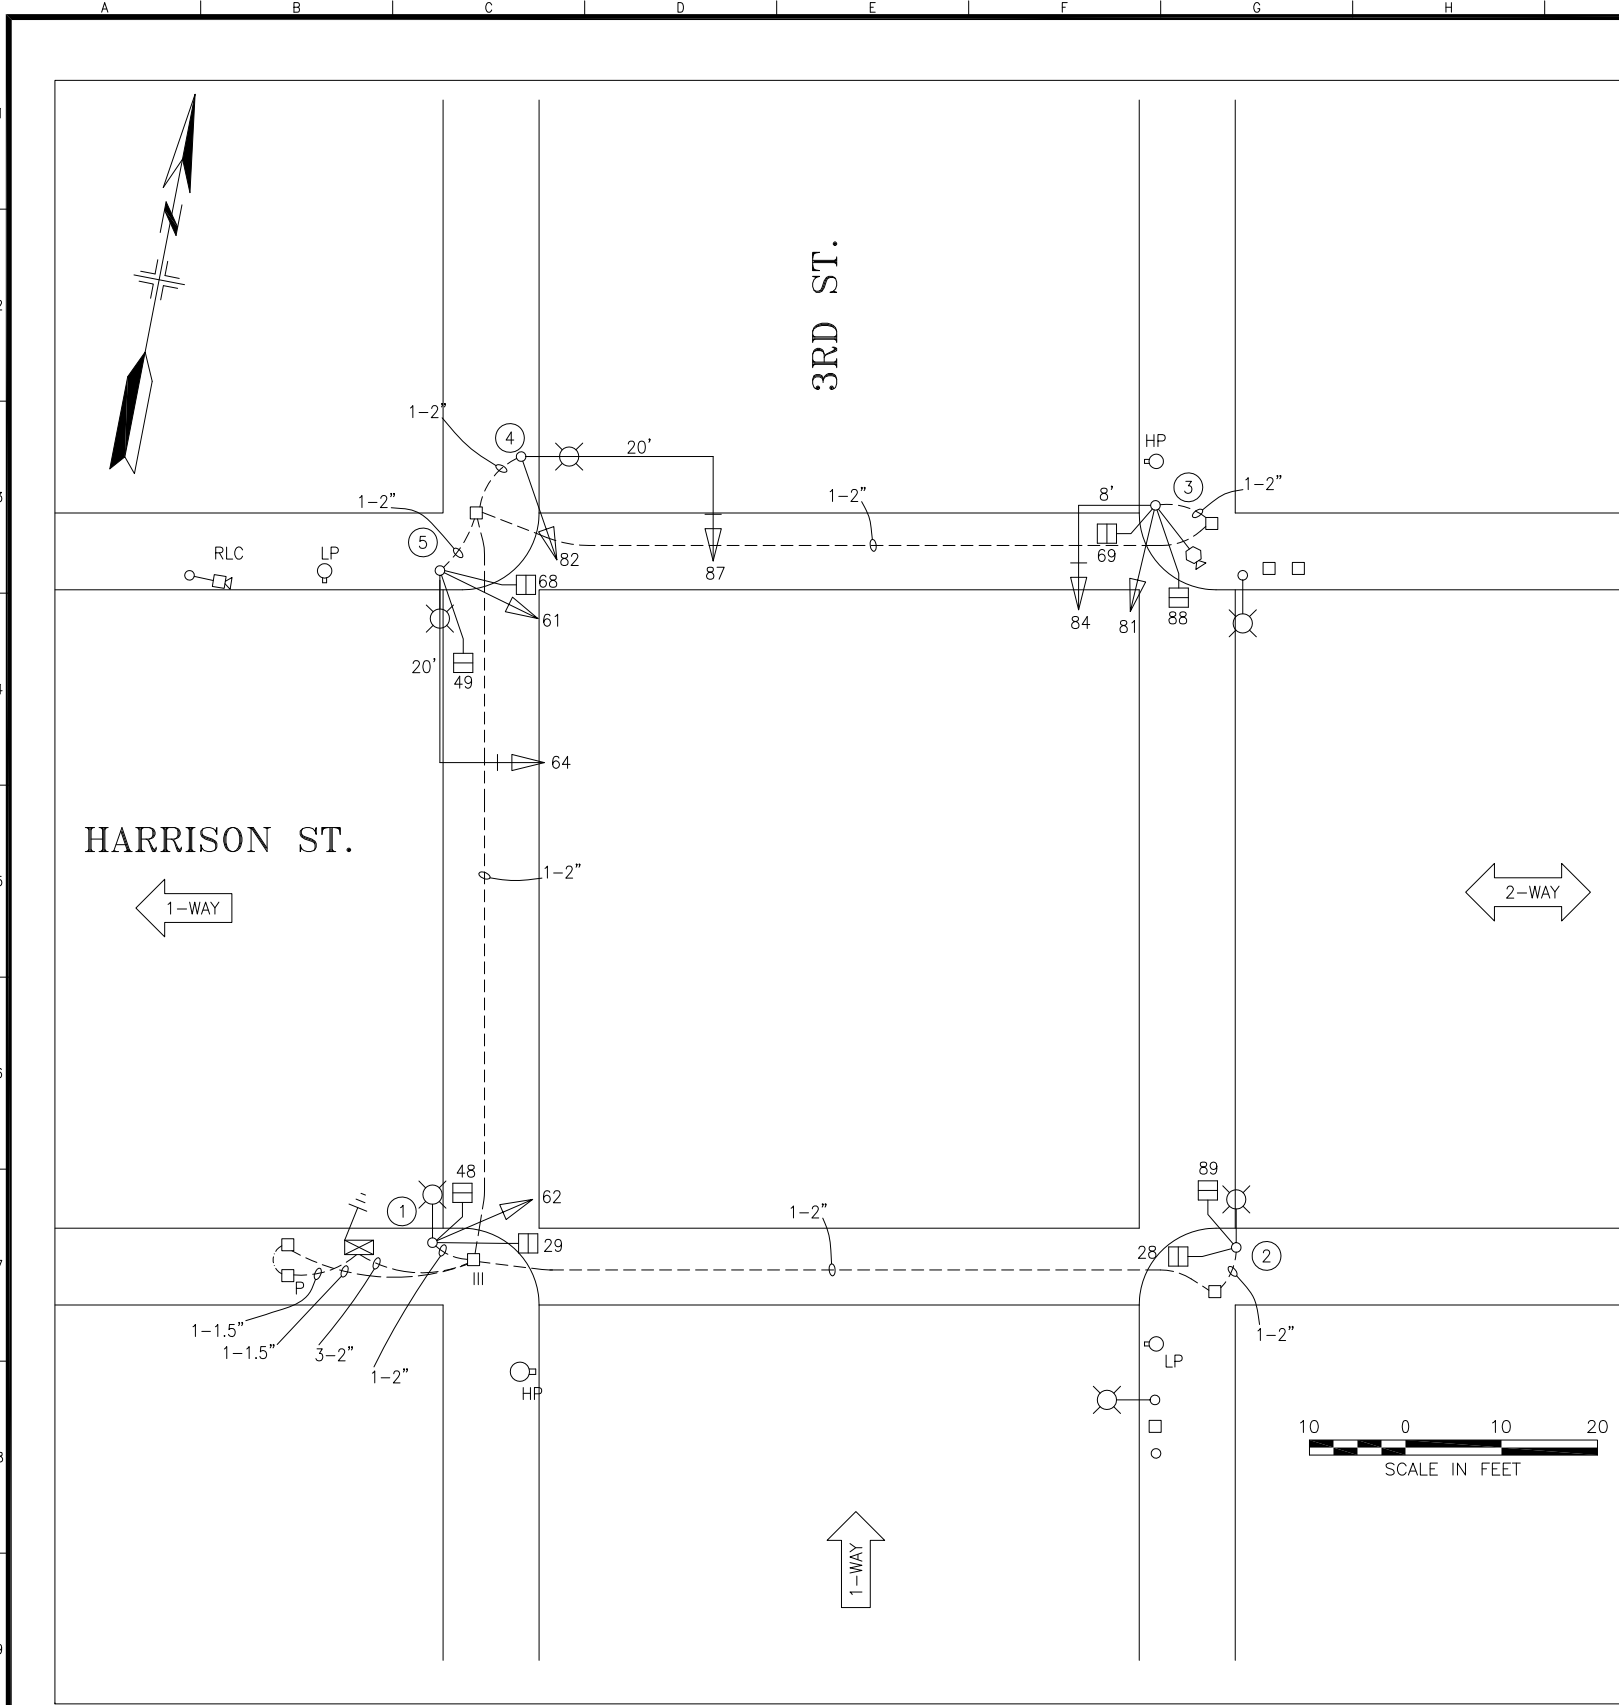

SAN FRANCISCO MUNICIPAL TRANSPORTATION AGENCY
CITY AND COUNTY OF SAN FRANCISCO

DRAWN: DATE:
JH 9/2015
CHECKED: DATE:
MV 9/2015

SCALE:

AS SHOWN

SHEET OF SHEETS

1 OF 1

TRAFFIC SIGNAL INVENTORY DIAGRAM

3RD STREET AND HARRISON STREET

CNN NO.

24513000

REV NO.