



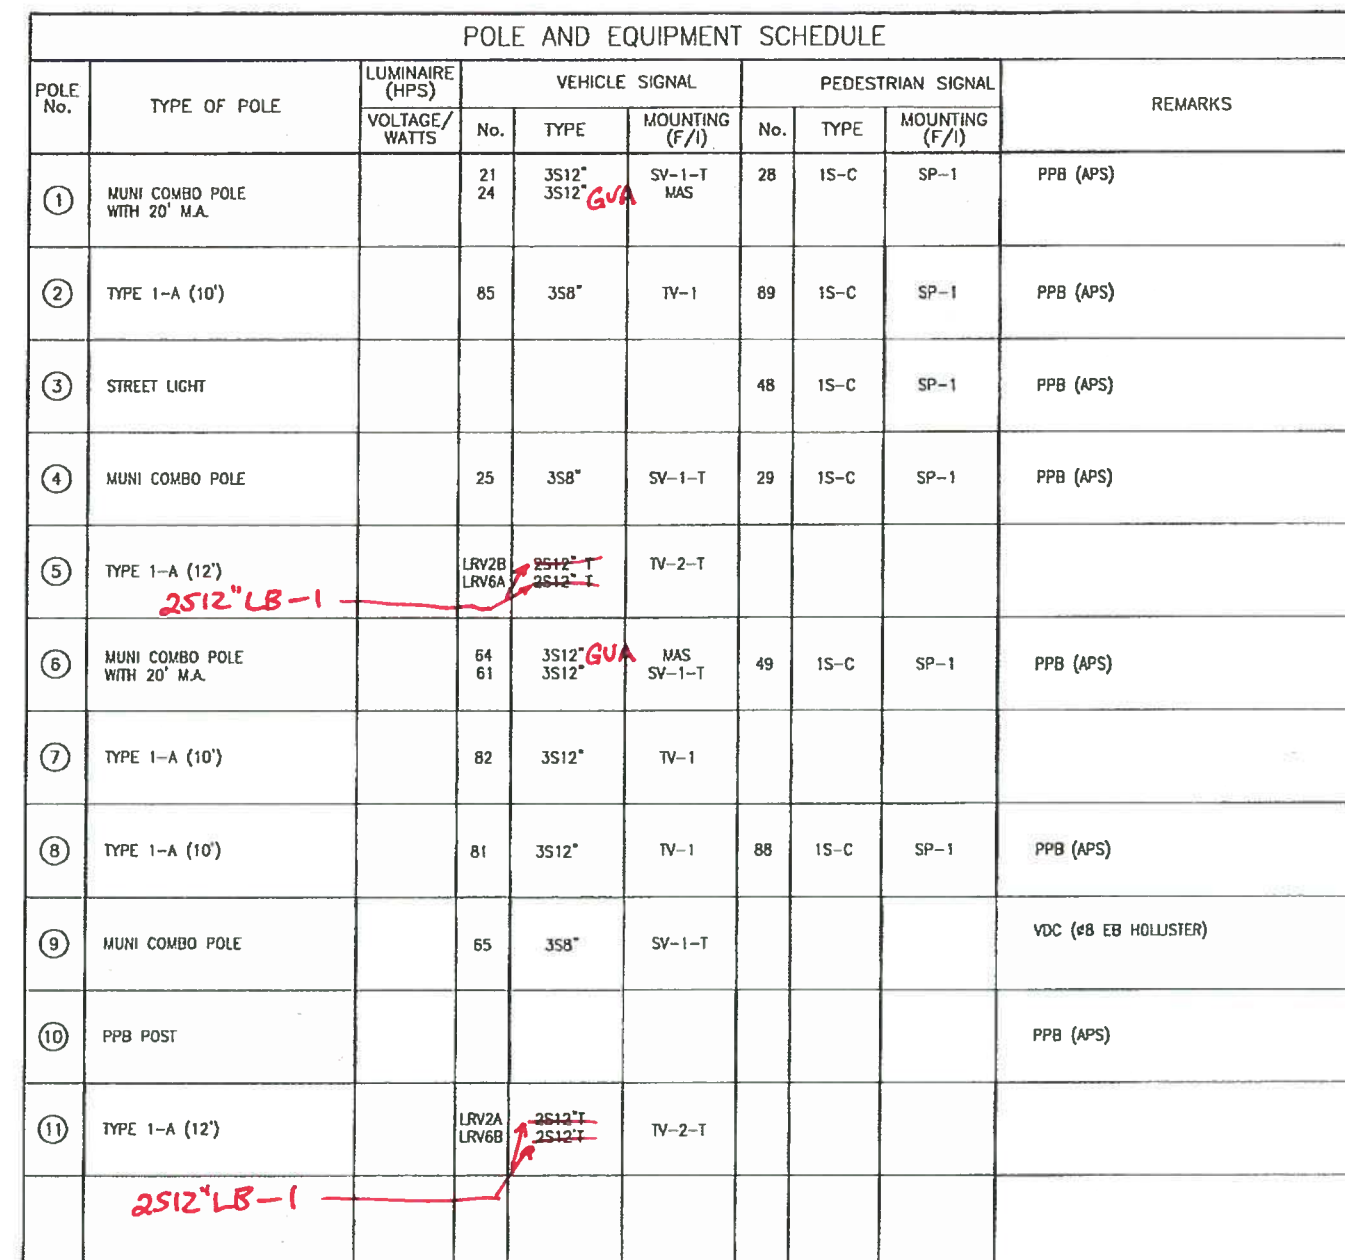

M.A. = EAST ARM

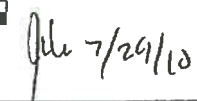

								SAN FRANCISCO MUNICIPAL TRANSPORTATION AGENCY		DRAWN: KK/dy	DATE: 12/05	SCALE: 1:200	TRAFFIC SIGNAL INVENTORY DIAGRAM		CNR NO. 20471000
								TRANSPORTATION ENGINEERING							
								CITY AND COUNTY OF SAN FRANCISCO		CHECKED:	DATE:	SHEET OF SHEETS	3RD ST AND HOLLISTER AVE INTERSECTION		REV. NO. X 2
2 1/26/14 RED MARK CHANGES PER SRC 2014-019					BW CW										
1 5/2/10 PER FIELD CHECK					DY CH										
0 1/25/05 3RD STREET LIGHT RAIL PROJECT - SEGMENT E CONTRACT NO. WR-1144															
NO. DATE DESCRIPTION					BY APP.										
TABLE OF REVISIONS															
CHECK WITH TRACING TO SEE IF YOU HAVE LATEST REVISION															