


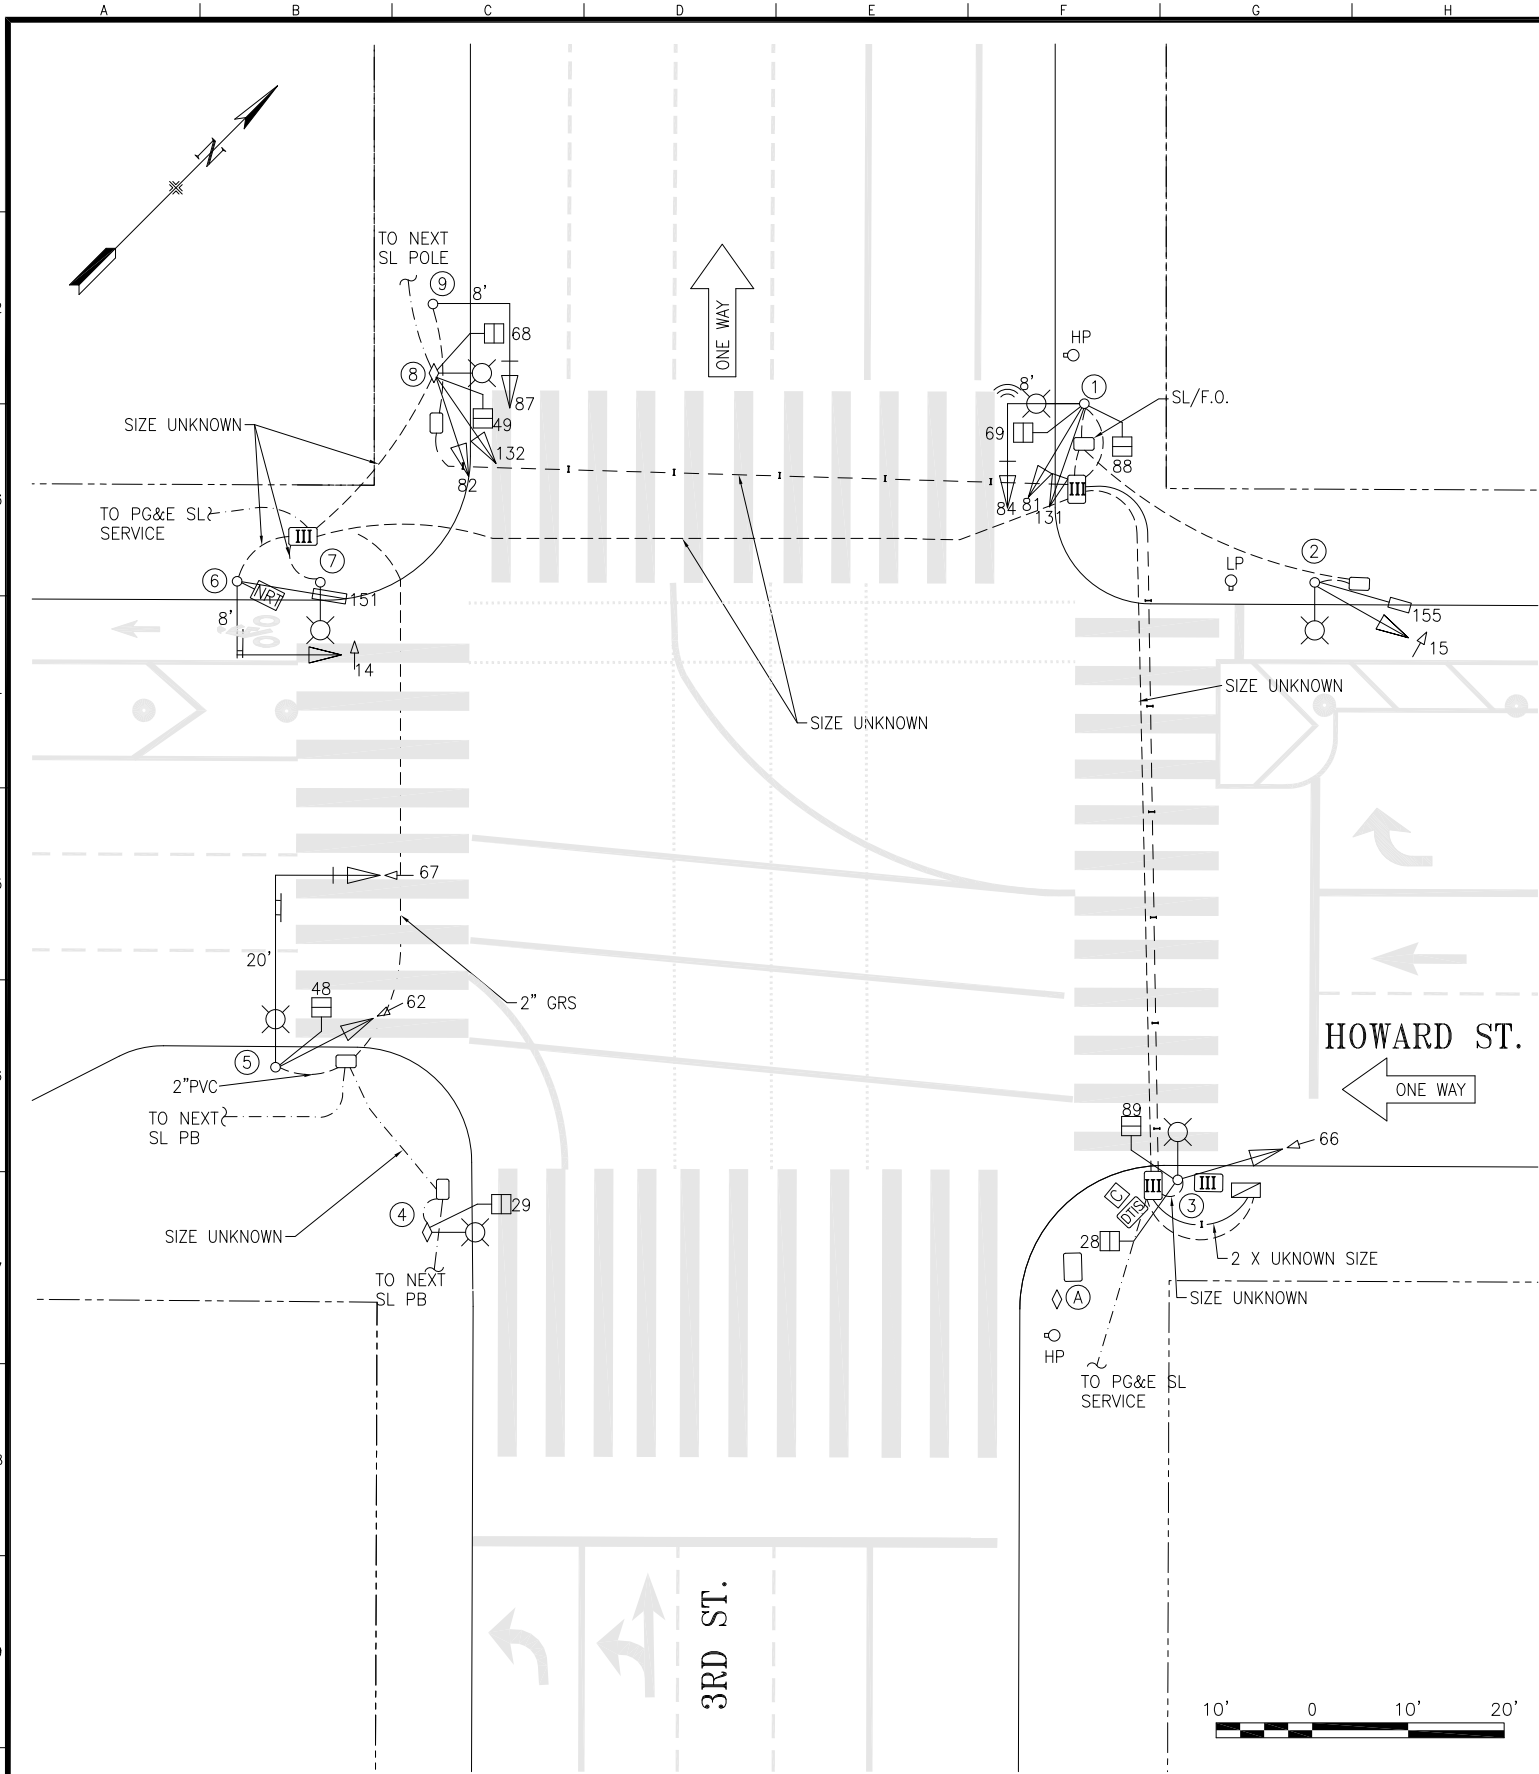

POLE AND EQUIPMENT SCHEDULE											
POLE No.	TYPE OF POLE	LUMINAIRE VOLTAGE/WATTAGE	VEHICLE SIGNAL					PEDESTRIAN SIGNAL			REMARKS
			No.	TYPE	MOUNTING	VISORS	LOUVERS	No.	TYPE	MOUNTING	
①	17B-1-70 W/ 8' MAST ARM AND 6' LUMINAIRE ARM		84	3S12"	MAS	T		69	1S-COUNT	SP-1	BP
			81	3S12"	SV-1-T	T		88	1S-COUNT	SP-1	BP
			131	2S12"LB	SV-1-T	T					
②	SL		15	3S12" RA	SV-1-T	T					35 MOUNTED @ 13FT
			155	3S8" BIKE	SV-1	T					165 MOUNTED @ 9FT
③	MUNI/SL		66	3S12" GVA	SV-1-T	T		28	1S-COUNT	SP-2-T-SF	MOUNTING PARALLEL TO HOWARD EXTERNAL CONDUIT
④	MUNI/SL							29	1S-COUNT	SP-1	
⑤	MUNI 770 20' MAST ARM AND 6' LUMINAIRE ARM		67	3S12" GVA	MAS	T		48	1S-COUNT	SP-1-SF	BP
			62	3S12" GVA	SV-1-T	T					
⑥	16-1-70 W/ 8' MAST ARM		NRT	IS 24"X24"	SV-1						NRT MOUNTED @ 14FT
			14	3S12" RA	MAS	T					BP
			151	3S12" BIKE	SV-1-T	T					
⑦	SL										
⑧	MUNI		82	3S12"	SV-1-T	T		68	1S-COUNT	SP-1	SFGO CCTV
			132	2S12"LB	SV-1-T	T		49	1S-COUNT	SP-1	
⑨	16-1-70 W/ 8' MASTARM		87	3S12"	MAS	T					BP
⑩	MUNI										

NOTE:
CABINET FOUNDATION TYPE: MSF

4	12/21/20	SRC 2020-229: ADDED SIGNALS 14, 15, 62, 66, 67, 151, 155 & NRT; ADDED POLE 2; RENUMBERED POLES; UPDATED STRIPING AT HOWARD	AK	MS
3	10/21/20	SRC 2020-005: ADDED 131 & 132, UPDATED VEH TO 12", RENUMBERED POLES	HYU	WVelasco
2	06/19	MOSCONE CENTER EXPANSION		
1	03/99	HOWARD STREET SIGNAL UPGRADE CONTRACT #1430N	CXL	RO
NO.	DATE	DESCRIPTION	BY	APP.
TABLE OF REVISIONS CHECK WITH TRACING TO SEE IF YOU HAVE LATEST REVISION				

REFERENCE INFORMATION & FILE NO. OF SURVEYS
--



SAN FRANCISCO MUNICIPAL TRANSPORTATION AGENCY

CITY AND COUNTY OF SAN FRANCISCO

DRAWN:	DATE:
JD/CX12/28/00	
CHECKED:	DATE:

--

SCALE: 1"=20'
SHEET OF SHEETS 1 of 1

TRAFFIC SIGNAL INVENTORY DIAGRAM
3RD STREET AND HOWARD STREET

CNN NO. 24590000
REV NO. 4