


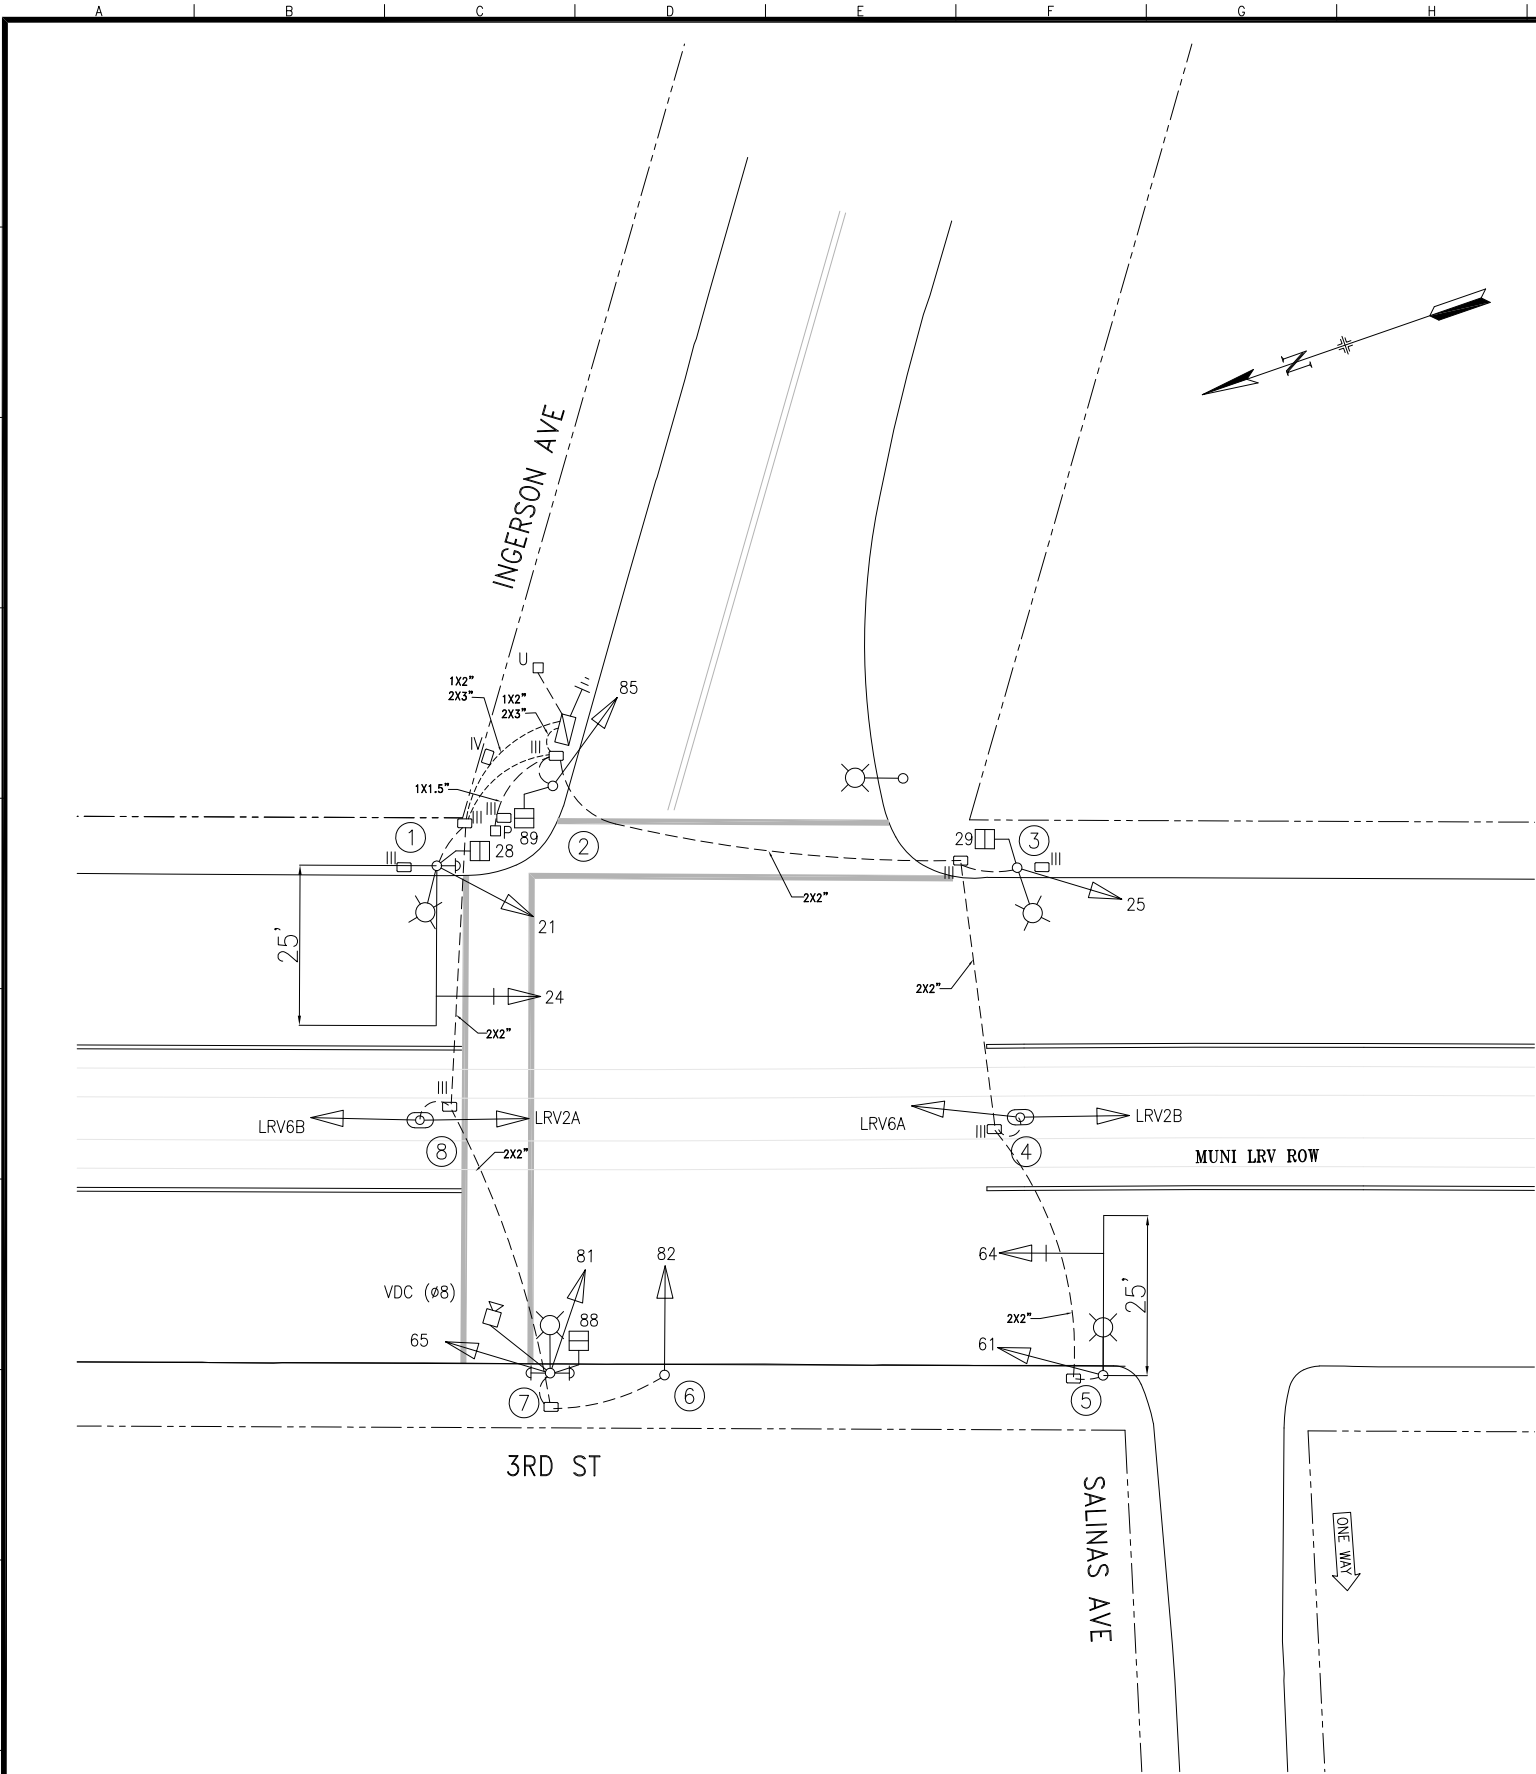

POLE AND EQUIPMENT SCHEDULE									
POLE No.	TYPE OF POLE	LUMINAIRE (HPS)	VEHICLE SIGNAL			PEDESTRIAN SIGNAL			REMARKS
		VOLTAGE/ WATTS	No.	TYPE	MOUNTING (F/I)	No.	TYPE	MOUNTING (F/I)	
①	MUNI COMBO POLE WITH 25' M.A.		21 24	3S12" 3S12"GVA	SV-1-T MAS	28	1S-C	SP-1	PPB
②	TYPE 1-A (10')		85	3S12"	TV-1-T	89	1S-C	SP-1	
③	MUNI COMBO POLE		25	3S12"	SV-1-T	29	1S-C	SP-1	
④	TYPE 1-A (12')		LRV2B LRV6A	2S12"LB-1 2S12"LB-1	TV-2-T				
⑤	MUNI COMBO POLE WITH 25' M.A.		64 61	3S12"GVA 3S12"	MAS SV-1-T				
⑥	TYPE 1-A (10')		82	3S12"	TV-1				
⑦	MUNI COMBO POLE		65 81	3S12" 3S12"	SV-2-T	88	1S-C	SP-1	PPB x 2 VDC (ø8 WB INGERSON)
⑧	TYPE 1-A (12')		LRV2A LRV6B	2S12"LB-1 2S12"LB-1	TV-2-T				

M.A. = MAST ARM

NOTE:
CABINET FOUNDATION TYPE M-SF

NO.	DATE	DESCRIPTION	BY	APPROVED
3	12/10/21	CHANGE SIGNALS TO 12" PER SRC 2021-213	J.TOM	E.TSUI
2	01/19/14	RED MARK CHANGES PER SRC 2014-19	CW	BW
1	06/03/10	PER FIELD CHECK		
0	12/22/04	3RD ST LIGHT RAIL PROJ, SEG E, MR-1144	DC	CH
TABLE OF REVISIONS				
CHECKOUT DRAWING THROUGH THE SID CUSTODIAN FOR THE LATEST REVISION				



SFMTA

DRAWN BY:	DATE:
KK/DY	12/05
CHECKED BY:	DATE:

SCALE
NONE
SHEET OF SHEETS
1 OF 1

TRAFFIC SIGNAL INVENTORY DIAGRAM
3RD STREET AND INGERSON STREET

CNN NO:
20473000
REV NO:
3