


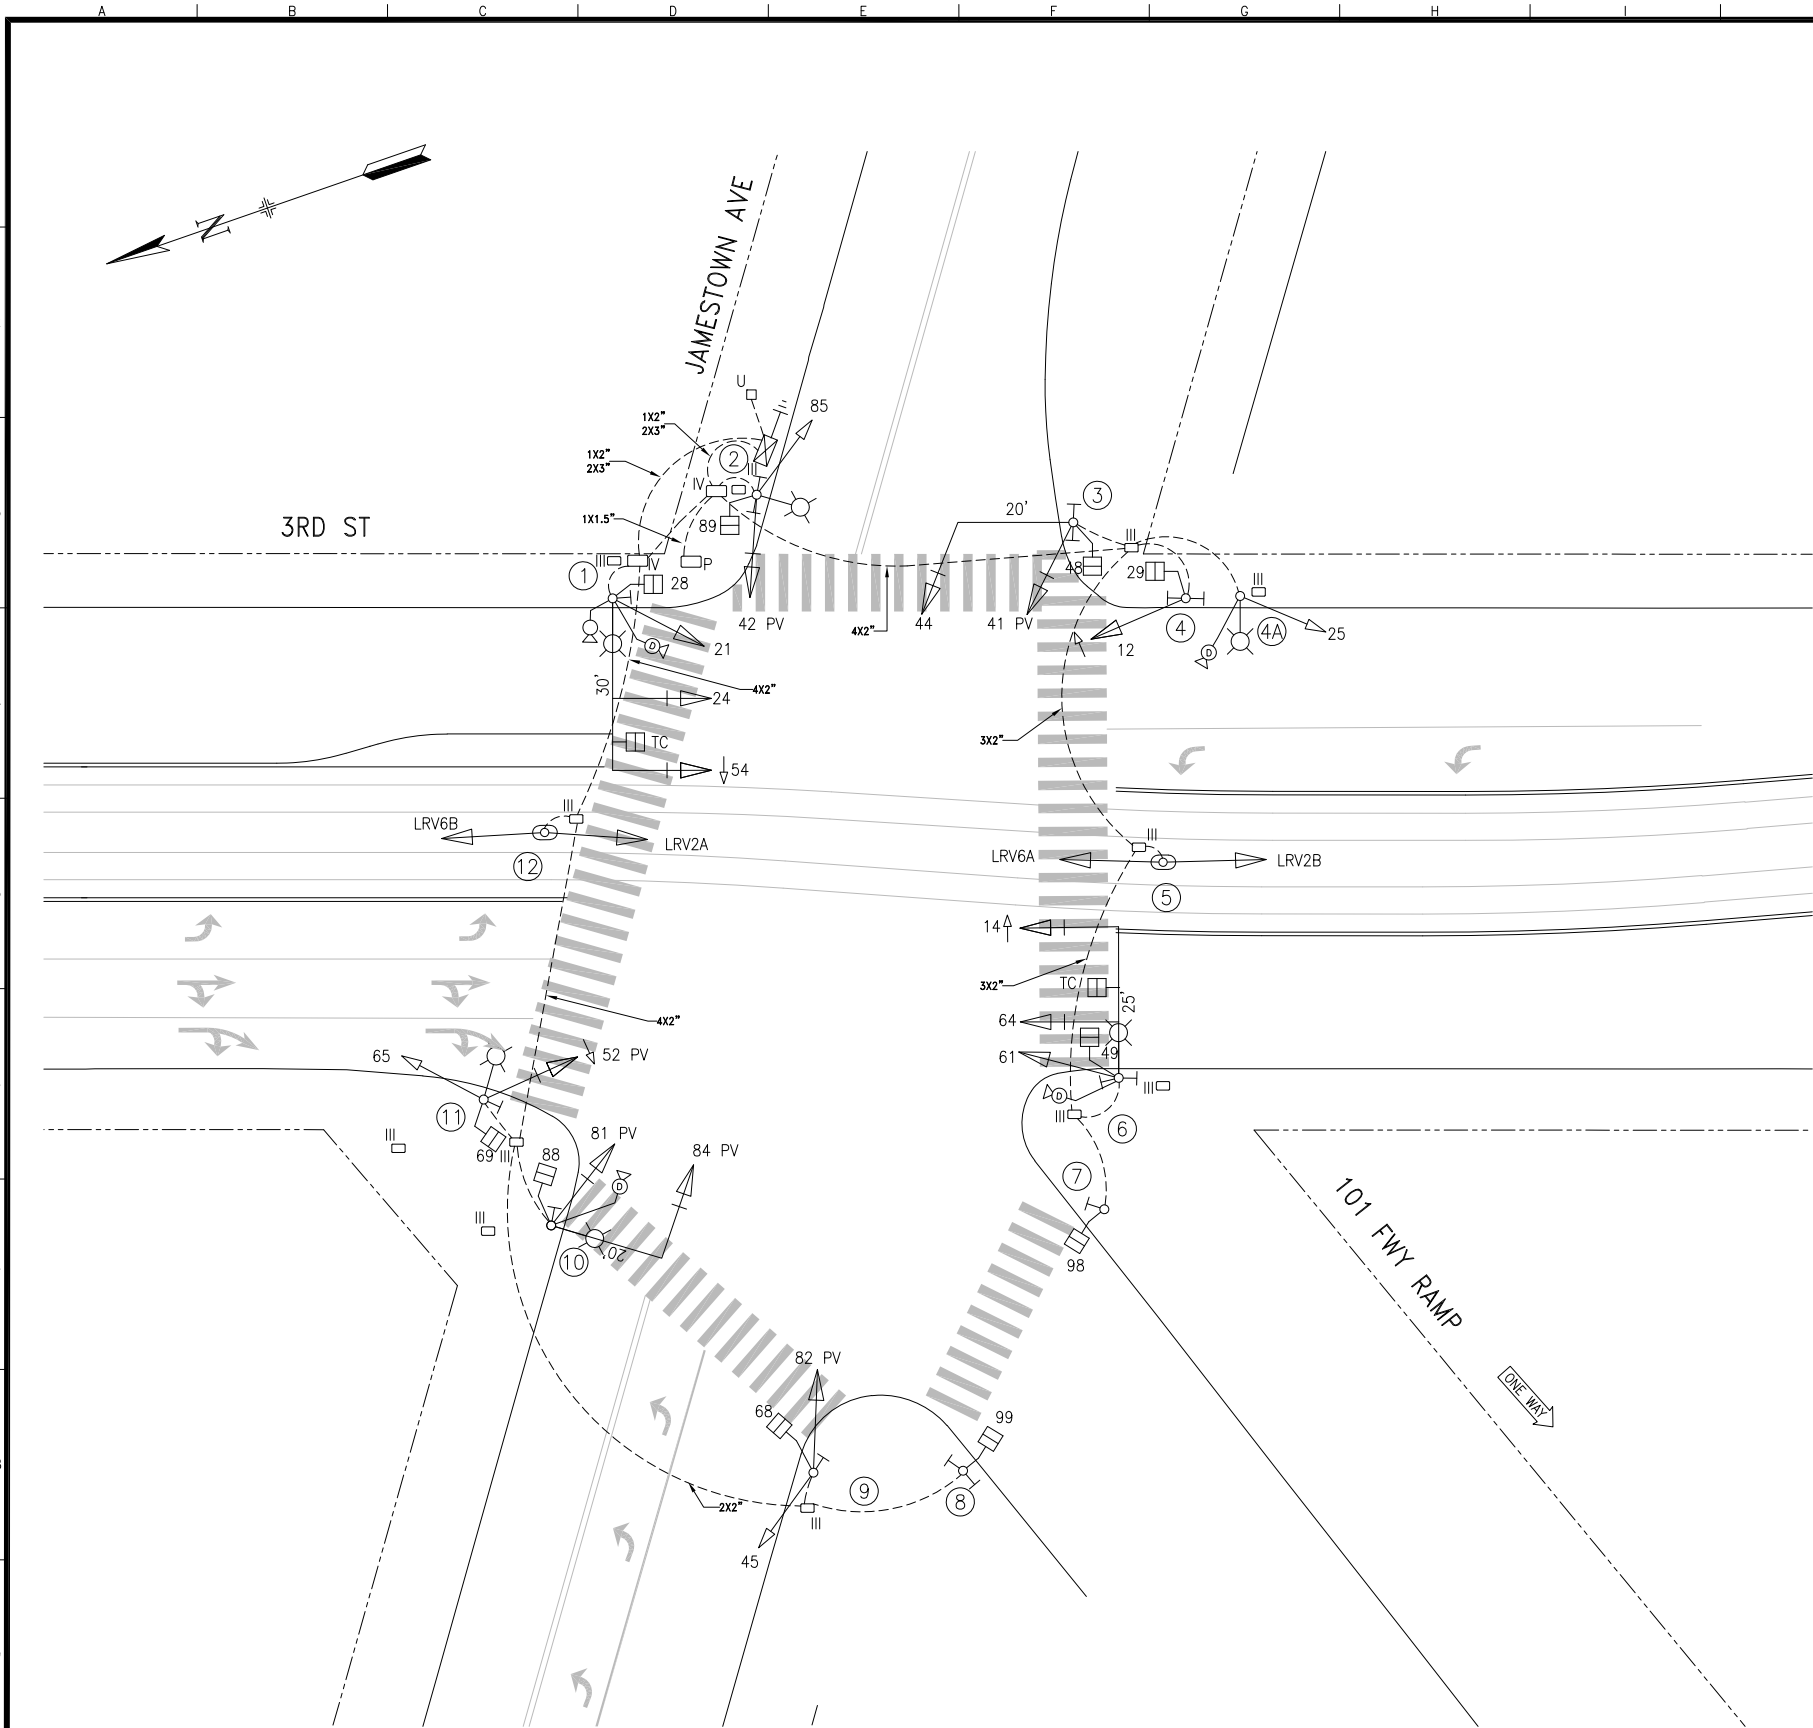

POLE AND EQUIPMENT SCHEDULE									
POLE No.	TYPE OF POLE	LUMINAIRE (HPS) VOLTAGE/ WATTS	VEHICLE SIGNAL			PEDESTRIAN SIGNAL			REMARKS
			No.	TYPE	MOUNTING (F/I)	No.	TYPE	MOUNTING (F/I)	
①	MUNI COMBO POLE WITH 30' MAST ARM		21 24 TC 54	3S12" 3S12" IS 24"x24" 3S12" LA	SV-1-T MAS PELCO MAS	28	1S-C	SP-1	APS WIRELESS SENSOR CCTV CAMERA DETECTION CAMERA (NOT ACTIVE)
②	STREET LIGHT		42 85	PV 3S12" 3S8"	SV-2-TA	89	1S-C	SP-1	APS x2
③	TYPE 16-2-129 WITH 20' MAST ARM		41 44	PV 3S12" 3S12"	SV-1-T MAS (TIP)	48	1S-C	SP-1	APS x2
④	TYPE 1-A (10')		12	3S12" LA	TV-1-T	29	1S-C	SP-1	APS x2
④A	MUNI COMBO POLE		25	3S8"	SV-1-T				DETECTION CAMERA (NOT ACTIVE)
⑤	TYPE 1-A (12')		LRV2B LRV6A	2S12"LB - 2S12"LB -	TV-2-T				
⑥	MUNI COMBO POLE WITH 25' MAST ARM		61 64 TC 14	3S12" 3S12" IS 24"x24" 3S12" LA	SV-1-T MAS PELCO MAS	49	1S-C	SP-1	APS x2 WIRELESS SENSOR DETECTION CAMERA (NOT ACTIVE)
⑦	TYPE 1-A (7')					98	1S-C	TP-1	APS
⑧	TYPE 1-A (7')					99	1S-C	TP-1	APS x2
⑨	TYPE 1-A (15')		45 82	3S8" PV 3S12"	SV-1-T Ø10FT TV-1	68	1S-C	SP-1	APS
⑩	POLE TYPE 17-2-129 WITH 20' MAST ARM		81 84	PV 3S12" PV 3S12"	SV-1-T MAS (TIP)	88	1S-C	SP-1	APS DETECTION CAMERA (NOT ACTIVE)
⑪	MUNI COMBO POLE		52 65	PV 3S12" LA 3S8"	SV-2-TA	69	1S-C	SP-1	APS
⑫	TYPE 1-A (12')		LRV2A LRV6B	2S12"LB - 2S12"LB -	TV-2-T				

NOTES:
INTERSECTION IS ON CALTRANS PROPERTY
CABINET FOUNDATION TYPE M-SF

4	9/1/23	PER SRC 2023-075. ADD EXTRA APS TO A FEW POLES	DYeung	GdeLeon
3	10/4/22	UPDATE PER FIELD: ADD CCTV. VDC INACTIVE. ADD WIRELESS. 45Ø10FT. DELETE POLE TO SIGNAL HEIGHT NOTE. POLE 4 10FT. UPDATE TC	DYeung	GdeLeon
2	1/19/14	PER SRC 2013-327: REMOVE SIGNAL 13 & 53. CHANGE LRV SIGNALS FROM "T" TO LUNAR BARS.	CWong	BWoo
1	6/3/10	PER FIELD CHECK	DChan	CHui
0	12/7/04	3RD STREET LIGHT RAIL PROJECT - SEGMENT E CONTRACT NO. MR-1144		
NO.	DATE	DESCRIPTION	BY	APPROVED
TABLE OF REVISIONS CHECKOUT DRAWING THROUGH THE SID CUSTODIAN FOR THE LATEST REVISION				



SFMTA

DRAWN BY: KKwong/DYeung	DATE: 12/05	SCALE 1:200	TRAFFIC SIGNAL INVENTORY DIAGRAM	CNN NO: 20460000
CHECKED BY:	DATE:	SHEET OF SHEETS 1 OF 1	3RD ST AND 101 FREEWAY ON-RAMP/ JAMESTOWN AVE INTERSECTION	REV NO: 4