


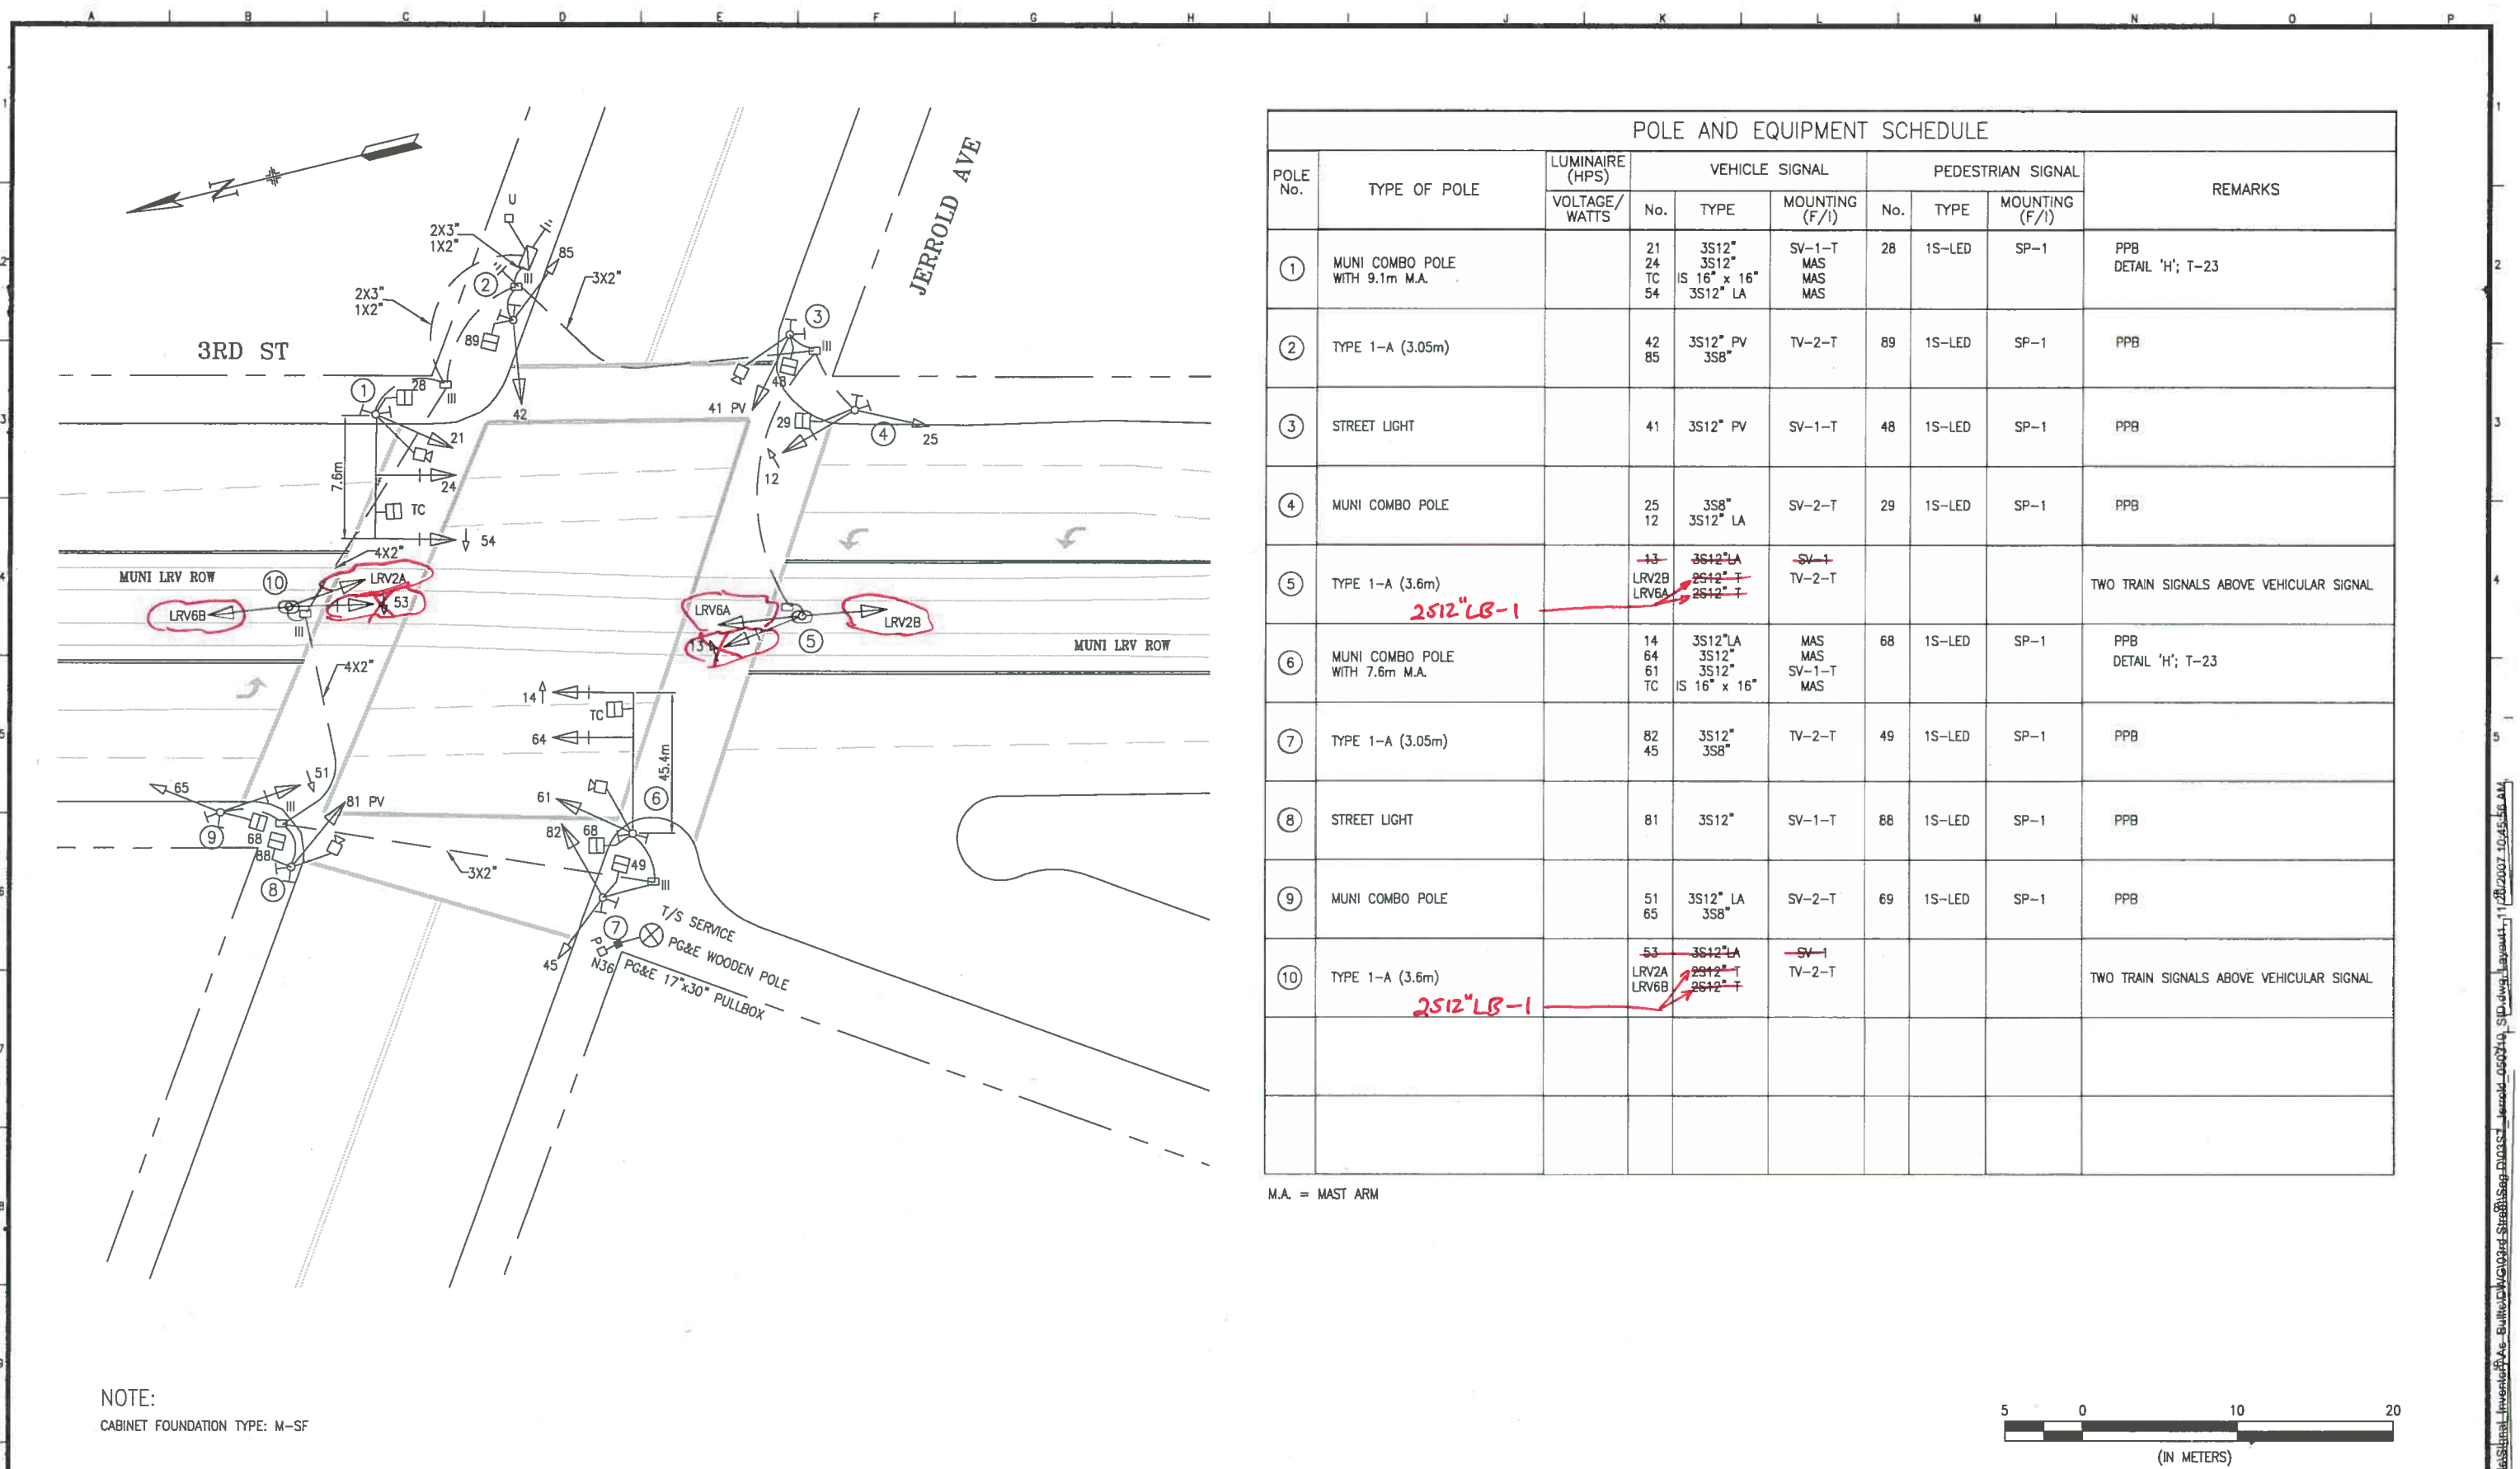

POLE AND EQUIPMENT SCHEDULE									
POLE No.	TYPE OF POLE	LUMINAIRE (HPS)	VEHICLE SIGNAL			PEDESTRIAN SIGNAL			REMARKS
		VOLTAGE/ WATTS	No.	TYPE	MOUNTING (F/I)	No.	TYPE	MOUNTING (F/I)	
①	MUNI COMBO POLE WITH 9.1m M.A.		21 24 TC 54	3S12" 3S12" IS 16" x 16" 3S12" LA	SV-1-T MAS MAS MAS	28	1S-LED	SP-1	PPB DETAIL 'H'; T-23
②	TYPE 1-A (3.05m)		42 85	3S12" PV 3S8"	TV-2-T	89	1S-LED	SP-1	PPB
③	STREET LIGHT		41	3S12" PV	SV-1-T	48	1S-LED	SP-1	PPB
④	MUNI COMBO POLE		25 12	3S8" 3S12" LA	SV-2-T	29	1S-LED	SP-1	PPB
⑤	TYPE 1-A (3.6m) <i>2512"LB-1</i>		13 LRV2B LRV6A	3S12" LA 2512" T 2512" T	SV-1 TV-2-T				TWO TRAIN SIGNALS ABOVE VEHICULAR SIGNAL
⑥	MUNI COMBO POLE WITH 7.6m M.A.		14 64 61 TC	3S12" LA 3S12" 3S12" IS 16" x 16"	MAS MAS SV-1-T MAS	68	1S-LED	SP-1	PPB DETAIL 'H'; T-23
⑦	TYPE 1-A (3.05m)		82 45	3S12" 3S8"	TV-2-T	49	1S-LED	SP-1	PPB
⑧	STREET LIGHT		81	3S12"	SV-1-T	88	1S-LED	SP-1	PPB
⑨	MUNI COMBO POLE		51 65	3S12" LA 3S8"	SV-2-T	69	1S-LED	SP-1	PPB
⑩	TYPE 1-A (3.6m) <i>2512"LB-1</i>		53 LRV2A LRV6B	3S12" LA 2512" T 2512" T	SV-1 TV-2-T				TWO TRAIN SIGNALS ABOVE VEHICULAR SIGNAL

M.A. = MAST ARM

NOTE:
CABINET FOUNDATION TYPE: M-SF

2	3/16/14	RED MARK CHANGES PER SRC 2014-053	BW	CW
1	3/10/05	TRAFFIC SIGNAL UPGRADE FOR THIRD STREET LIGHT RAIL	DY	AH
NO.	DATE	DESCRIPTION	BY	APP.

TABLE OF REVISIONS
CHECK WITH TRACING TO SEE IF YOU HAVE LATEST REVISION

DEPARTMENT OF PARKING AND TRAFFIC

DIVISION OF TRAFFIC ENGINEERING

CITY AND COUNTY OF SAN FRANCISCO

DRAWN: DATE: SCALE:

DY 6/06 1:200

CHECKED: DATE: SHEET OF SHEETS

OF

TRAFFIC SIGNAL INVENTORY DIAGRAM

20230000

TRAFFIC SIGNAL PLAN

3RD ST AND JERROLD AVE INTERSECTION

CNN NO.

2