




NOTE:
SIGNALS SWITCHED OVER ON 7/8/03
CABINET FOUNDATION TYPE M-SF

POLE AND EQUIPMENT SCHEDULE											
POLE No.	TYPE OF POLE	LUMINAIRE VOLTAGE/ WATTAGE	VEHICLE SIGNAL					PEDESTRIAN SIGNAL			REMARKS
			No.	TYPE	MOUNTING	VISORS	LOUVERS	No.	TYPE	MOUNTING	
①	STREETLIGHT		81	3S8"	SV-1-T						APS
②	1-A (12')		65 X	3S8" 12"-RED	TV-2-T			69 828	1S-COUNT 1S-COUNT	SP-2	APS PED SIGNALS SHARE MOUNTING RED SIGNAL IS OFF
③	MUNI COMBO POLE		523 16	3S12"-LA 3S12"-LA	SV-1 SV-1			829 818 TC8C	1S-COUNT 1S-COUNT 1S-24"X24"		
④	PPB POST										APS
⑤	MUNI COMBO POLE		53 54 513 TC2A 814 824	3S12"-LA 3S12"-LA 3S12"-LA 1S-16"X16" 3S12" 3S12"	MAS MAS SV-1 MAS SV-1 MAS MAS			819 88 TC8D	1S-COUNT 1S-COUNT 1S-24"X24"		APS
⑥	POLE W/ MA		24 21	3S12" 3S8"	MAS SV-1-T			28 89	1S-COUNT 1S-COUNT	SP-2-T-SF	APS
⑦	PPB POST										APS
⑧	MISSION BAY STYLE STREET LIGHT										APS APS (BOTH APS FOR XING 3RD)
⑨	1-A (12')		25	3S8"	TV-1-T			29 428	1S-COUNT 1S-COUNT	SP-1-T SP-1-T	APS APS (ONE APS FOR EACH XWALK)
⑩	MUNI COMBO POLE		13 56 LRV-2A	3S12"LA 3S12"LA 2S12"LB-	SV-1-T SV-1-T SV-1-T			418 429 TC4A	1S-COUNT 1S-COUNT 1S-24"X24"		APS
⑪	MUNI COMBO POLE WITH 45' MAST ARM AND 10' MAST ARM		84 113 14 LRV6A TC6A	3S12" 3S12"-LA 3S12"-LA 2S12"LB- 1S-16"X16"	MAS (45') SV-1-T MAS (10') SV-1-T SV-1			419 48 TC4B	1S-COUNT 1S-COUNT 1S-24"X24"		APS
⑫	18-3-70 WITH 18' MAST ARM		64 61	3S12" 3S8"	MAS SV-1-T			49	1S-COUNT	SP-1-T	APS APS (ONE APS FOR EACH XWALK)
⑬	MUNI COMBO POLE WITH STREET-LIGHT (MISSION BAY STYLE)							68	1S-COUNT	SP-1-T	APS
⑭	MUNI COMBO POLE		LRV6B	2S12"LB-	SV-1						
⑮	MUNI COMBO POLE		LRV6B	2S12"LB-	SV-1						
⑯	CMS POLE				CMS						

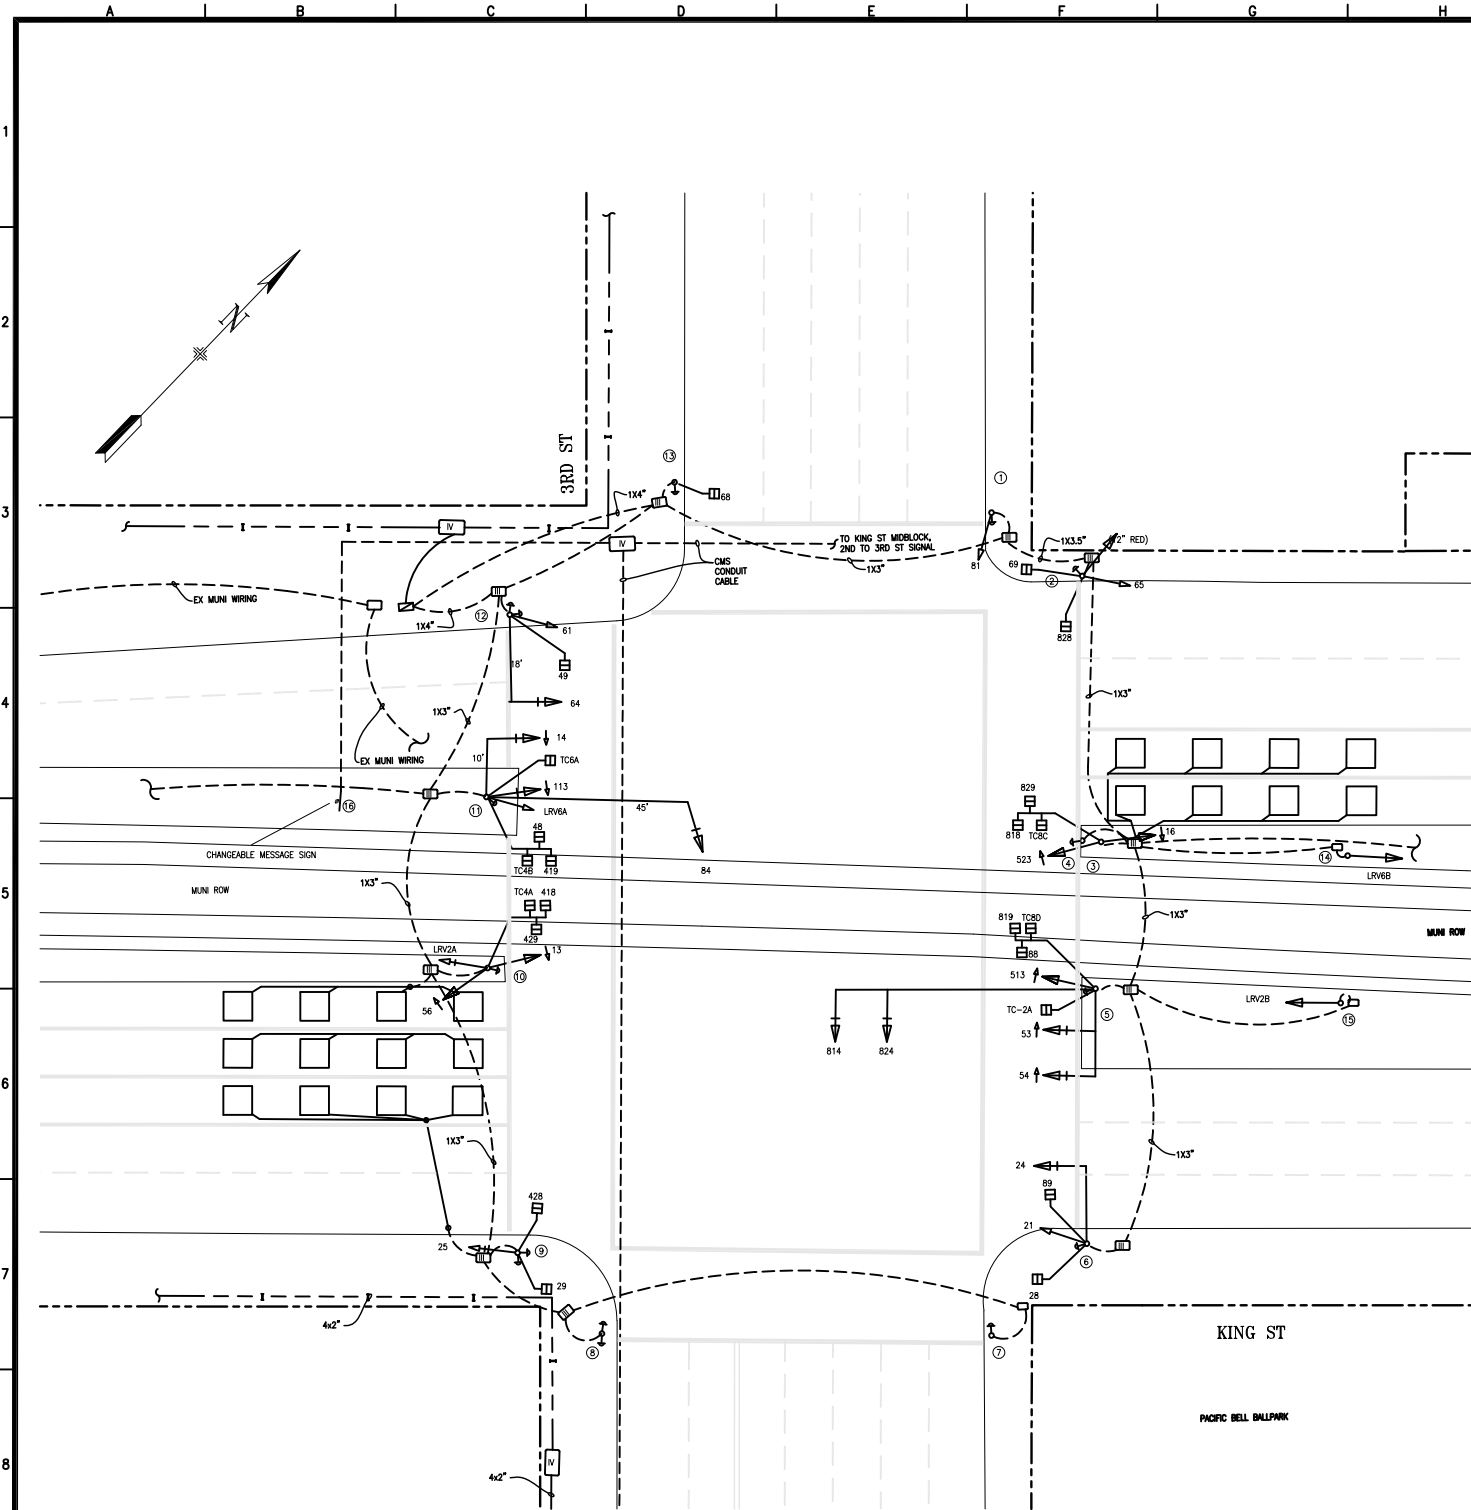