



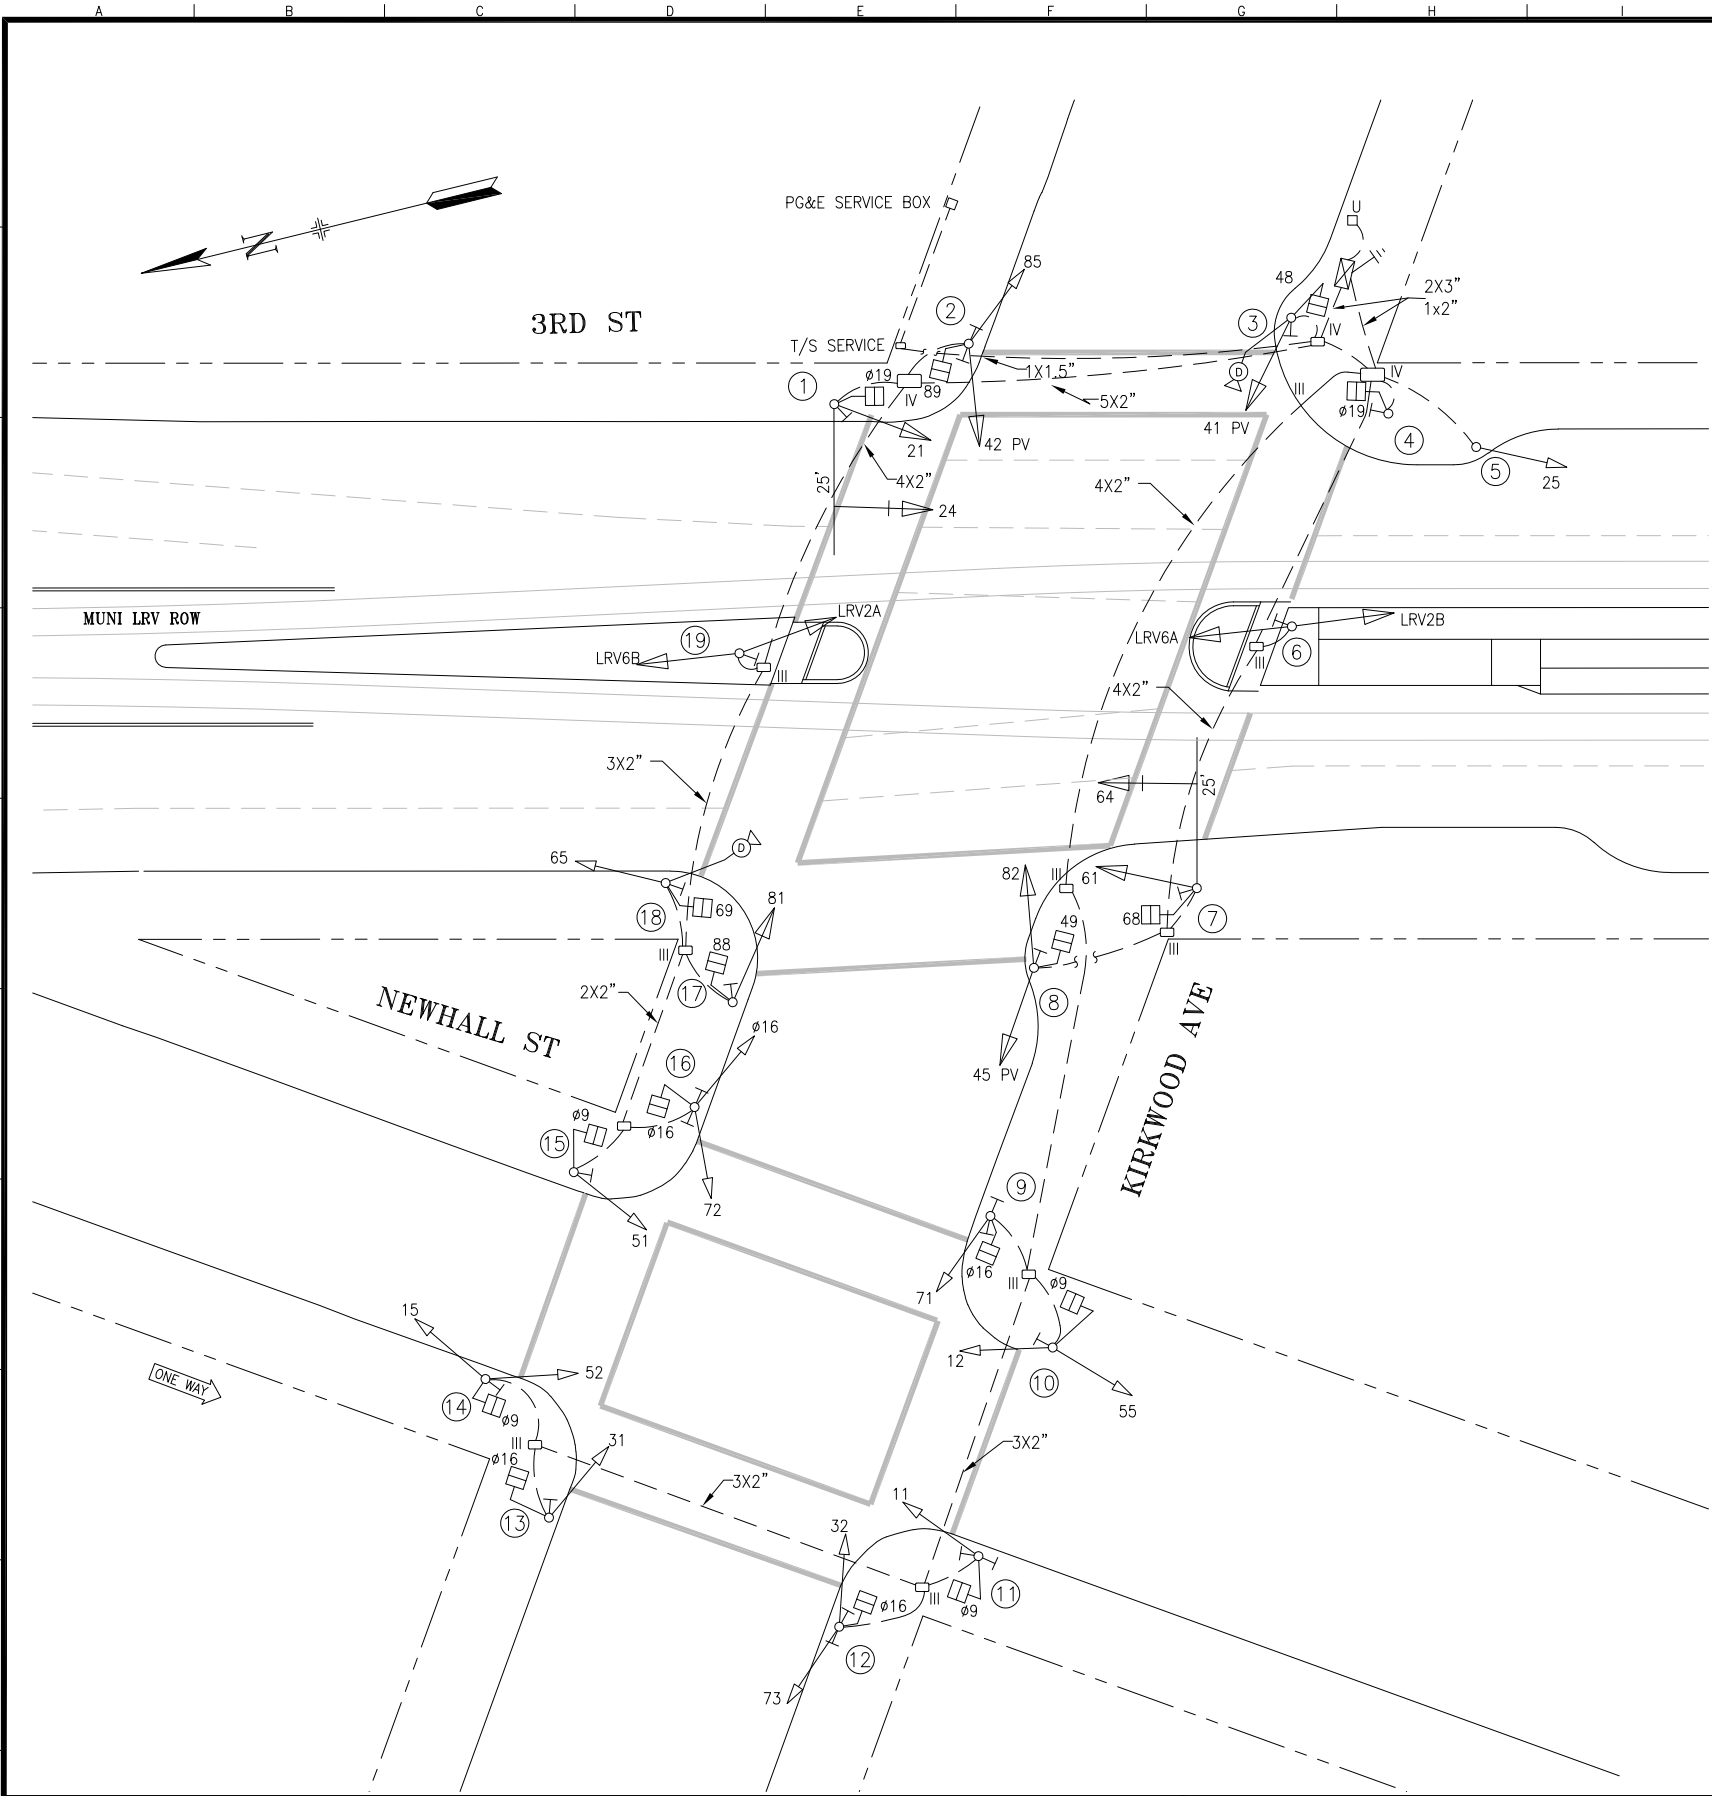

POLE AND EQUIPMENT SCHEDULE									
POLE No.	TYPE OF POLE	LUMINAIRE (HPS) VOLTAGE/WATTS	VEHICLE SIGNAL			PEDESTRIAN SIGNAL			REMARKS
			No.	TYPE	MOUNTING (F/I)	No.	TYPE	MOUNTING (F/I)	
①	MUNI COMBO POLE WITH 25' MAST ARM		24 21	3S12"GVA 3S12"	MAS SV-1-T	ø19	1S-C	SP-1	DETAIL 'F'; T-23 APS
②	TYPE 1-A (10')		42 85	3S12" PV 3S8"	TV-2-T	89	1S-C	SP-1	APS x2
③	STREET LIGHT		41	3S12" PV	SV-1-T	48	1S-C	SP-1	APS VIDEO DETECTION CAMERA
④	MUNI POLE					ø19	1S-C	SP-1	APS
⑤	TYPE 1-A (10')		25	3S8"	TV-1				
⑥	TYPE 1-A (12')		LRV2B LRV6A	2S12"LB - 2S12"LB -	TV-2-T				APS
⑦	MUNI COMBO POLE WITH 25' MAST ARM		64 61	3S12"GVA 3S12"	MAS SV-1-T	68	1S-C	SP-1	DETAIL 'F'; T-23 APS
⑧	STREET LIGHT		82 45	3S12" PV 3S12" PV	SV-2-TA	49	1S-C	SP-1	APS
⑨	TYPE 1-A (10')		71	3S8"	TV-1	ø16	1S-C	SP-1	APS x2
⑩	STREET LIGHT		55 12	3S8"(R,Y,Y) 3S8"	SV-2-TA	ø9	1S-C	SP-1	APS
⑪	TYPE 1-A (10')		11	3S8"	TV-1	ø9	1S-C	SP-1	APS x2
⑫	TYPE 1-A (10')		73 32	3S8" 3S8"	TV-2-T	ø16	1S-C	SP-1	APS x2
⑬	TYPE 1-A (10')		31	3S8"	TV-1	ø16	1S-C	SP-1	APS
⑭	TYPE 1-A (10')		15 52	3S8" 3S8"(R,Y,Y)	TV-2-T	ø9	1S-C	SP-1	APS
⑮	TYPE 1-A (10')		51	3S8"(R,Y,Y)	TV-1	ø9	1S-C	SP-1	APS
⑯	TYPE 1-A (10')		33 72	3S8" 3S8"	TV-2-T	ø16	1S-C	SP-1	APS x2
⑰	TYPE 1-A (10')		81	3S12"	TV-1-T	88	1S-C	SP-1	APS
⑱	MUNI COMBO POLE		65	3S8"	SV-1-T	69	1S-C	SP-1	APS VIDEO DETECTION CAMERA
⑲	TYPE 1-A (12')		LRV6B LRV2A	2S12"LB - 2S12"LB -	TV-2-T				APS

M.A. = MAST ARM

NOTE:
CABINET FOUNDATION TYPE: M-SF

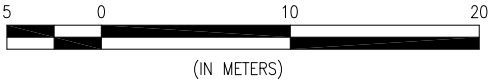

NO.	DATE	DESCRIPTION	BY	APPROVED
4	9/15/23	PER SRC 2023-075: ADD EXTRA APS AT A FEW POLES	DYeung	GdeLeon
3	9/20/22	UPDATE PER FIELD: UPDATE TO APS & 1S-C. NO VIDEO DETECTION ON POLE 8	DYeung	GdeLeon
2	3/16/14	PER SRC 2014-053: CHANGE 24 & 64 TO VERTICAL GREEN ARROW. CHANGE LRV SIGNALS FROM "T" TO LUNAR BARS.	CWong	BWoo
1	6/8/05	TRAFFIC SIGNAL UPGRADE FOR THIRD STREET LIGHT RAIL	DYeung	AHerce
TABLE OF REVISIONS	CHECKOUT DRAWING THROUGH THE SID CUSTODIAN FOR THE LATEST REVISION			



SFMTA

DRAWN BY:	DATE:
DYeung	6/06
CHECKED BY:	DATE:

SCALE
1:200
SHEET OF SHEETS
1 OF 1

TRAFFIC SIGNAL INVENTORY DIAGRAM
TRAFFIC SIGNAL PLAN 3RD ST AND KIRKWOOD/NEWHALL AVES

CNN NO:
20223000
REV NO:
4