



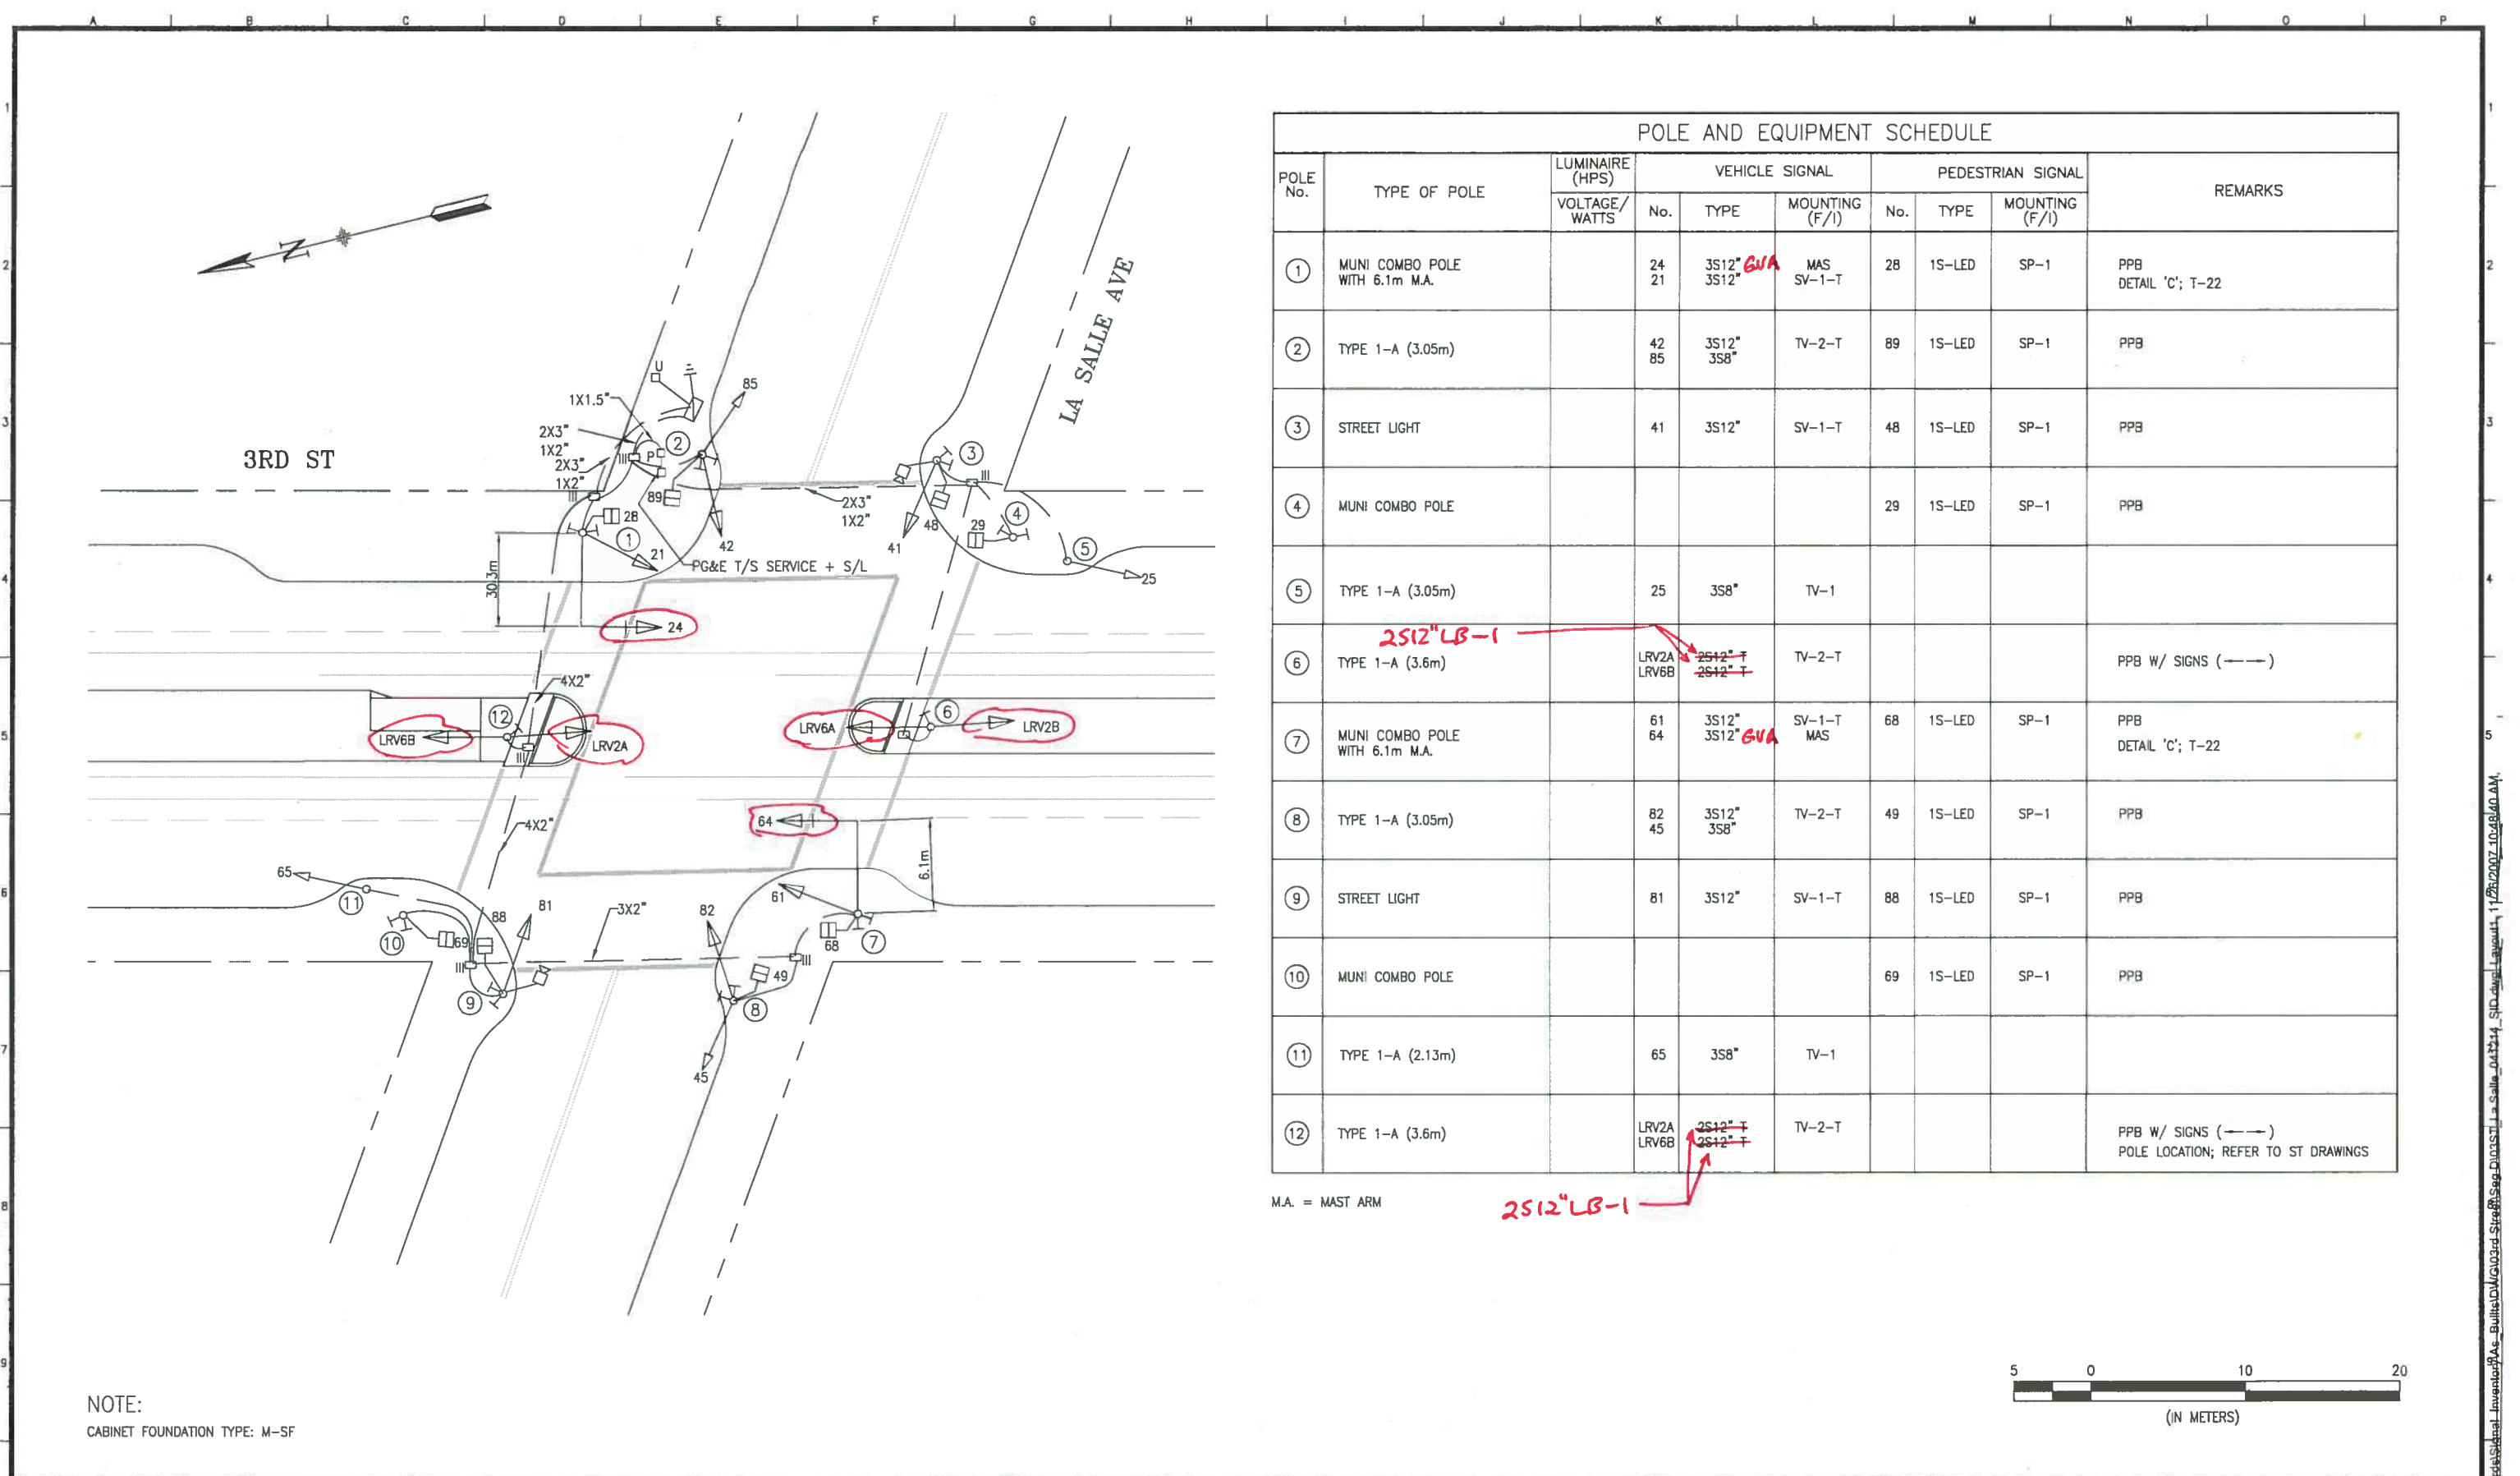

POLE AND EQUIPMENT SCHEDULE									
POLE No.	TYPE OF POLE	LUMINAIRE (HPS)	VEHICLE SIGNAL			PEDESTRIAN SIGNAL			REMARKS
		VOLTAGE/ WATTS	No.	TYPE	MOUNTING (F/I)	No.	TYPE	MOUNTING (F/I)	
①	MUNI COMBO POLE WITH 6.1m M.A.		24 21	3S12" <i>GVA</i> 3S12"	MAS SV-1-T	28	1S-LED	SP-1	PPB DETAIL 'C'; T-22
②	TYPE 1-A (3.05m)		42 85	3S12" 3S8"	TV-2-T	89	1S-LED	SP-1	PPB
③	STREET LIGHT		41	3S12"	SV-1-T	48	1S-LED	SP-1	PPB
④	MUNI COMBO POLE					29	1S-LED	SP-1	PPB
⑤	TYPE 1-A (3.05m)		25	3S8"	TV-1				
⑥	TYPE 1-A (3.6m)		LRV2A LRV6B	<i>2512" LB-1</i> 2512" 2512"	TV-2-T				PPB W/ SIGNS (---)
⑦	MUNI COMBO POLE WITH 6.1m M.A.		61 64	3S12" 3S12" <i>GVA</i>	SV-1-T MAS	68	1S-LED	SP-1	PPB DETAIL 'C'; T-22
⑧	TYPE 1-A (3.05m)		82 45	3S12" 3S8"	TV-2-T	49	1S-LED	SP-1	PPB
⑨	STREET LIGHT		81	3S12"	SV-1-T	88	1S-LED	SP-1	PPB
⑩	MUNI COMBO POLE					69	1S-LED	SP-1	PPB
⑪	TYPE 1-A (2.13m)		65	3S8"	TV-1				
⑫	TYPE 1-A (3.6m)		LRV2A LRV6B	<i>2512" LB-1</i> 2512" 2512"	TV-2-T				PPB W/ SIGNS (---) POLE LOCATION; REFER TO ST DRAWINGS

M.A. = MAST ARM

NOTE:
CABINET FOUNDATION TYPE: M-SF

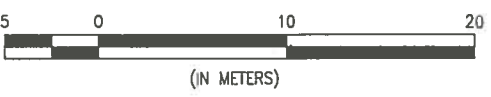

2	3/16/14	RED MARK CHANGES PER SRC 2014-053	BW	CW
1	12/14/04	TRAFFIC SIGNAL UPGRADE FOR THIRD STREET LIGHT RAIL	DY	AH
NO.	DATE	DESCRIPTION	BY	APP.

TABLE OF REVISIONS
CHECK WITH TRACING TO SEE IF YOU HAVE LATEST REVISION

COMPLETION DATE /
ELECTRICIAN INITIAL

DEPARTMENT OF PARKING AND TRAFFIC
DIVISION OF TRAFFIC ENGINEERING
CITY AND COUNTY OF SAN FRANCISCO

DRAWN: DATE: SCALE:
DY 6/06 1:200

CHECKED: DATE: SHEET OF SHEETS
OF

TRAFFIC SIGNAL INVENTORY DIAGRAM

TRAFFIC SIGNAL PLAN
3RD ST AND LA SALLE AVE INTERSECTION

CNN NO.
20224000

REV. NO.
2