



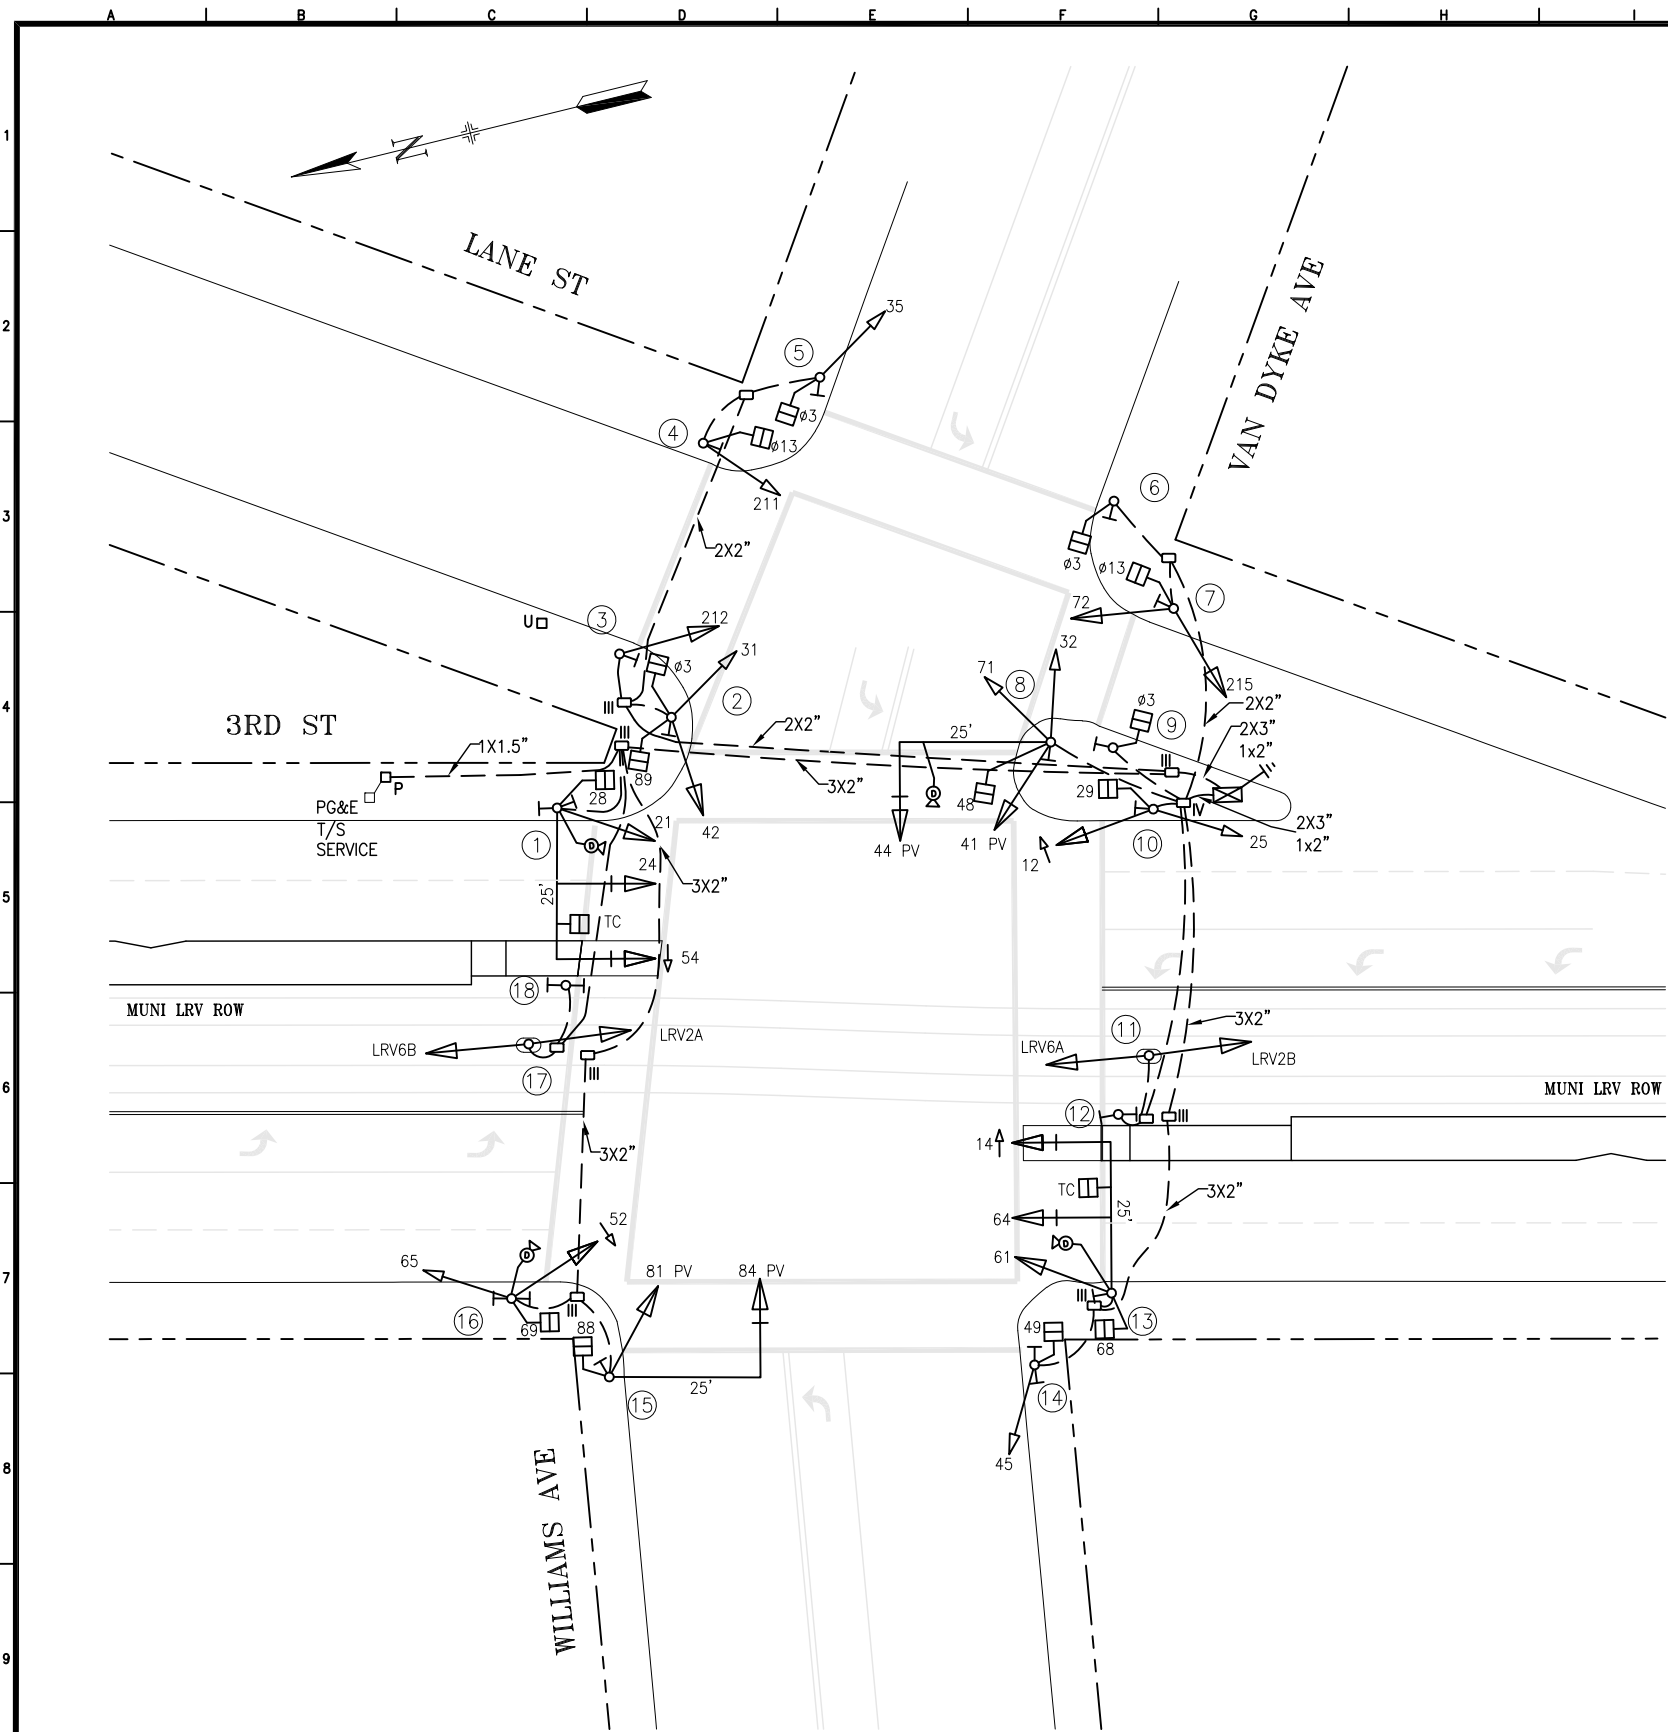

POLE AND EQUIPMENT SCHEDULE									
POLE No.	TYPE OF POLE	LUMINAIRE (HPS)	VEHICLE SIGNAL			PEDESTRIAN SIGNAL			REMARKS
		VOLTAGE/ WATTS	No.	TYPE	MOUNTING (F/I)	No.	TYPE	MOUNTING (F/I)	
①	MUNI COMBO POLE WITH 25' MAST ARM		54 21 24 TC	3S12" LA 3S12" LA 3S12" LA 1S 24" x 24"	MAS SV-1-T MAS PELCO	28	1S-C	SP-1	APS x2 DETAIL 'E'; T-23 VIDEO DETECTION CAMERA
②	STREET LIGHT		31 42	3S8" 3S12"	SV-2-TA	89 ø3	1S-C 1S-C	SP-2-T	APS
③	TYPE 1-A (10')		212	3S12"	TV-1-T				APS
④	TYPE 1-A (10')		211	3S8"	TV-1	ø13	1S-C	SP-1	APS
⑤	TYPE 1-A (10')		35	3S8"	TV-1	ø3	1S-C	SP-1	APS
⑥	TYPE 1-A (7')					ø3	1S-C	TP-1	APS
⑦	TYPE 1-A (10')		215 72	3S12" 3S12" R,Y,Y	TV-2-T-SFA	ø13	1S-C	SP-1	APS
⑧	18-2-129 WITH 25' MAST ARM		44 41 71 32	3S12" PV 3S12" PV 3S8" R,Y,Y 3S8"	MAS SV-3-T	48	1S-C	SP-1	APS VIDEO DETECTION CAMERA
⑨	TYPE 1-A (7')					ø3	1S-C	TP-1	APS
⑩	MUNI COMBO POLE		25 12	3S8" 3S12" LA	SV-2-TA	29	1S-C	SP-1	APS
⑪	TYPE 1-A (12')		LRV2B LRV6A	2S12"LB - 2S12"LB -	TV-2-T				
⑫	PPB POST								APS x2 POLE LOCATION, REFER TO ST DRAWINGS
⑬	MUNI COMBO POLE WITH 25' MAST ARM		61 64 14 TC	3S12" 3S12" 3S12" LA 1S 24" x 24"	SV-1-T MAS MAS PELCO	68	1S-C	SP-1	APS DETAIL 'E'; T-23 VIDEO DETECTION CAMERA
⑭	STREET LIGHT		45	3S8"	SV-1-T	49	1S-C	SP-1	APS x2
⑮	18-2-129 WITH 25' MAST ARM		81 84	3S12" PV 3S12" PV	SV-1-T MAS	88	1S-C	SP-1	APS
⑯	MUNI COMBO POLE		65 52	3S8" 3S12" LA	SV-2-TA	69	1S-C	SP-1	APS x2 VIDEO DETECTION CAMERA
⑰	TYPE 1-A (12')		LRV2A LRV6B	2S12"LB - 2S12"LB -	TV-2-T				
⑱	PPB POST								APS x2 POLE LOCATION, REFER TO ST DRAWINGS

NOTE:
CABINET FOUNDATION TYPE: M-SF

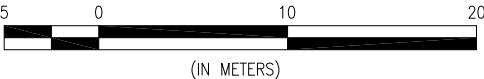

NO.	DATE	DESCRIPTION	BY	APPROVED
4	8/30/23	PER SRC 2023-075: ADD EXTRA APS ON SOME POLES	DYeung	GdeLeon
3	10/4/22	UPDATE PER FIELD: UPDATE TO APS & 1S-C. 212, 215 & 72 IS 12-INCH. MOVE VDC FROM 2 TO 8. NO BP (12 & 52). UPDATE TC	DYeung	GdeLeon
2	2/17/14	PER SRC 2014-028: REMOVE SIGNAL 13 & 53. CHANGE LRV SIGNALS FROM "T" TO LUNAR BARS.	CWong	BWoo
1	6/22/05	TRAFFIC SIGNAL UPGRADE FOR THIRD STREET LIGHT RAIL	DYeung	AHerce

TABLE OF REVISIONS
CHECKOUT DRAWING THROUGH THE SID CUSTODIAN FOR THE LATEST REVISION



SFMTA

DRAWN BY:	DATE:
DYeung	6/06
CHECKED BY:	DATE:

SCALE
1:200
SHEET OF SHEETS
1 OF 1

TRAFFIC SIGNAL INVENTORY DIAGRAM
TRAFFIC SIGNAL PLAN 3RD ST AND LANE/VAN DYKE/WILLIAMS

CNN NO:
20504000
REV NO:
4