


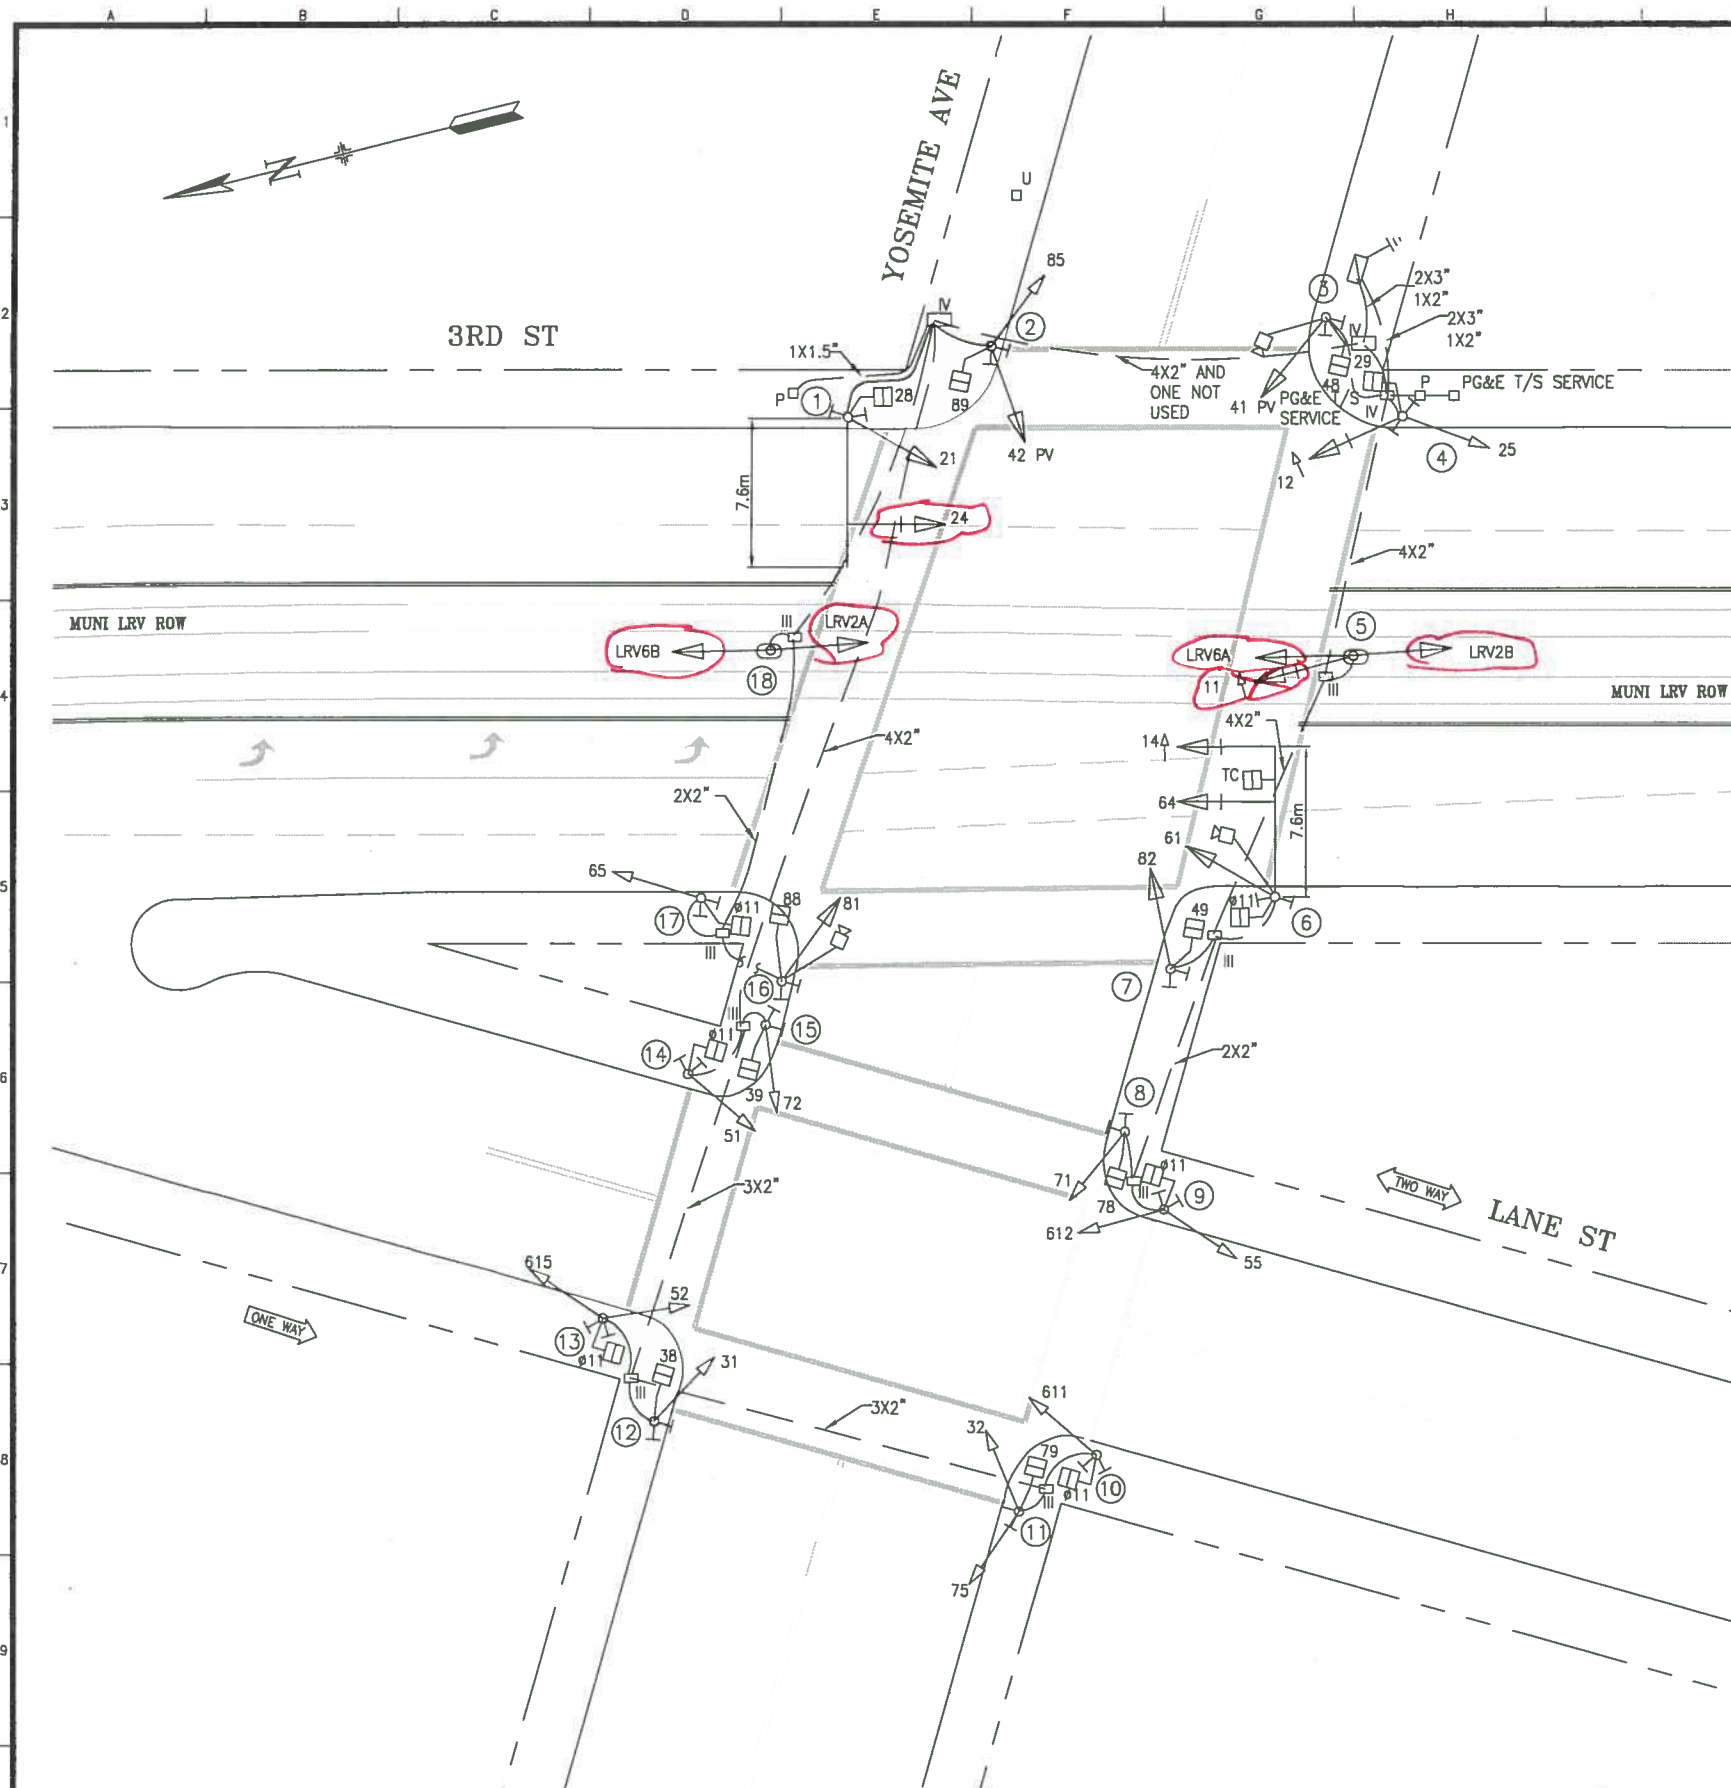

POLE AND EQUIPMENT SCHEDULE									
POLE No.	TYPE OF POLE	LUMINAIRE (HPS) VOLTAGE/ WATTS	VEHICLE SIGNAL			PEDESTRIAN SIGNAL			REMARKS
			No.	TYPE	MOUNTING (F/I)	No.	TYPE	MOUNTING (F/I)	
①	MUNI COMBO POLE WITH 7.6m M.A.		21 24	3S12" 3S12" <i>GVA</i>	SV-1-T MAS	28	1S-LED	SP-1	PPB DETAIL 'F'; T-23
②	TYPE 1-A (3.05m)		85 42	3S8" 3S12" PV	TV-2-T	89	1S-LED	SP-1	PPB SEE DETAIL 'X'
③	STREET LIGHT		41	3S12" PV	SV-1-T	48	1S-LED	SP-1	PPB
④	MUNI COMBO POLE		25 12	3S8" 3S12" LA	SV-2-T	29	1S-LED	SP-1	PPB
⑤	TYPE 1-A (3.6m) <i>2S12" LB-1</i>		11 LRV6A LRV2B	3S12" LA 2S12" T 2S12" T	SV-T TV-2-T				3 SECTION VEHICULAR SIGNAL BELOW 2 SECTION LRV SIGNAL
⑥	MUNI COMBO POLE WITH 7.6m M.A.		61 64 14 TC	3S12" 3S12" LA 1S 16" x 16"	SV-1-T MAS MAS MAS	111	1S-LED	SP-1	PPB DETAIL 'E'; T-23
⑦	TYPE 1-A (3.05m)		82	3S12"	TV-1-T	49	1S-LED	SP-1	PPB
⑧	STREET LIGHT		71	3S8"	SV-1-T	78	1S-LED	SP-1	PPB
⑨	TYPE 1-A (3.05m)		55 612	3S8" R,Y,Y 3S8"	TV-2-T	111	1S-LED	SP-1	PPB
⑩	STREET LIGHT		611	3S8"	SV-1-T	111	1S-LED	SP-1	PPB
⑪	TYPE 1-A (3.05m)		75 32	3S8" 3S8"	TV-2-T	79	1S-LED	SP-1	PPB
⑫	TYPE 1-A (3.05m)		31	3S8"	TV-1	38	1S-LED	SP-1	PPB
⑬	STREET LIGHT		615 52	3S8" R,Y,Y 3S8" R,Y,Y	SV-2-T	111	1S-LED	SP-1	PPB
⑭	TYPE 1-A (3.05m)		51	3S8" R,Y,Y	TV-1	111	1S-LED	SP-1	PPB
⑮	TYPE 1-A (3.05m)		72	3S8"	TV-1	39	1S-LED	SP-1	PPB
⑯	STREET LIGHT		81	3S12"	SV-1-T	88	1S-LED	SP-1	PPB
⑰	MUNI POLE		65	3S8"	SV-1-T	111	1S-LED	SP-1	PPB
⑱	TYPE 1-A (3.6m)		LRV2A LRV6B	2S12" T 2S12" T	TV-2-T				

M.A. = MAST ARM

2S12" LB-1


NOTE:

CABINET FOUNDATION TYPE: M-SF



NO.	DATE	DESCRIPTION	BY	APP.
2	2/16/14	RED MARK CHANGES PER SRC 2014-019	BW	CW
1	6/13/05	TRAFFIC SIGNAL UPGRADE FOR THIRD STREET LIGHT RAIL	DY	AH
TABLE OF REVISIONS				
CHECK WITH TRACING TO SEE IF YOU HAVE LATEST REVISION				

COMPLETION DATE / ELECTRICIAN INITIAL
--

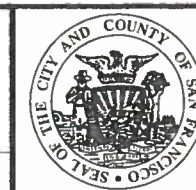

DEPARTMENT OF PARKING AND TRAFFIC
DIVISION OF TRAFFIC ENGINEERING
CITY AND COUNTY OF SAN FRANCISCO

DRAWN:	DATE:	SCALE:
DY	6/06	1:200
CHECKED:	DATE:	SHEET OF SHEETS
		OF

TRAFFIC SIGNAL INVENTORY DIAGRAM

TRAFFIC SIGNAL PLAN
3RD ST AND YOSEMITE AVE INTERSECTION

CNN NO.
20493000
REV. NO.
2