




VA = VAST ARM

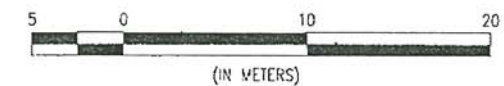

File 7/21/0

						SAN FRANCISCO MUNICIPAL TRANSPORTATION AGENCY TRANSPORTATION ENGINEERING CITY AND COUNTY OF SAN FRANCISCO		DRAWN: DATE: SCALE: KK/DY 12/05 1:200		TRAFFIC SIGNAL INVENTORY DIAGRAM 20467000		CITY NO.	
2 1/19/14 RED MARK CHANGES PER SRC 2013-327 BW CW 1 6/14/10 PER FIELD CHECK DC CH 0 2/2/05 3RD STREET LIGHT RAIL PROJECT - SEGMENT E CONTRACT NO. WR-1144 NO. DATE DESCRIPTION BY APP.				COMPLETION DATE / ELECTRICAL INITIAL		CHECKED: DATE: SHEET OF SHEETS		3RD ST AND LE CONTE AVE INTERSECTION		REV. NO.		X 2	