


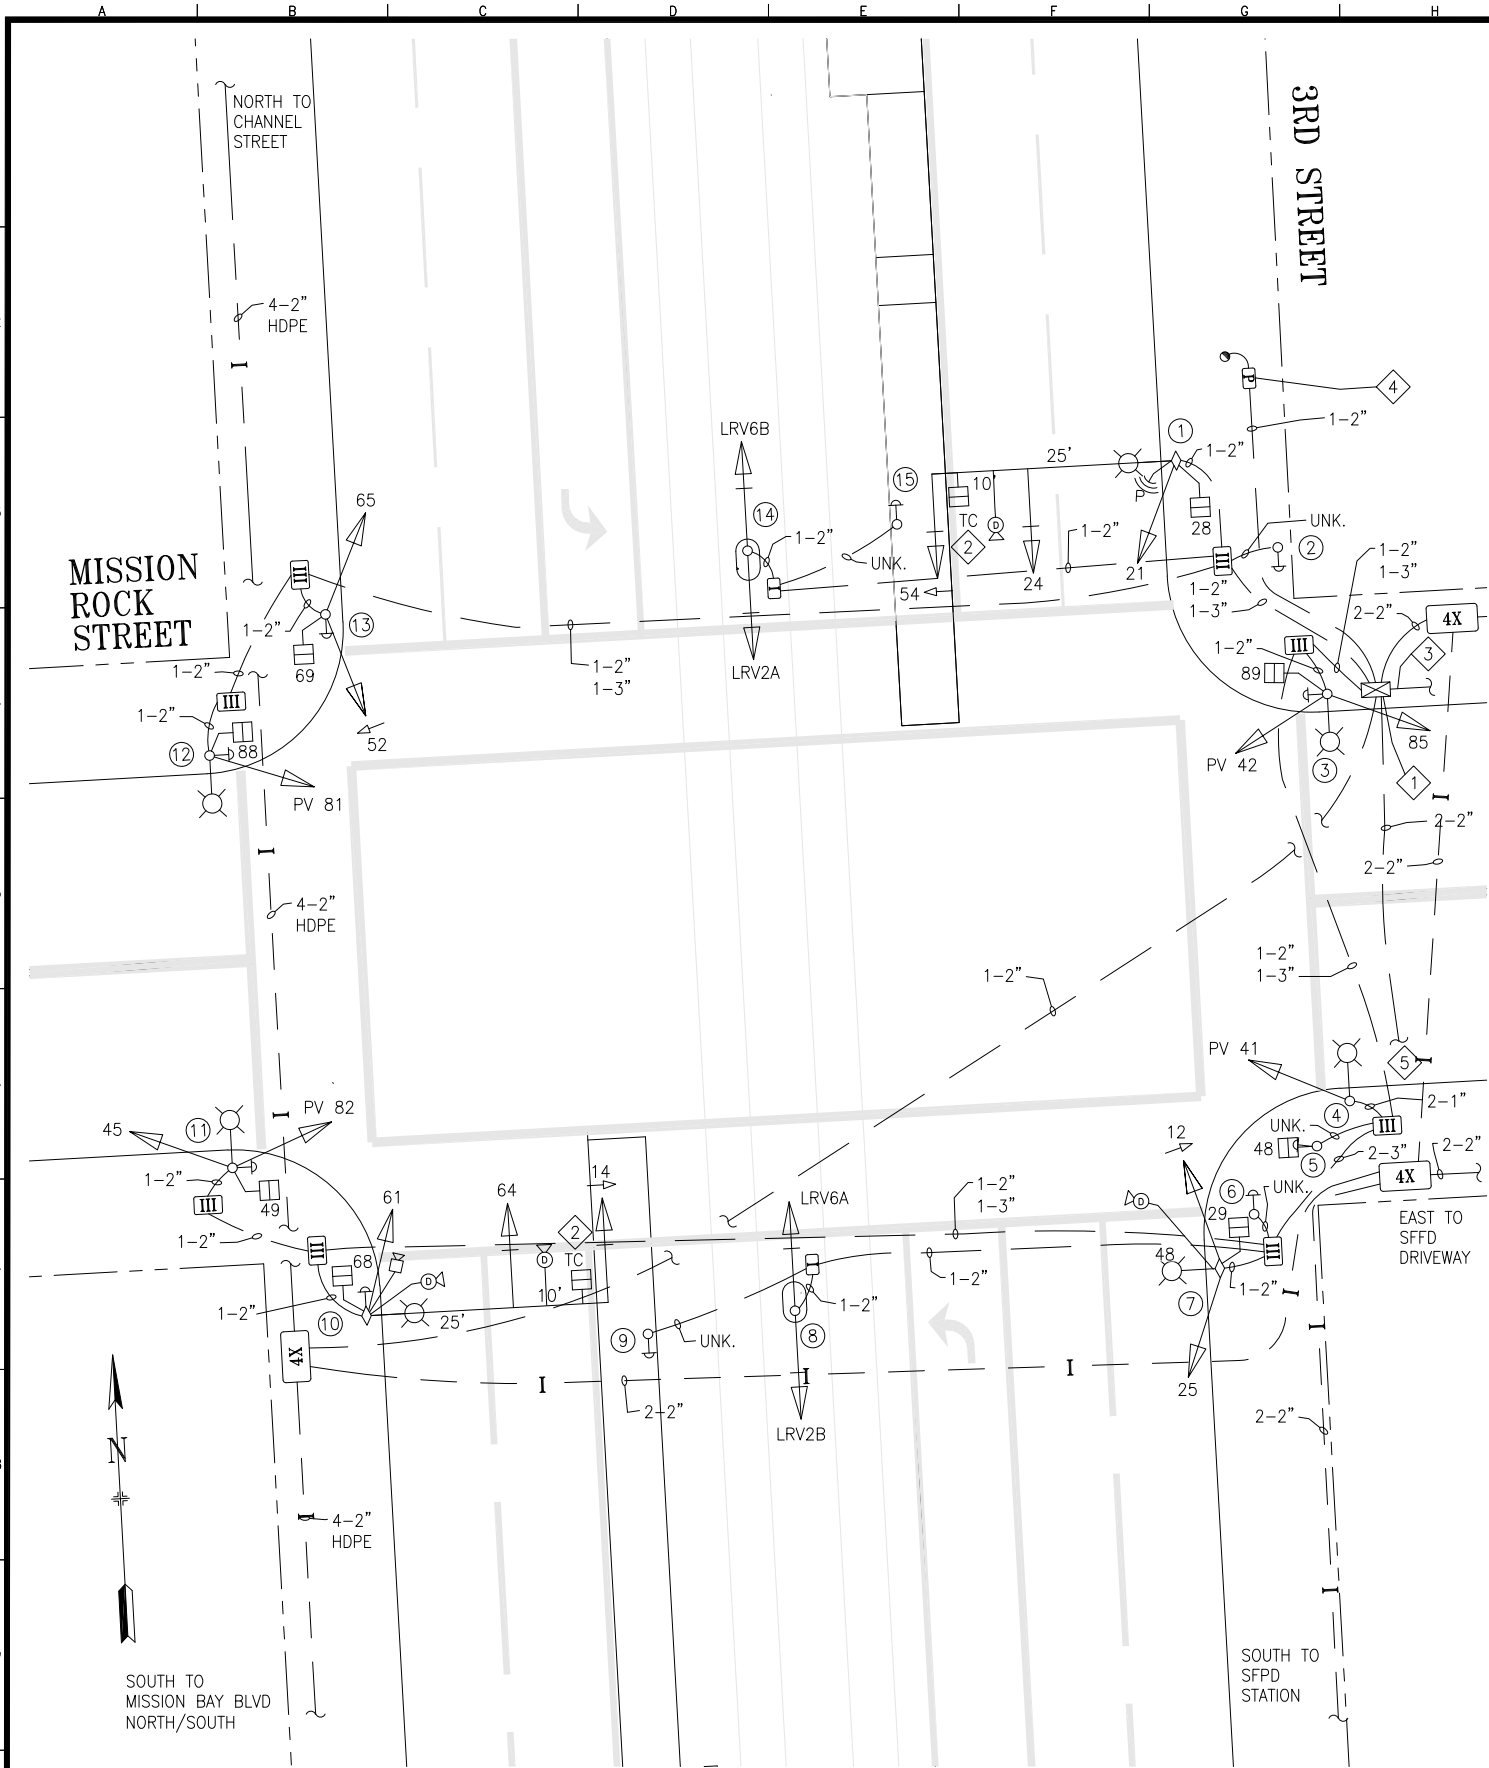

POLE AND EQUIPMENT SCHEDULE											
POLE No.	TYPE OF POLE	LUMINAIRE TYPE	VEHICLE SIGNAL					PEDESTRIAN SIGNAL			REMARKS
			No.	TYPE	MOUNTING	VISORS	LOUVERS/BP	No.	TYPE	MOUNTING	
①	MUNI COMBO POLE W/25' MAST ARM		21 24 54 TC	3S12" 3S12" 3S12"LA 1S 24"X24"	SV-1-T MAS MAS	T T T T	BP BP	28	1S-COUNT	SP-1	VIDEO DETECTION CAMERA PREEMPTION RADIO
②	PPB POLE										APS
③	MISSION BAY POLE		PV 42 85	3S12"PV 3S12"	SV-2-T	T T		89	1S-COUNT	SP-1	APS
④	MISSION BAY POLE		PV 41	3S12"PV	SV-1-T	T					
⑤	1-A (7')							48	1S-COUNT	SP-1	APS
⑥	PPB POLE										APS
⑦	MUNI COMBO POLE		12 25	3S12"LA 3S12"	SV-2-T	T T		29	1S-COUNT	SP-1	VIDEO DETECTION CAMERA
⑧	1-A (12')		LRV2B LRV6A	2S12"LB 2S12"LB	TV-2-T	T T	BP BP				
⑨	PPB POLE										APS
⑩	MUNI COMBO POLE W/25' MAST ARM		14 61 64 TC	3S12"LA 3S12" 3S12" 1S 24"X24"	MAS SV-1-T MAS	T T T T	BP BP	68	1S-COUNT	SP-1	APS VIDEO DETECTION CAMERA (2)
⑪	MSSION BAY POLE		45 PV 82	3S12" 3S12"PV	SV-2-T	T T		49	1S-COUNT	SP-1	APS
⑫	MISSION BAY POLE		PV 81	3S12"	SV-1-T	T		88	1S-COUNT	SP-1	APS
⑬	1-A (10')		52 65	3S12"LA 3S12"	TV-2-T	T T		69	1S-COUNT	SP-1	APS
⑭	1-A (12')		LRV2B LRV6A	2S12"LB 2S12"LB	TV-2-T	T T	BP BP				
⑮	PPB POLE										APS

SHEET NOTES:

- ① CABINET FOUNDATION TYPE: M-SF
- ② TC = TRAIN COMING
- ③ TO VTS LOOPS - SEE CONTRACT MR-1147, SHEET EL-08 FOR FURTHER DETAILS
- ④ IN-LINE FUSE HOLDER W/40A FUSE
- ⑤ TO SFFD STATION 4 - SEE MISSION BAY PROJECT: BLOCKS 8, 9 & 9A PHASE 2, SHEET E4.4 FOR FURTHER DETAILS

NO.	DATE	DESCRIPTION	BY	APPROVED
Δ	5/12/22	SRC 2021-171: INSTALLED 24"x24" FTCs ON POLES 1 & 10 AND PER FIELD	T. YOUNG	C. LIU
Δ	5/26/14	SRC 2014-100: DELETE SIGNALS 13 AND 53, INSTALL LUNAR BARS	B. WOO	C. WONG
Δ	12/14/05	TRAFFIC SIGNAL UPGRADE FOR THIRD STREET LIGHT RAIL CT#MR-1141	D. YEUNG	A. HERCE
NO.	DATE	DESCRIPTION	BY	APPROVED
TABLE OF REVISIONS				
CHECKOUT DRAWING THROUGH THE SID CUSTODIAN FOR THE LATEST REVISION				



SFMTA

DRAWN BY:	DATE:
T. YOUNG	6/2022
CHECKED BY:	DATE:
M. VELASCO	6/2022

SCALE
1" = 10'
SHEET OF SHEETS
1 OF 1

TRAFFIC SIGNAL INVENTORY DIAGRAM
3RD STREET & MISSION ROCK STREET

CNN NO:
20238000
REV NO:
3