




POLE AND EQUIPMENT SCHEDULE											
POLE No.	TYPE OF POLE	LUMINAIRE VOLTAGE/WATTAGE	VEHICLE SIGNAL					PEDESTRIAN SIGNAL			REMARKS
			No.	TYPE	MOUNTING	VISORS	LOUVERS/BP	No.	TYPE	MOUNTING	
①	16-1-70 W/ 8' MAST ARM		84	3S12"	MAS	T	BP				
②	MUNI		22 81 131	3S12" 3S12" 2S12"LB	SV-2-T-SF SV-1-T	T T T		88 69	1S-IN 1S-IN	SP-1 (22") SP-1-SF (12")	SFgo CCTV TSP
③	16-1-70 W/ 8' MAST ARM		24	3S12"	MAS	T	BP				BASEMENT COLUMN
④	MUNI							89	1S-IN	SP-1	EXTERNAL CONDUIT
⑤	MUNI							29	1S-IN	SP-1	
⑥	1-A (10')		62 25	3S12" 3S12"	TV-2-T-SF	T T		48	1S-IN	SP-1	
⑦	NOT USED										
⑧	MUNI 770 W/ 5' MA & 6' LUMINAIRE ARM	RFM 108W	61 64	3S12" 3S12"	SV-1-T MAC	T T	BP				
⑨	MUNI 770 W/ 5' MA & 6' LUMINAIRE ARM	RFM 108W	82 83 132	3S12" 3S12" 2S12"LB	SV-1-T MAC SV-1-T	T T T	BP	68 49	1S-IN 1S-IN	SP-1 SP-1	BASEMENT
⑩	MUNI		21	3S12"	SV-1-T	T		28	1S-IN	SP-1 (22")	

NO.	DATE	DESCRIPTION	BY	APPROVED
1	10/21/20	SRC 2020-005: ADD 131&132, UPGRADE SIGNALS TO 12". PER FIELD/706 MISSION AS-BUILT: VEH/PED SIGNAL ADJUSTMENTS ON WMC	HYu	KKwong
0	10/29/03	SIGNAL UPGRADE BY 1663NR, CONVERTED FROM AS-BUILTS	HYu	KKwong
TABLE OF REVISIONS				
CHECKOUT DRAWING THROUGH THE SID CUSTODIAN FOR THE LATEST REVISION				

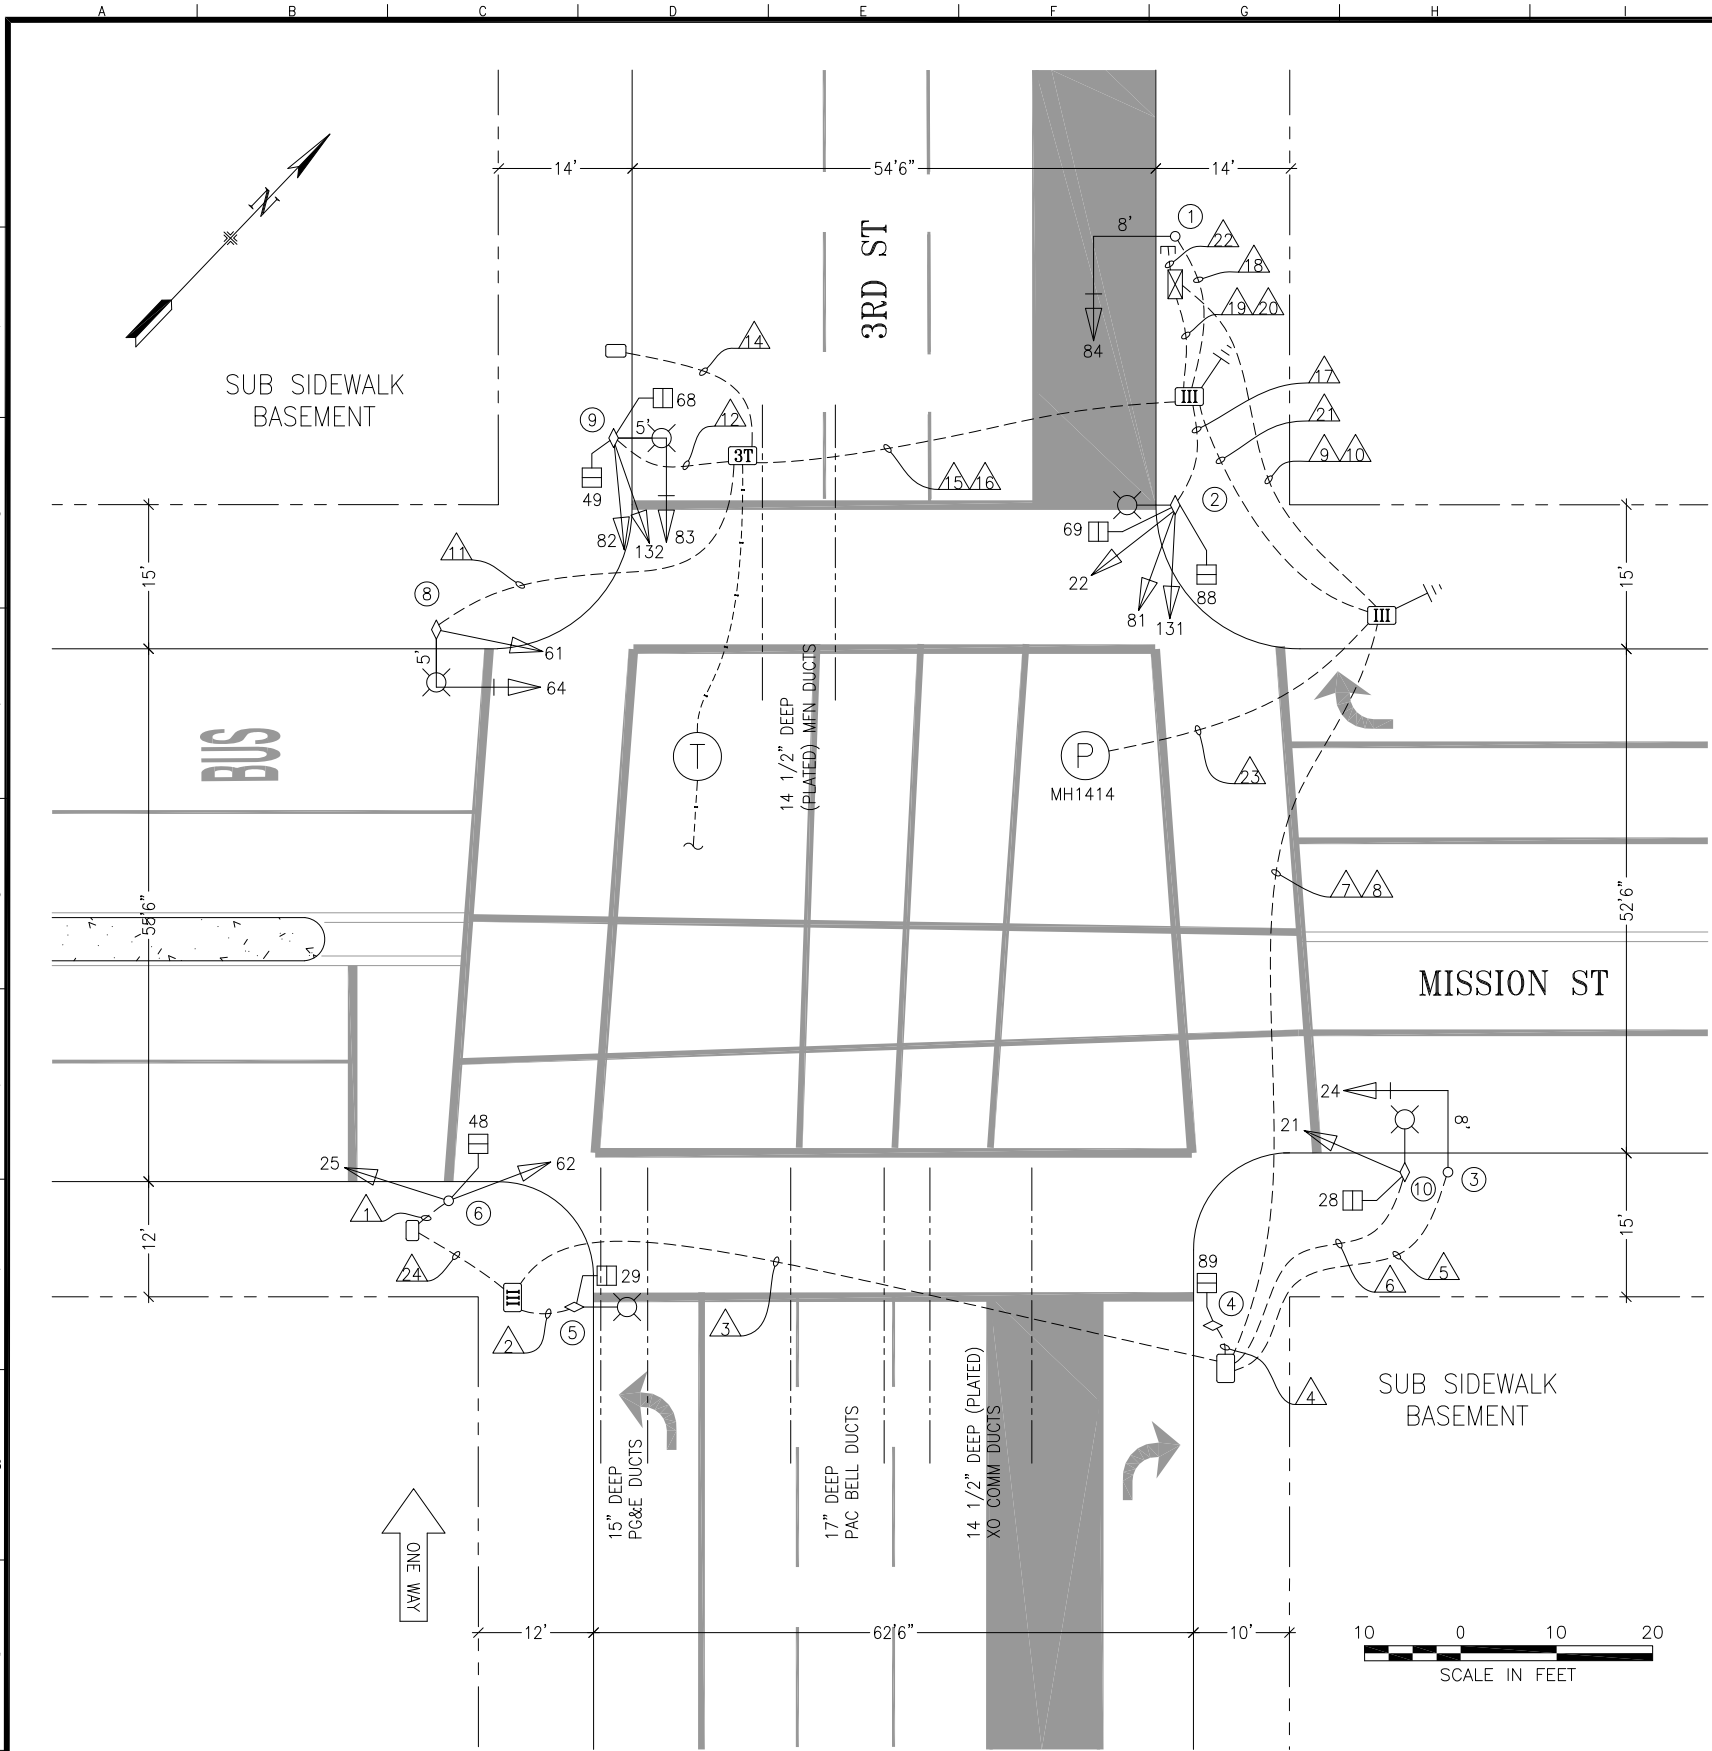

SFMTA

DRAWN BY:	DATE:
HYu	9/2019
CHECKED BY:	DATE:
KKwong	11/2020

SCALE
AS SHOWN
SHEET OF SHEETS
1 OF 2

TRAFFIC SIGNAL INVENTORY DIAGRAM
3RD STREET AND MISSION STREET

CNN NO:
24613000
REV NO:
1

