


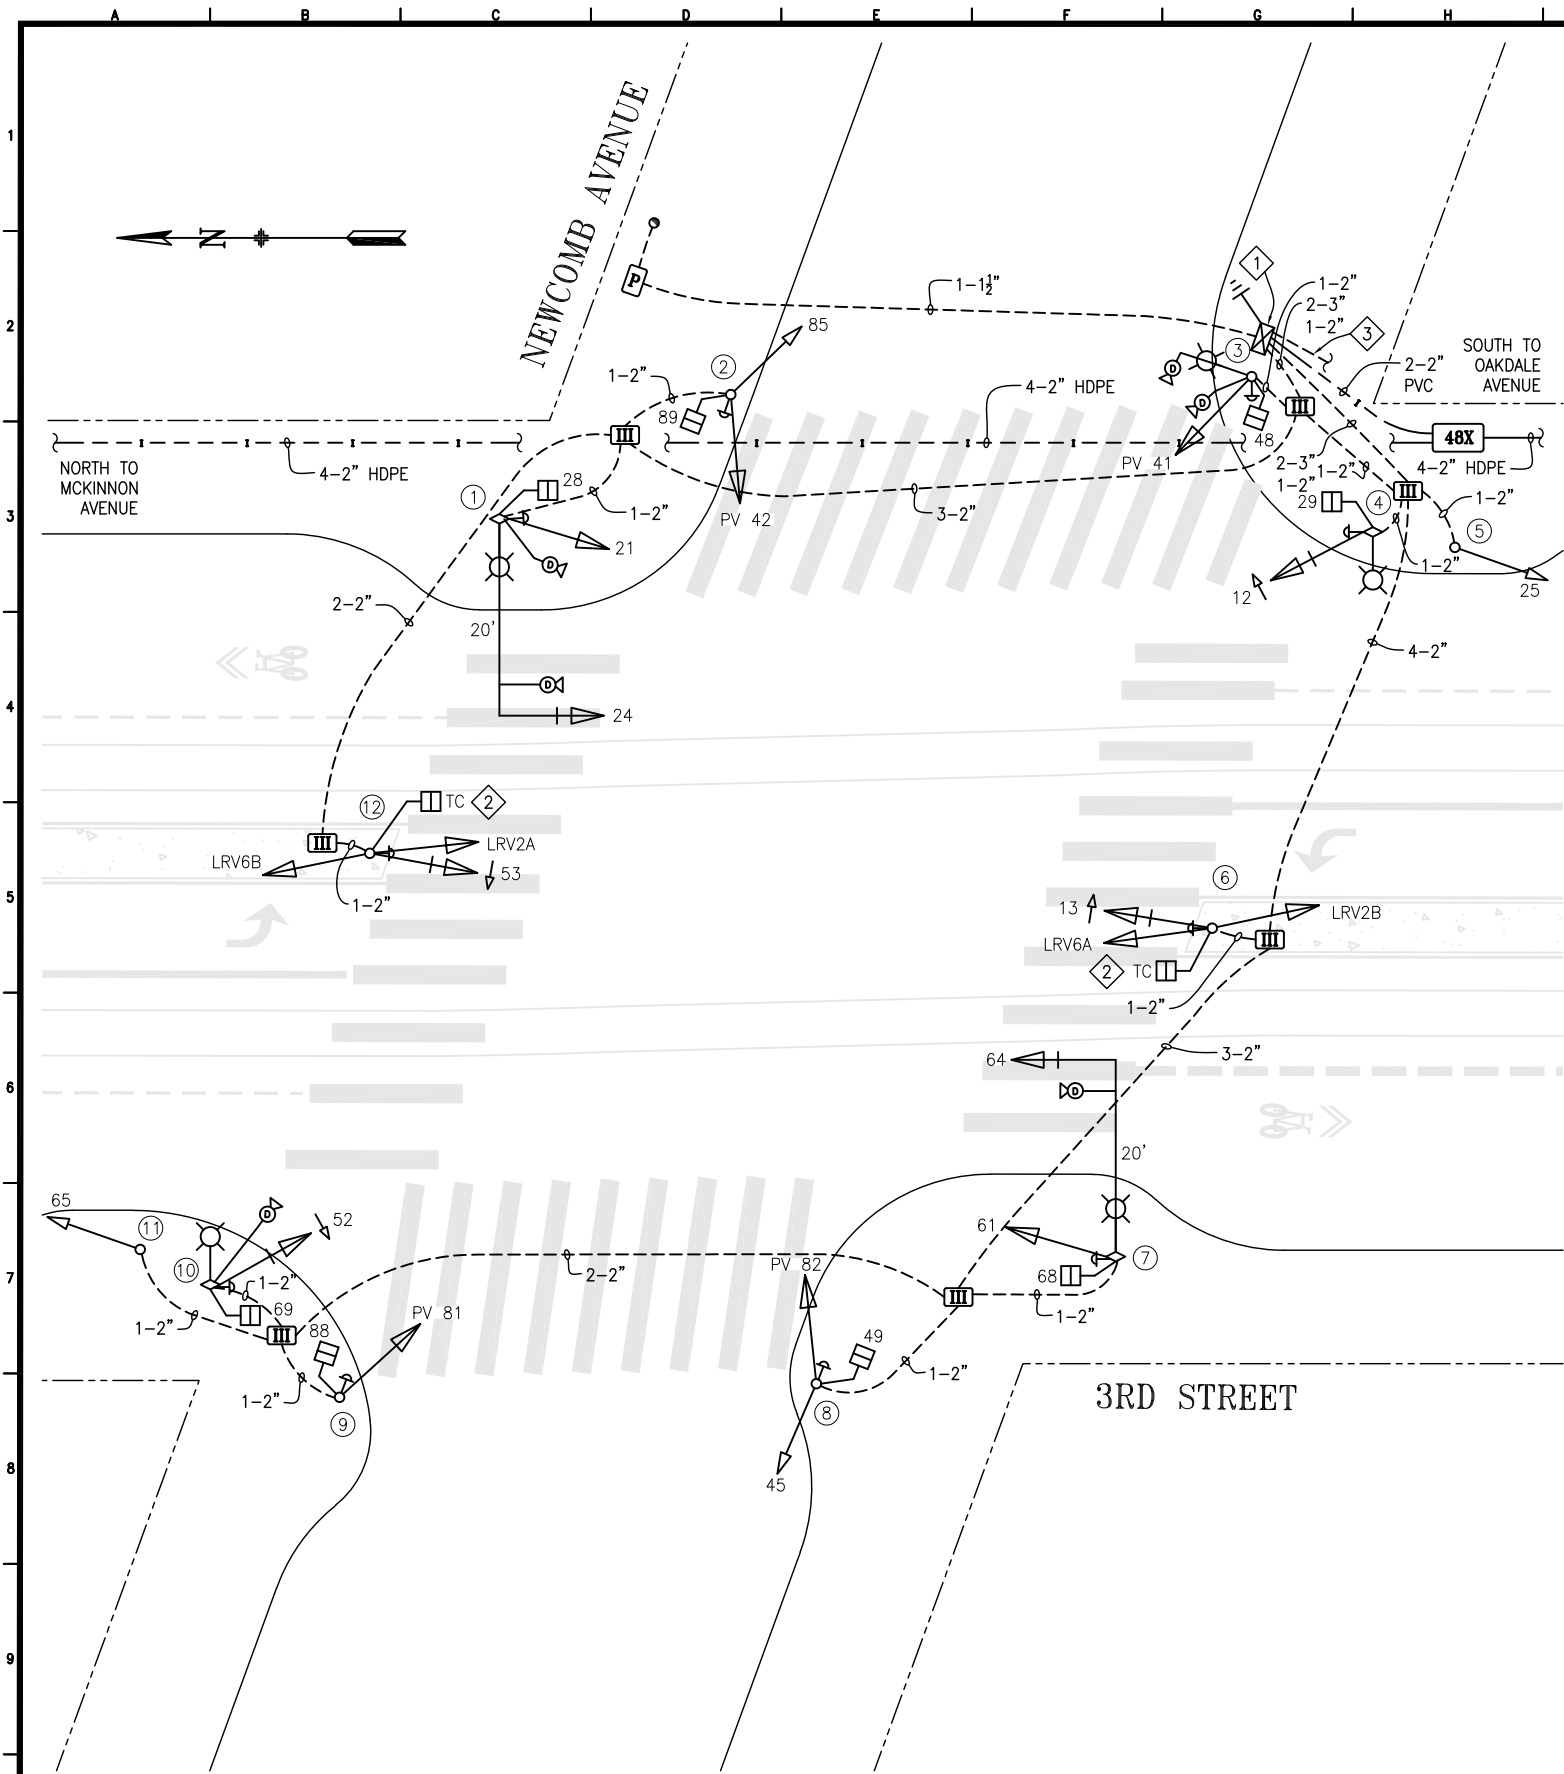

POLE AND EQUIPMENT SCHEDULE											
POLE No.	TYPE OF POLE	LUMINAIRE TYPE	VEHICLE SIGNAL					PEDESTRIAN SIGNAL			REMARKS
			No.	TYPE	MOUNTING	VISORS	LOUVERS/BP	No.	TYPE	MOUNTING	
①	MUNI COMBO POLE W/20' MAST ARM		21 24	3S12" 3S12"	SV-1-T MAS	T T	BP	28	1S-COUNT	SP-1	APS DETECTION CAMERA 
②	1-A (10')		PV 42 85	3S12"PV 3S8"	TV-2-T	T T		89	1S-COUNT	SP-1	APS
③	STREETLIGHT POLE		PV 41	3S12"PV	SV-1-T	T		48	1S-COUNT	SP-1	APS DETECTION CAMERA
④	MUNI COMBO POLE		12	3S12"LA	SV-1-T	T		29	1S-COUNT	SP-1	APS
⑤	1-A (10')		25	3S8"	TV-1	T					
⑥	1-A (15')		13 TC LRV2B LRV6A	3S12"LA 1S 24"X24" 2S12"LB 2S12"LB	SV-1 SV-1 TV-2-T	T T T T					APS W/SIGN ()
⑦	MUNI COMBO POLE W/20' MAST ARM		61 64	3S12" 3S12"	SV-1-T MAS	T T	BP	68	1S-COUNT	SP-1	APS DETECTION CAMERA 
⑧	1-A (10')		45 PV 82	3S8" 3S12"PV	TV-2-T	T T		49	1S-COUNT	SP-1	APS
⑨	1-A (10')		PV 81	3S12"PV	TV-1-T	T		88	1S-COUNT	SP-1	APS
⑩	MUNI COMBO POLE		52	3S12"LA	SV-T-T	T		69	1S-COUNT	SP-1	APS DETECTION CAMERA
⑪	1-A (10')		65	3S8"	TV-1	T					
⑫	1-A (15')		53 TC LRV2A LRV6B	3S12"LA 1S 24"X24" 2S12"LB 2S12"LB	SV-1 SV-1 TV-2-T	T T T T					APS W/SIGN ()

SHEET NOTES:

- ① CABINET FOUNDATION TYPE: M-SF
- ② TC = TRAIN COMING
- ③ TO VTS LOOPS – SEE CONTRACT MR-1147, SHEET EL-51 FOR FURTHER DETAILS
- ④ SEE DETAIL 'C', CONTRACT MR-1143, DRAWING T-22 FOR MAST ARM DETAILS

NO.	DATE	DESCRIPTION	BY	APPROVED
Δ	5/12/22	SRC 2021-171: INSTALLED 24"X24" FTCs ON POLES 6 & 12	T. YOUNG	C. LIU
Δ	3/16/14	SRC 2014-028: INSTALL LUNAR BARS, DELETE SIGNALS 17 AND 57	B. WOO	C. WONG
Δ	3/12/05	TRAFFIC SIGNAL UPGRADE FOR THIRD STREET LIGHT RAIL	D. YEUNG	A. HERCE

TABLE OF REVISIONS
CHECKOUT DRAWING THROUGH THE SID CUSTODIAN FOR THE LATEST REVISION



SFMTA

DRAWN BY: T. YOUNG	DATE: 6/2022
CHECKED BY: C. LIU	DATE: 6/2022

SCALE 1" = 10'
SHEET OF SHEETS 1 OF 1

TRAFFIC SIGNAL INVENTORY DIAGRAM
3RD STREET & NEWCOMB AVENUE

CNN NO: 20660000
REV NO: 3