


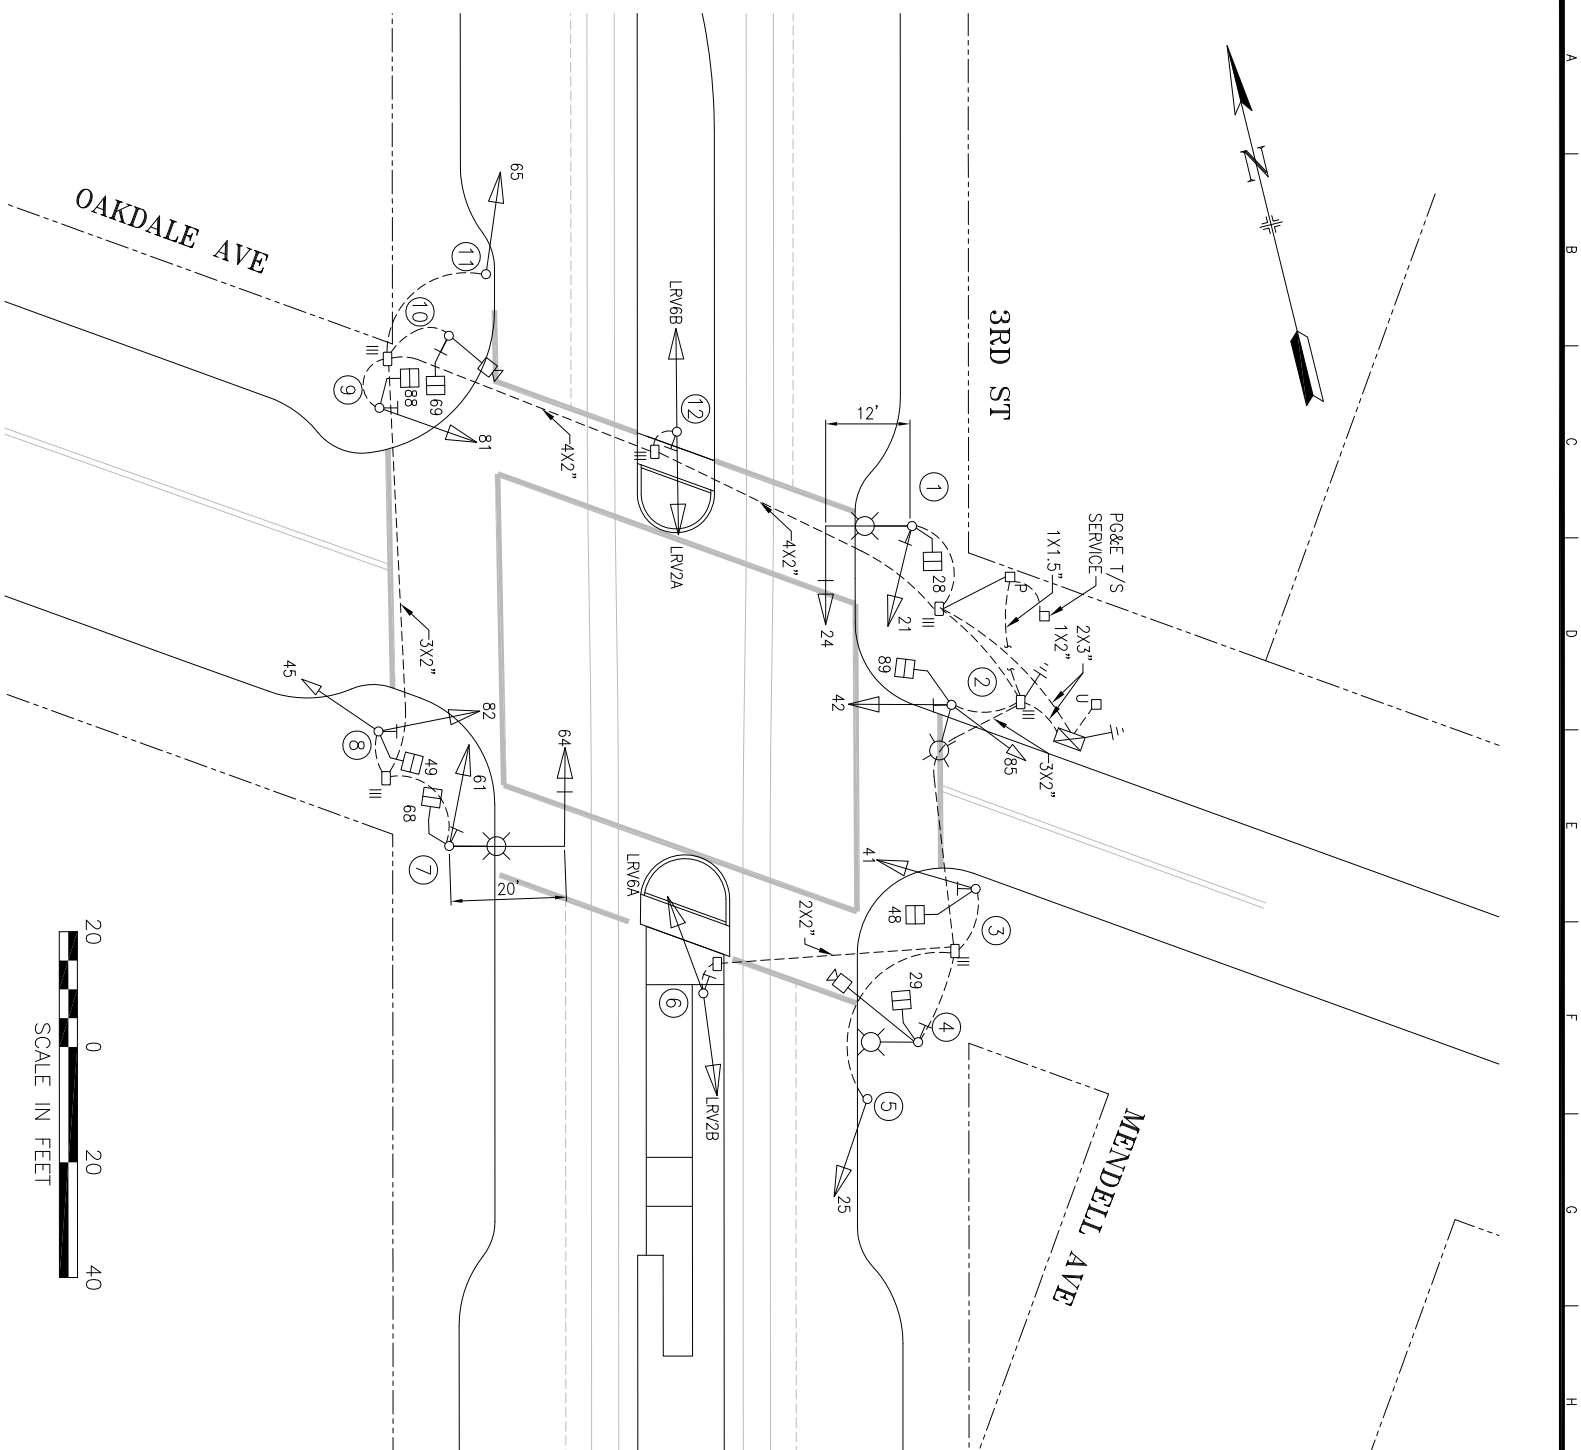

POLE AND EQUIPMENT SCHEDULE									
POLE No.	TYPE OF POLE	LUMINAIRE (HPS)	VEHICLE SIGNAL			PEDESTRIAN SIGNAL			REMARKS
		VOLTAGE/ WATTS	No.	TYPE	MOUNTING (F/I)	No.	TYPE	MOUNTING (F/I)	
(1)	MUNI COMBO POLE WITH 12 M.A.		24 21	3S12"GA 3S12"	MAS SV-1-T	28	1S-COUNT	SP-1	APS
(2)	STREET LIGHT		42 85	3S12" 3S8"	SV-2-T	89	1S-COUNT	SP-1	APS
(3)	TYPE 1-A (10')		41	3S12"	TV-1-T	48	1S-COUNT	SP-1	APS
(4)	MUNI COMBO POLE					29	1S-COUNT	SP-1	APS
(5)	TYPE 1-A (10')		25	3S12"	TV-1-T				
(6)	TYPE 1-A (15')		LR/28 LRV6A	2S12" LB- 2S12" LB-	TV-2-T				APS
(7)	MUNI COMBO POLE WITH 20' M.A.		61 64	3S12" 3S12"GA	SV-1-T MAS	68	1S-COUNT	SP-1	APS
(8)	TYPE 1-A (10')		45 82	3S8" 3S12"	TV-2-T	49	1S-COUNT	SP-1	APS
(9)	TYPE 1-A (10')		81	3S12"	TV-1-T	88	1S-COUNT	SP-1	APS
(10)	MUNI COMBO POLE					69	1S-COUNT	SP-1	APS
(11)	TYPE 1-A (10')		65	3S12"	TV-1-T				
(12)	TYPE 1-A (15')		LR/28 LRV6A	2S12" LB- 2S12" LB-	TV-2-T				APS

M.A. = MAST ARM

NOTE:

CABINET FOUNDATION TYPE: M-SF

4	6/2/17	65 REPLACED WITH 3512T PER FIELD	JH	GD	
3	4/9/16	25 REPLACED WITH 3512T AFTER ANNOYANCE, PMS, AAS PER FIELD	JH	GD	
2	3/3/14	LUNA BASS SIGNAL, 24684 GMA, REMO 23 PER SMC 2014-025	BY	CW	
1	12/2/04	TRAFFIC SIGNAL UPGRADE FOR THIRD STREET LIGHT RAIL	DT	AP	
NO.	DATE	DESCRIPTION	BY	APP.	
TABLE OF REVISIONS CHECK WITH TRACING TO SEE IF YOU HAVE LATEST REVISION					

REFERENCE INFORMATION
& FILE NO. OF SURVEYS



**SAN FRANCISCO MUNICIPAL TRANSPORTATION AGENCY
CITY AND COUNTY OF SAN FRANCISCO**

DRAWN:	DATE:
BY	6/06
CHECKED:	DATE:

SCALE:

TRAFFIC SIGNAL INVENTORY DIAGRAM

CNN NO.

20659000

3RD STREET AND OAKDALE AVENUE

4