



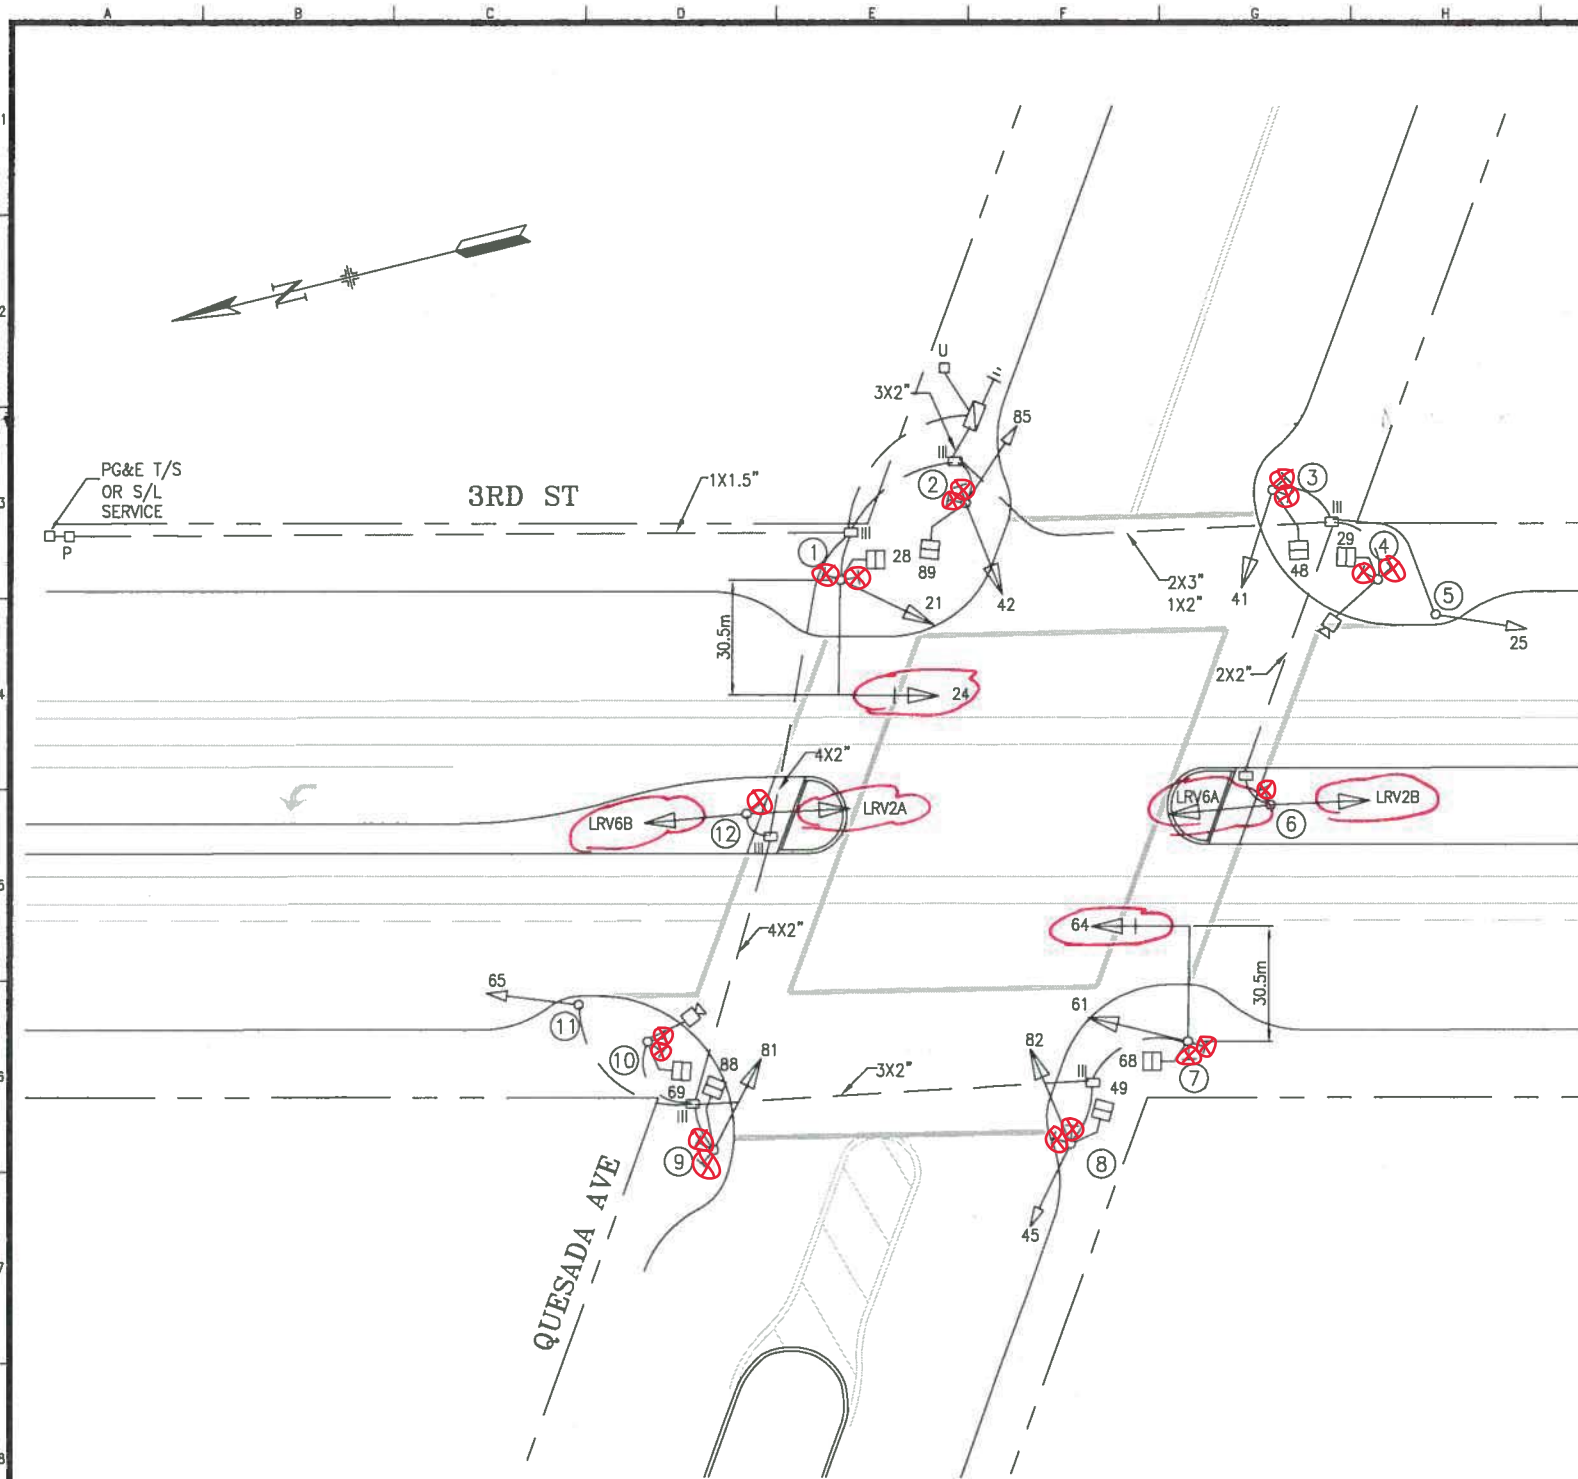

POLE AND EQUIPMENT SCHEDULE								
POLE No.	TYPE OF POLE	LUMINAIRE (HPS)	VEHICLE SIGNAL			PEDESTRIAN SIGNAL		REMARKS
		VOLTAGE/ WATTS	No.	TYPE	MOUNTING (F/I)	No.	TYPE	
①	MUNI COMBO POLE WITH 6.1m M.A.		24 21	3S12" <i>QVA</i> 3S12"	MAS SV-1-T	28	1S-LED	PPB DETAIL 'C'; T-22
②	STREET LIGHT		42 85	3S12" 3S8"	SV-2-T	89	1S-LED	PPB
③	TYPE 1-A (3.05m)		41	3S12"	TV-1-T	48	1S-LED	PPB
④	MUNI COMBO POLE					29	1S-LED	PPB
⑤	TYPE 1-A (3.05m)		25	3S8"	TV-1			
⑥	TYPE 1-A (4.57m)		LRV2B LRV6A	<i>2S12" LB-1</i> 2S12" T 2S12" T	TV-2-T			PPB W/ SIGNS (---)
⑦	MUNI COMBO POLE WITH 6.1m M.A.		61 64	3S12" 3S12" <i>QVA</i>	SV-1-T MAS	68	1S-LED	PPB DETAIL 'C'; T-22
⑧	STREET LIGHT		82 45	3S12" 3S8"	SV-2-T	49	1S-LED	PPB
⑨	TYPE 1-A (3.05m)		81	3S12"	TV-1-T	88	1S-LED	PPB
⑩	MUNI COMBO POLE					69	1S-LED	PPB
⑪	TYPE 1-A (3.05m)		65	3S8"	TV-1			
⑫	TYPE 1-A (4.57m)		LRV2A LRV6B	<i>2S12" LB-1</i> 2S12" T 2S12" T	TV-2-T			PPB W/ SIGNS (---)

NOTE:
CABINET FOUNDATION TYPE: M-SF

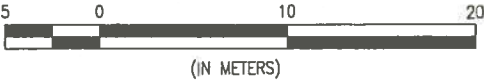

3	9/11/18	REMOVE ALL PPB FOR ALL CROSSINGS		AL	CW
2	2/23/14	RED MARK CHANGES PER SRC 2014-028		BW	CW
1	12/16/04	TRAFFIC SIGNAL UPGRADE FOR THIRD STREET LIGHT RAIL		DY	AH
NO.	DATE	DESCRIPTION		BY	APP.
TABLE OF REVISIONS					
CHECK WITH TRACING TO SEE IF YOU HAVE LATEST REVISION					



DEPARTMENT OF PARKING AND TRAFFIC

DIVISION OF TRAFFIC ENGINEERING

CITY AND COUNTY OF SAN FRANCISCO

COMPLETION DATE /
ELECTRICIAN INITIAL

DRAWN: DATE: SCALE:	TRAFFIC SIGNAL INVENTORY DIAGRAM		CNN NO.
DY 6/06 1:200			20496000
CHECKED: DATE: SHEET OF SHEETS	TRAFFIC SIGNAL PLAN		REV. NO.
OF	3RD ST AND QUESADA AVE INTERSECTION		<i>X</i> 3

FILE:Signal_Inventory\As-Built\DWG\3rd St\Seg D0331 Quesada 04216 SID.dwg, Layout1, 12/26/2007 11:55:54 AM, CLEUNG2