


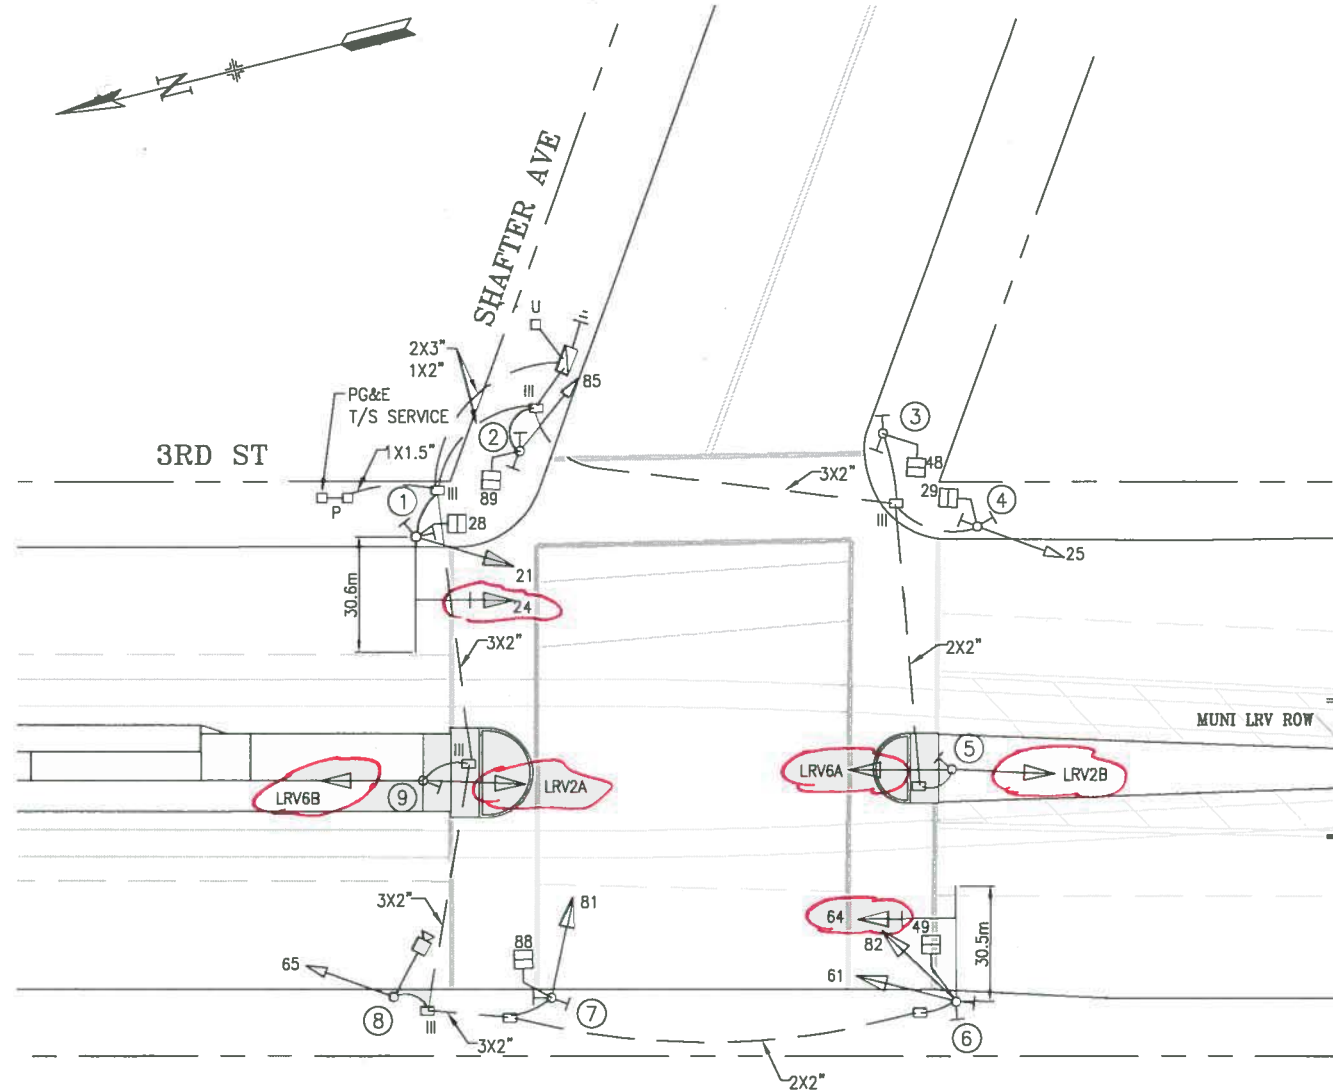

NOTE:
CABINET FOUNDATION TYPE: M-SF

POLE AND EQUIPMENT SCHEDULE									
POLE No.	TYPE OF POLE	LUMINAIRE (HPS)	VEHICLE SIGNAL			PEDESTRIAN SIGNAL			REMARKS
		VOLTAGE/ WATTS	No.	TYPE	MOUNTING (F/I)	No.	TYPE	MOUNTING (F/I)	
①	MUNI COMBO POLE WITH 6.1m M.A.		21 24	3S12" 3S12" <i>GUA</i>	SV-1-T MAS	28	1S-LED	SP-1	PPB DETAIL 'C'; T-22
②	TYPE 1-A (3.05m)		85	3S8"	TV-1	89	1S-LED	SP-1	PPB
③	STREET LIGHT					48	1S-LED	SP-1	PPB
④	MUNI COMBO POLE		25	3S8"	SV-1-T	29	1S-LED	SP-1	PPB
⑤	TYPE 1-A (3.6m)		LRV2B LRV6A	2S12" T 2S12" T	TV-2-T				PPB W/ SIGNS (---)
⑥	MUNI COMBO POLE WITH 6.1m M.A.		64 61 82	3S12" <i>GUA</i> 3S12" 3S12"	MAS SV-2-T	49	1S-LED	SP-1	PPB DETAIL 'C'; T-22
⑦	TYPE 1-A (3.05m)		81	3S12"	TV-1-T				
⑧	MUNI COMBO POLE		65	3S8"	SV-1-T				
⑨	TYPE 1-A (3.6m)		LRV2A LRV6B	2S12" T 2S12" T	TV-2-T				PPB W/ SIGNS (---) POLE LOCATION; REFER TO ST DRAWINGS

M.A. = MAST ARM



2 2/23/14 RED MARK CHANGES PER SRC 2014-028		BW	CW	
1 5/24/05	TRAFFIC SIGNAL UPGRADE FOR THIRD STREET LIGHT RAIL	DY	AH	
NO.	DATE	DESCRIPTION	BY	APP.
TABLE OF REVISIONS				
CHECK WITH TRACING TO SEE IF YOU HAVE LATEST REVISION				
COMPLETION DATE / ELECTRICIAN INITIAL				
				
DEPARTMENT OF PARKING AND TRAFFIC				
DIVISION OF TRAFFIC ENGINEERING				
CITY AND COUNTY OF SAN FRANCISCO				
DRAWN:	DATE:	SCALE:	TRAFFIC SIGNAL INVENTORY DIAGRAM	
KK	6/06	1:200	20500000	
CHECKED:	DATE:	SHEET OF SHEETS	TRAFFIC SIGNAL PLAN	
		OF	3RD ST AND SHAFTER AVE INTERSECTION	
REV. NO. 2				