



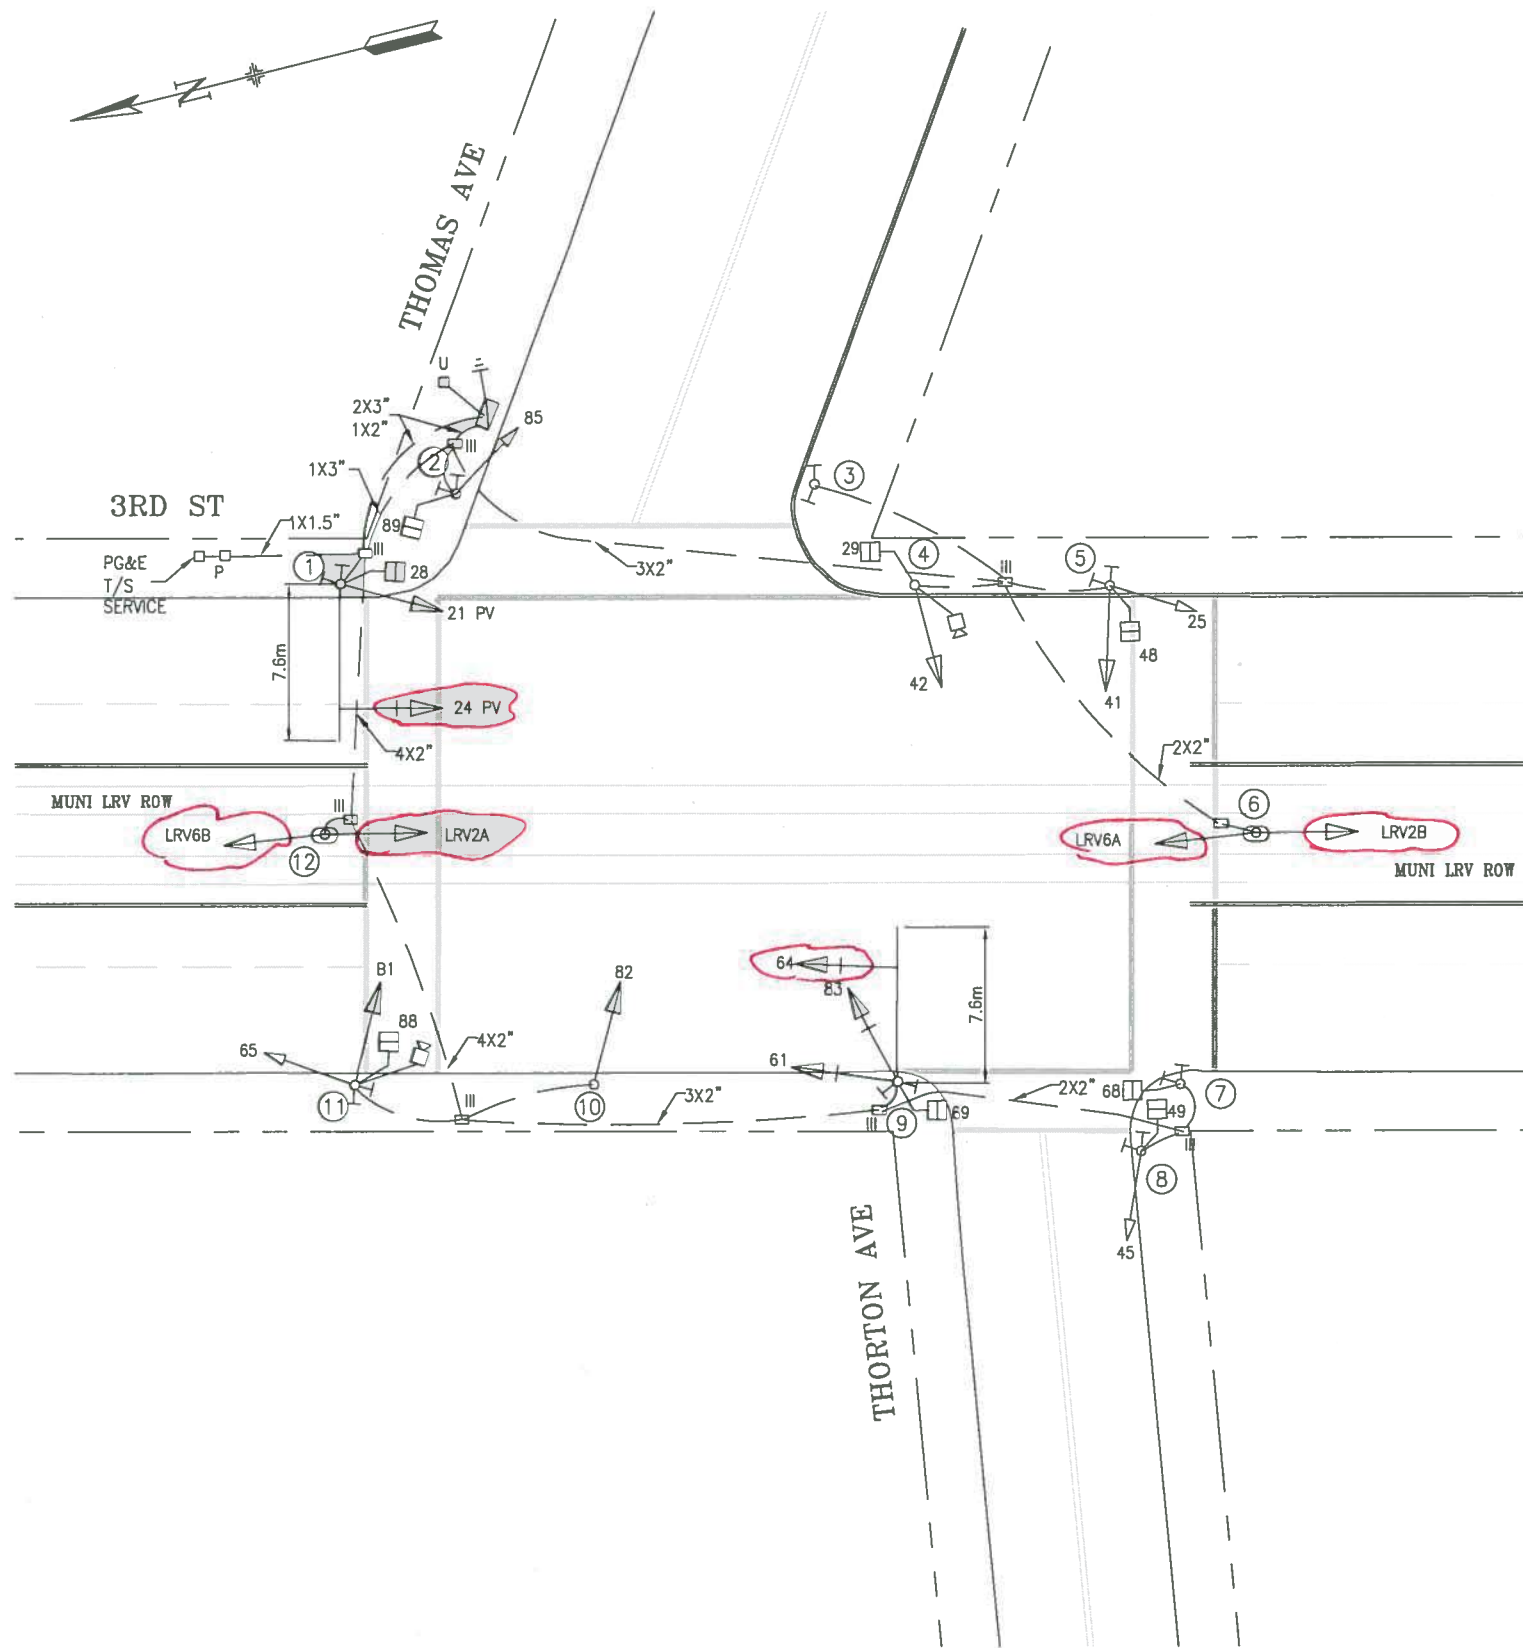

POLE AND EQUIPMENT SCHEDULE									
POLE No.	TYPE OF POLE	LUMINAIRE (HPS)	VEHICLE SIGNAL			PEDESTRIAN SIGNAL			REMARKS
		VOLTAGE/ WATTS	No.	TYPE	MOUNTING (F/I)	No.	TYPE	MOUNTING (F/I)	
①	MUNI COMBO POLE WITH 7.6m M.A.		24 21	3S12" 6VA 3S12"	MAS SV-2-T	28	1S-LED	SP-1	PPB DETAIL 'F'; T-23
②	TYPE 1-A (3.05m)		85	3S8"	TV-1	89	1S-LED	SP-1	PPB
③	STREET LIGHT								PPB
④	MUNI COMBO POLE		42	3S12"	SV-1-T	29	1S-LED	SP-1	PPB
⑤	TYPE 1-A (3.05m)		41 25	3S12" 3S8"	TV-2-T	48	1S-LED	SP-1	PPB
⑥	TYPE 1-A (3.6m)		LRV2A LRV6B	2S12" T 2S12" T	TV-2-T				
⑦	TYPE 1-A (3.05m)					68	1S-LED	SP-1	PPB
⑧	TYPE 1-A (3.05m)		45	3S8"	TV-1	49	1S-LED	SP-1	PPB
⑨	MUNI COMBO POLE WITH 7.6m M.A.		61 83 64	3S12" 3S12" 3S12" 6VA	SV-2-T MAS	69	1S-LED	SP-1	PPB DETAIL 'F'; T-23
⑩	TYPE 1-A (3.05m)		82	3S12"	TV-1-T				
⑪	MUNI COMBO POLE		65 81	3S8" 3S12"	SV-2-T	88	1S-LED	SP-1	PPB
⑫	TYPE 1-A (3.6m)		LRV2B LRV6A	2S12" T 2S12" T	TV-2-T				

M.A. = MAST ARM

NOTE:
CABINET FOUNDATION TYPE: M-SF

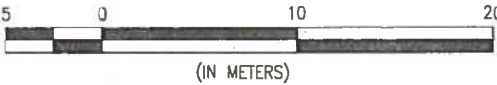

2	2/17/14	RED MARK CHANGES PER SRC 2014-028	BW	CW
1	2/10/05	TRAFFIC SIGNAL UPGRADE FOR THIRD STREET LIGHT RAIL	DY	AH
NO.	DATE	DESCRIPTION	BY	APP.
TABLE OF REVISIONS				
CHECK WITH TRACING TO SEE IF YOU HAVE LATEST REVISION				

COMPLETION DATE / ELECTRICIAN INITIAL
--



DEPARTMENT OF PARKING AND TRAFFIC
DIVISION OF TRAFFIC ENGINEERING
CITY AND COUNTY OF SAN FRANCISCO

DRAWN:	DATE:	SCALE:
DY	6/06	1:200
CHECKED:	DATE:	SHEET OF SHEETS
		OF

TRAFFIC SIGNAL INVENTORY DIAGRAM
TRAFFIC SIGNAL PLAN 3RD ST AND THOMAS/THORTON AVES INTERSECTION

CNN NO. 20502000
REV. NO. 2