

DIST	COUNTY	ROUTE	POST MILES TOTAL PROJECT	SHEET NO.	TOTAL SHEETS
04	SF	101			




PHASE SEQUENCE:

Ø2 101 FREEWAY OFF-RAMP NB	G	Y	R
Ø4P PED XING OFF-RAMP	RH	WM	FRH

DETAIL NOTES:


- A F/I ONE (1) 41 mm RGSC, 2#2, 1#6 BSCW FOR IC SERVICE. SEE STRUCTURAL DRAWINGS FOR DETAILS. CONTRACTOR SHALL COORDINATE WITH BRIDGE CONTRACTOR BEFORE INSTALLING CONDUIT.
- B F/I ONE (1) 41 mm RGSC, 2#8, 1#6 BSCW FOR FLASHING BEACON SERVICE. SEE STRUCTURAL DRAWINGS FOR DETAILS. CONTRACTOR SHALL COORDINATE WITH BRIDGE CONTRACTOR BEFORE INSTALLING CONDUIT.
- C SEE DRAWING ET-1.0 FOR CONTINUATION OF THESE CONDUITS.
- D F/I TYPE III-A METER PEDESTAL PER CTSP 1999 ES-2D EXCEPT WITH ITEMS 1-8, AND ITEM 15 INSTALLED; ALL OTHER ITEMS ARE NOT REQUIRED. UNMETERED CIRCUITS SHALL NOT BE WIRED. METERED LOAD: 150W, FLASHING BEACON, CALTRANS ID NO. 04341010000551.

PHASE DIAGRAM:

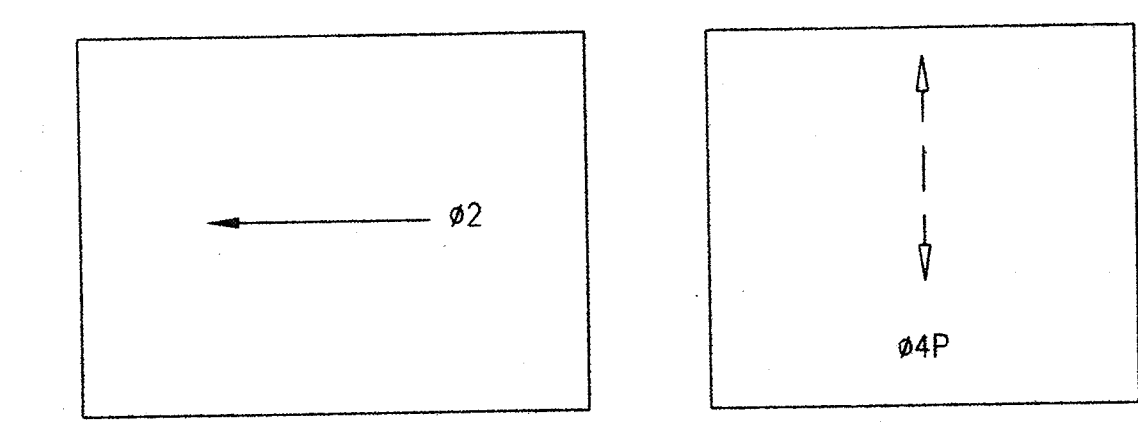


PHASES 2
FREEWAY OFF-RAMP

PHASES 4P
ACTUATED

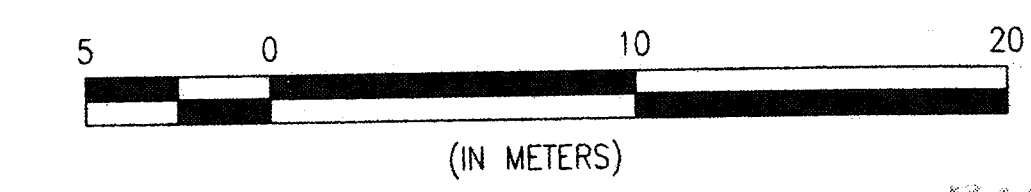


AS-BUILT
5-24-2005

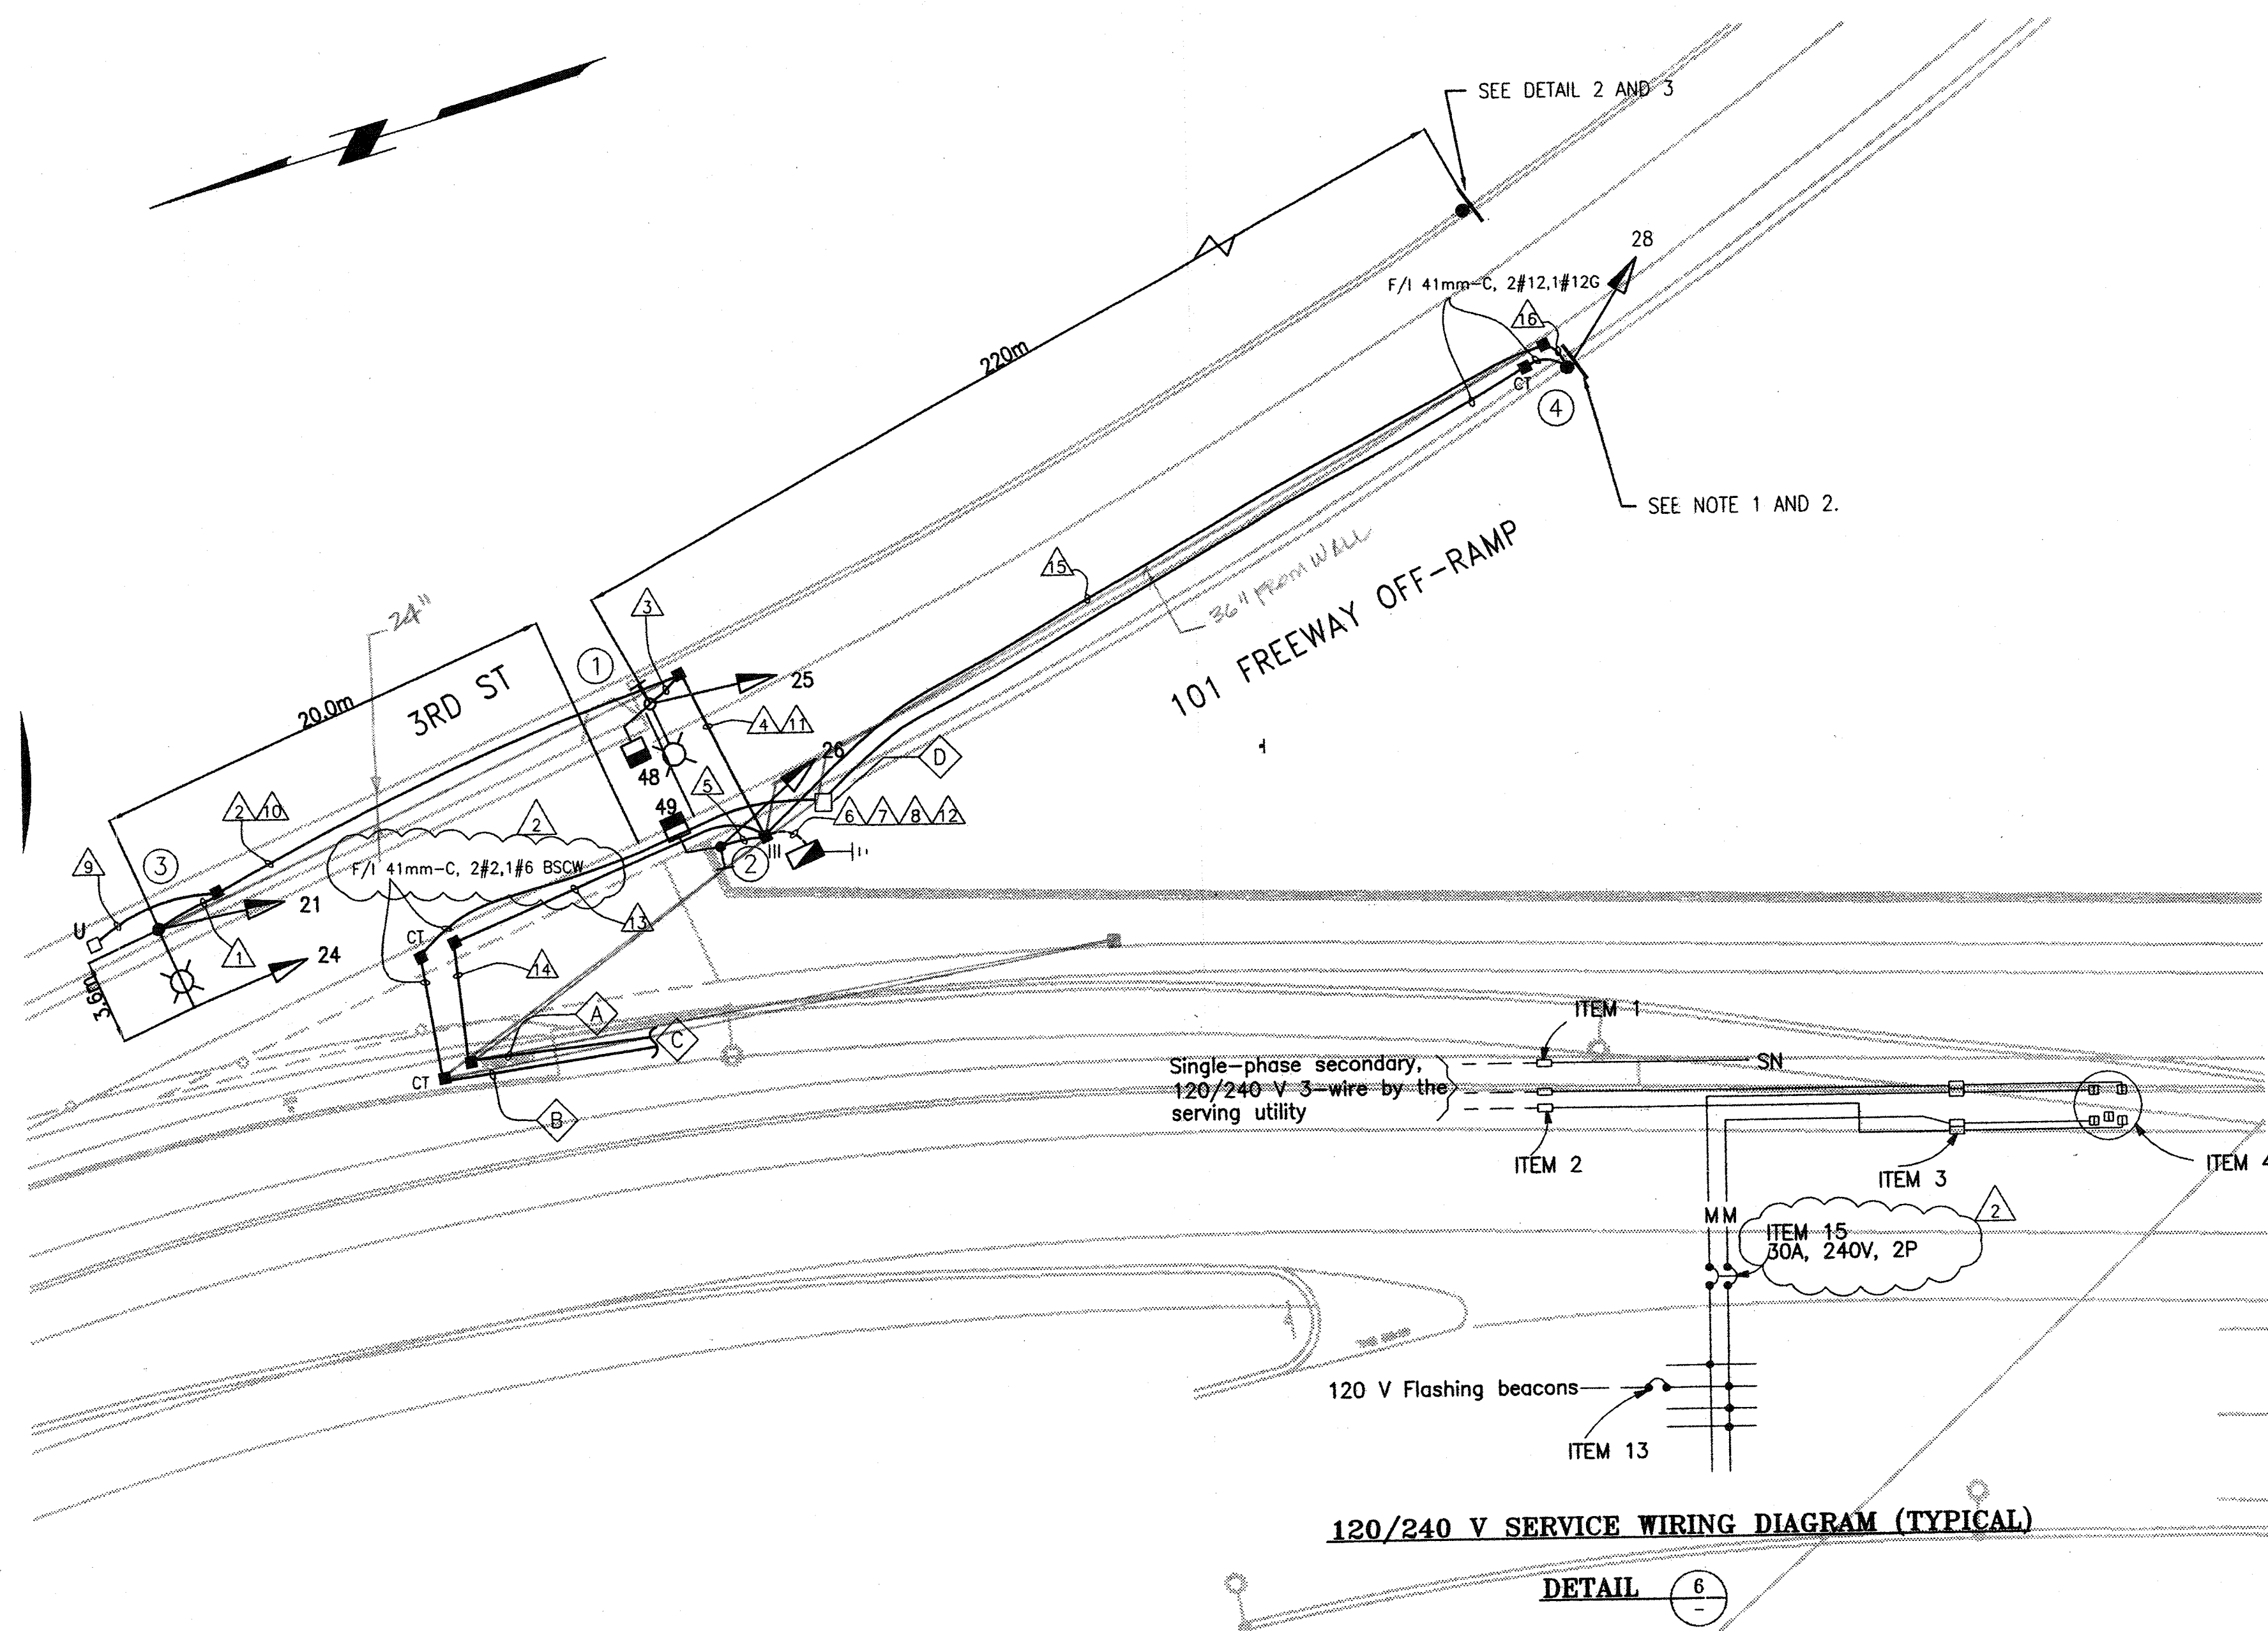


NOTES:

- 1) TYPE 1-B (2.44m) CALTRANS STANDARD WITH W41 SIGN (1.2m X 1.2m) AND 12" (0.305m) SINGLE SECTION FLASHING BEACON (YELLOW LENS AND BACK PLATE) PER STATE STANDARD DETAIL PLANS (JULY 1999) ES-4C. INCANDESCENT LIGHTING FIXTURE NOT REQUIRED.
- 2) W41 SIGN (1.2m X 1.2m). SEE SIGNING PLAN S-2 AND S-10.
- 3) SEE RETAINING WALL PLANS FOR MOUNTING DETAILS OF FLASHING BEACON AND W41 SIGNS.

REFERENCE INFORMATION
& FILE NO. OF SURVEYS

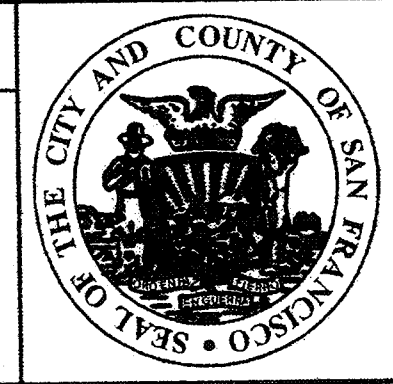

BUREAU OF ENGINEERING
DEPARTMENT OF PUBLIC WORKS
CITY AND COUNTY OF SAN FRANCISCO

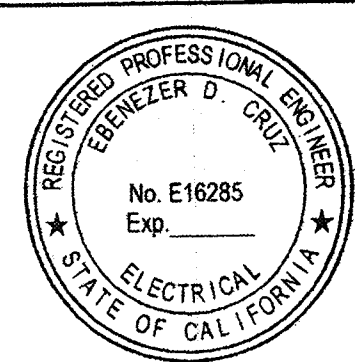

DESIGNED: BC	DATE: 1/02	APPROVED	SPECIFICATION NO. MR-1144
DRAWN: EB/RT	DATE: 1/02	SECTION MANAGER	DRAWING NO. ET-9.0
CHECKED: AH/SL	DATE: 1/02	DIVISION MANAGER	FILE NO. 79,155
		CITY ENGINEER	REV. NO. 2

101 FREEWAY OFF-RAMP/3RD ST EXIT
TRAFFIC SIGNAL PLAN

ET-9.0

DATE REVISION BY
DATE REVISION BY
CALCULATED/DESIGNED BY
CHECKED BY

PROJECT ENGINEER

STATE OF CALIFORNIA - DEPARTMENT OF TRANSPORTATION

