



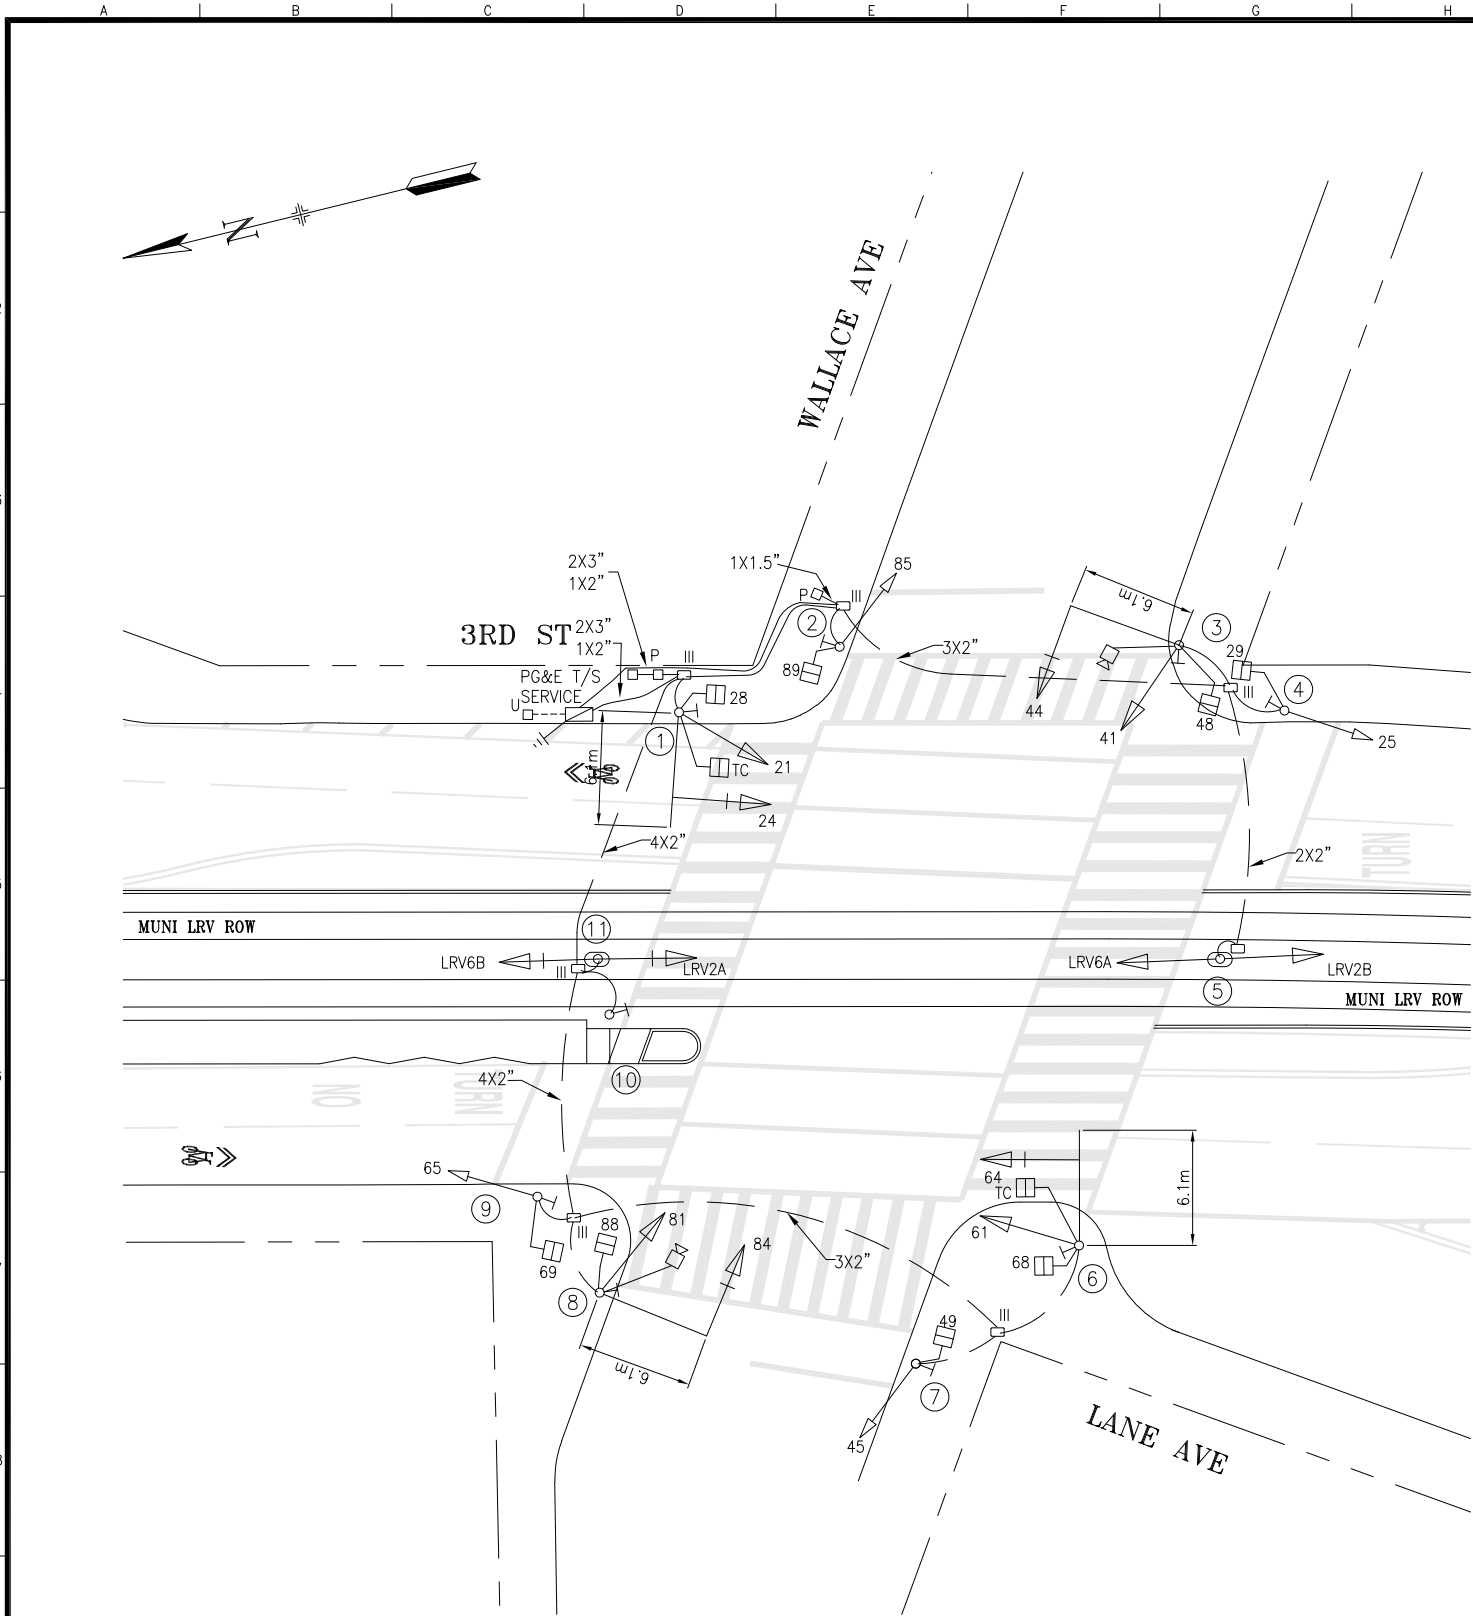

POLE AND EQUIPMENT SCHEDULE									
POLE No.	TYPE OF POLE	LUMINAIRE (HPS)	VEHICLE SIGNAL			PEDESTRIAN SIGNAL			REMARKS
		VOLTAGE/ WATTS	No.	TYPE	MOUNTING (F/I)	No.	TYPE	MOUNTING (F/I)	
①	MUNI COMBO POLE WITH 6.1m M.A.		24 21 TC	3S12" GVA 3S12" 1S 24"x24"	MAS SV-1-T SV-1	28	1S-LED	SP-1	APS DETAIL 'D'; T-22
②	TYPE 1-A (3.05m)		85	3S8"	TV-1	89	1S-LED	SP-1	APS
③	17-2-129 WITH 6.1m M.A.		41 44	3S12" 3S12"	SV-1-T MAS	48	1S-LED	SP-1	APS
④	MUNI COMBO POLE		25	3S8"	SV-1-T	29	1S-LED	SP-1	APS
⑤	TYPE 1-A (3.6m)		LRV2B LRV6A	2S12" LB- 2S12" LB-	TV-2-T				
⑥	MUNI COMBO POLE WITH 6.1m M.A.		61 64 TC	3S12" 3S12" GVA 1S 24"x24"	SV-1-T MAS SV-1	68	1S-LED	SP-1	APS DETAIL 'D'; T-22
⑦	TYPE 1-A (3.05m)		45	3S8"	TV-1	49	1S-LED	SP-1	APS
⑧	17-2-129 WITH 6.1m M.A.		81 84	3S12" 3S12"	SV-1-T MAS	88	1S-LED	SP-1	APS
⑨	MUNI COMBO POLE		65	3S8"	SV-1-T	69	1S-LED	SP-1	APS
⑩	PPB POST								APS W/ SIGNS (← →) POLE LOCATION, REFER TO ST DRAWINGS
⑪	TYPE 1-A (3.6m)		LRV2A LRV6B	2S12" LB- 2S12" LB-	TV-2-T				

M.A. = MAST ARM

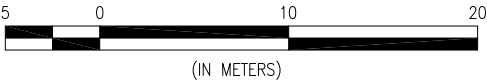

NO.	DATE	DESCRIPTION	BY	APP.
3	2/2/20	SRC 2019-316: INSTALLED FTC SIGNS ON POLES 1 & 6 AND UPDATED PER FIELD CONDITIONS	CXL	MV
2	2/17/14	SRC 2014-028: REPLACE MUNI RED T/WHITE T SIGNALS WITH LUNAR BARS. INSTALL GVA FOR SIGNALS 24/64.	BW	CW
1	2/3/05	TRAFFIC SIGNAL UPGRADE FOR THIRD STREET LIGHT RAIL	DY	AH
TABLE OF REVISIONS CHECK WITH TRACING TO SEE IF YOU HAVE LATEST REVISION				

COMPLETION DATE / ELECTRICIAN INITIAL
--



DEPARTMENT OF PARKING AND TRAFFIC
DIVISION OF TRAFFIC ENGINEERING
CITY AND COUNTY OF SAN FRANCISCO

DRAWN: DY	DATE: 6/06	SCALE: 1:200
CHECKED:	DATE:	SHEET OF SHEETS OF

TRAFFIC SIGNAL INVENTORY DIAGRAM	CNN NO. 20485000
TRAFFIC SIGNAL PLAN 3RD ST AND WALLACE/LANE AVE INTERSECTION	REV. NO. 3