
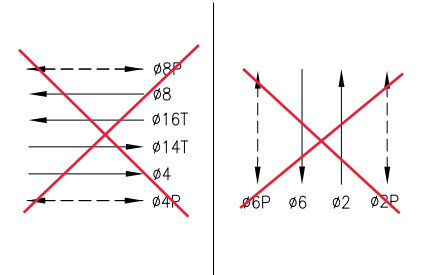



NOTES:

- SEE DRAWING ET-108 FOR POLE, EQUIPMENT, CONDUIT, AND WIRING SCHEDULES.
- ABANDON (E) CONDUIT IN PLACE. PULL BACK (E) WIRING, AND CAP ENDS.
- ~~PROVIDE (N) TRAFFIC SIGNAL CONTROLLER AND (N) FOUNDATION IN SAME LOCATION AS (E) CONTROLLER.~~
- R/C (E) PULLBOX.
- ~~F/I CCTV CAMERA ETHERNET CABLE (CA60 & 3/18) FROM INTERSECTION CONTROLLER CABINET TO NEAR TOP OF CAMERA POLE. COIL EXTRA 18' ETHERNET CABLE AT BOTH ENDS. SEE CAMERA INSTALLATION DETAILS ON SHEET R-5. DRILL HOLE ON POLE AS DIRECTED BY TRAFFIC SIGNAL SHOP (415 646 2373).~~

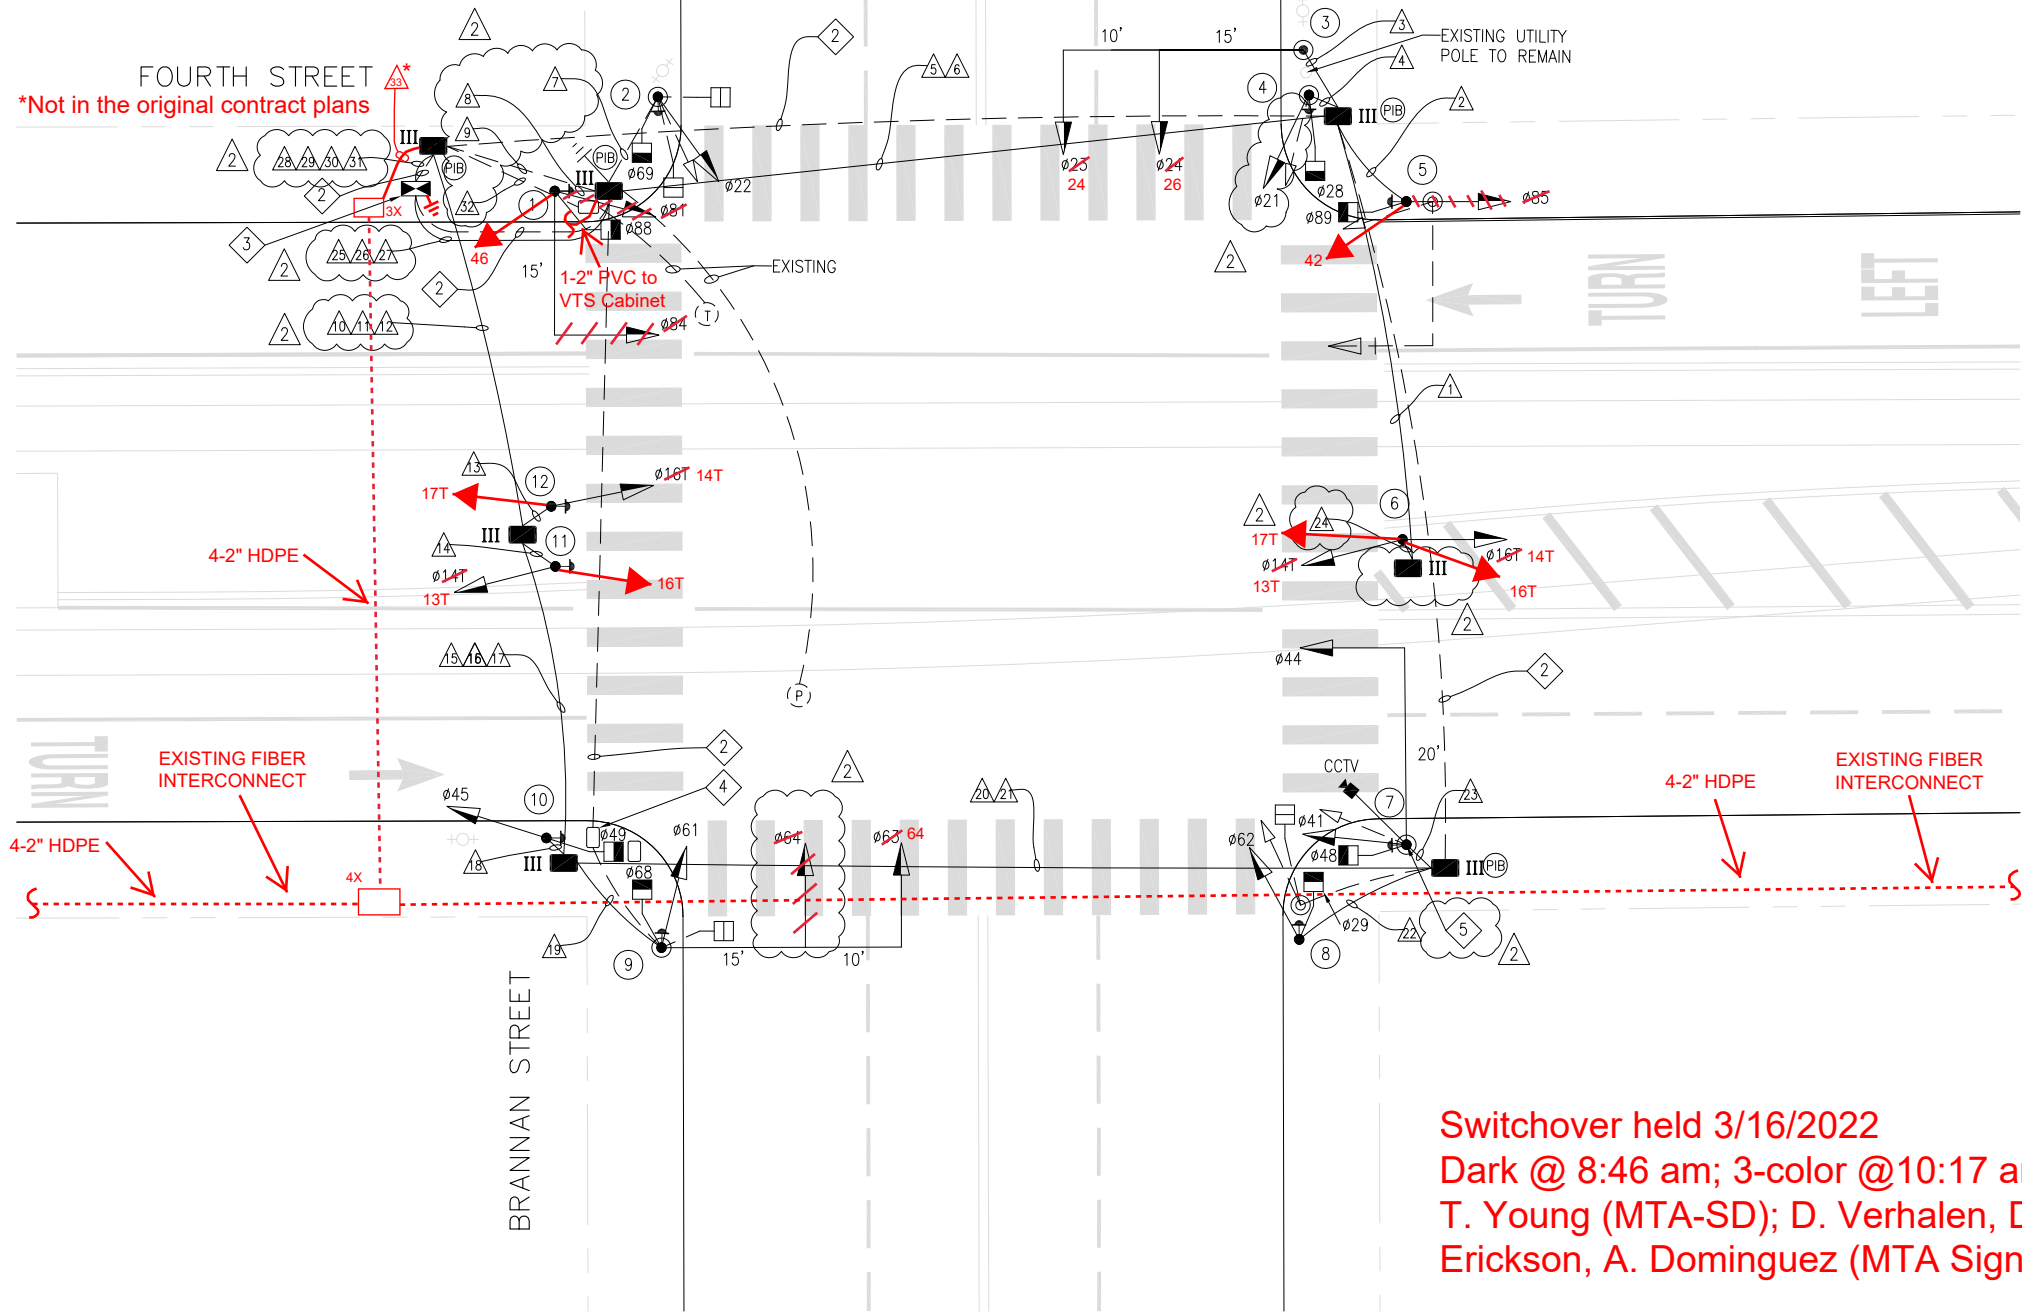

PROPOSED PHASE DIAGRAM

Switchover held 3/16/2022
Dark @ 8:46 am; 3-color @10:17 am
T. Young (MTA-SD); D. Verhalen, D. Guevara, J.
Erickson, A. Dominguez (MTA Signal Shop)

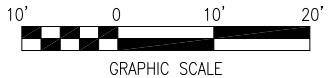

T:_E_FILES\Construction Section\PERSONNEL\GWin\Projects\Central Subway STS\Signal Mods\3 Brannan\4th_Brannan TS.dwg
gwing Fri Jun 09,2017 - 1:51 pm ET-102

DATE	DESCRIPTION	REV. NO.	BY	CHECKED	APPROVED
2/3/2017	75% SUBMITTAL	0			

SFMTA

DESIGNED G. WING
DRAWN G. WING
CHECKED C. HUI
REVIEWED B. DUSSEAU
RECOMMENDED C. MORGANSON
APPROVED R. EDWARDS
DATE 2/3/2017

REV. 0
SEALED BY
W. SENG



CITY AND COUNTY OF SAN FRANCISCO
MUNICIPAL TRANSPORTATION AGENCY

APPROVED
EDWARD D. REISKIN
DIRECTOR OF TRANSPORTATION

THIRD STREET LIGHT RAIL PROGRAM
PHASE 2 - CENTRAL SUBWAY
SURFACE, TRACK AND SYSTEMS

TRAFFIC SIGNALS
BRANNAN STREET AND FOURTH STREET
TRAFFIC SIGNAL PLAN

CONTRACT NO. 1300
SFMTA CONTROL NO. CL-23605
DRAWING NO. ET-107
SHEET NO. 817
REVISION 0

CONDUIT AND WIRING SCHEDULE

CONDUIT AND WIRING SCHEDULE																																	contract plans				
CONDUIT RUN NUMBER		1	2	3	4	5	6	7	8	9	10	11	12	13	14	15	16	17	18	19	20	21	22	23	24	25	26	27	28	29	30	31	32	33*			
CONDUIT SIZE (INCH)		2	2	2	2	2	2	EX	2	EX	2	2	2	2	2	2	2	2	2	2	2	2	2	2	2	2	2	2	2	2	2	2	EX	2			
WIRING (F/I)	NOTES																																				
	#14 AWG WIRES						S			S																											
	VEH SIGNAL 21 46						P		3	P																3											
	VEH SIGNAL 84						A		3	A															3												
	PED SIGNAL 88						R		2	R																2											
	APS PPB FOR POLE 1						E		2	E																2											
	VEH SIGNAL 22 (E)							3																		3											
	PED SIGNAL 69 (E)						S	2		S																2											
	APS PPB FOR POLE 2						P	2		P																2											
	VEH SIGNAL 23 26				3		3	A		A																3											
	VEH SIGNAL 24				3		3	R		R																3											
	VEH SIGNAL 21					3	3	E		E																		3									
	PED SIGNAL 28					2	2																					2									
	APS PPB FOR POLE 4					2	2	S		S																	2										
	VEH SIGNAL 35 42		3				3	P		P																	3										
	PED SIGNAL 89		2				2	A		A																	2										
	APS PPB FOR POLE 5		2				2	R		R																	2										
	LRV SIGNAL 14T 13T	2	2				2	E		E																2	2		2								
	LRV SIGNAL 16T	2	2				2																			2	2		2								
	LRV SIGNAL 16T 14T	2	2				2																			2	2		2								
	LRV SIGNAL 17T	2	2				2																			2	2		2								
	VEH SIGNAL 41							S		S	3					3						3			3				2			3					
	VEH SIGNAL 44							P		P	3					3						3			3						3						
	PED SIGNAL 48							A		A	2					2						2			2					2							
	APS PPB FOR POLE 7							R		R	2					2						2			2					2							
	PED SIGNAL 29							E		E		2				2						2		2								2					
	VEH SIGNAL 62											3				3						3		3								3					
	APS PPB FOR POLE 8							S		S		2				2						2		2								2					
	VEH SIGNAL 61							P		P	3						3					3										3					
	VEH SIGNAL 63							A		A	3					3						3										3					
	VEH SIGNAL 64							R		R	3						3					3										3					
	PED SIGNAL 68							E		E	2						2					2									2						
	APS PPB FOR POLE 9											2						2				2									2						
VEH SIGNAL 45												3					3		3													3					
PED SIGNAL 49												2					2		2													2					
APS PPB FOR POLE 10												2					2		2													2					
LRV SIGNAL 14T 13T												2					2															2					
LRV SIGNAL 16T												2					2															2					
APS PPB FOR POLE 11												2					2															2					
LRV SIGNAL 16T 14T												2					2															2					
LRV SIGNAL 17T												2					2															2					
APS PPB FOR POLE 12												2					2															2					
#14 SPARE	3					3					3	3				3	3				3						3			3	3						
#14 NEUTRAL		2	2	2			2	3		3					1	1			2	4			2	3	1												
TOTAL #14 AWG WIRES	711	9	8	9	31	27	0	9	13	0	23	29	0	7	8	7	8	20	23	0	8	10	20	0	9	13	8	9	20	23	21	0	23	29	0	0	0
TOTAL #10 AWG WIRES, NEUTRAL	1					2					2	1					1	1			1						2	1		2	2			0	0	0	
12/C INTERCONNECT																																2			2		
#8 AWG WIRES (120V SERVICE)																																	2				
CCTV CAMERA WIRES (CAT 6 & 3/16)																																					

1. SEE ET-107 FOR TRAFFIC SIGNAL WORK AT 4TH AND BRANNAN INTERSECTION.
2. ALL (N) CONDUIT SHALL BE SIZED AS NOTED AND PVC MATERIAL, UON.
3. F/I GROUND WIRE IN ALL CONDUITS PER GROUNDING LAYOUT DETAIL ON ET-152.
4. F/I 3/8" PULL TAPE IN ALL SPARE CONDUITS AND IN ALL CONDUITS CONTAINING FIELD WIRES WHICH CROSS A STREET.
5. SEE STANDARD DRAWING FOR TRAFFIC SIGNAL HEAD MOUNTING BRACKET DETAILS.
6. THE HEIGHT OF THE CANTILEVER ARM CONNECTION SHALL BE 24' FROM THE BASE OF POLE.

[illegible]