


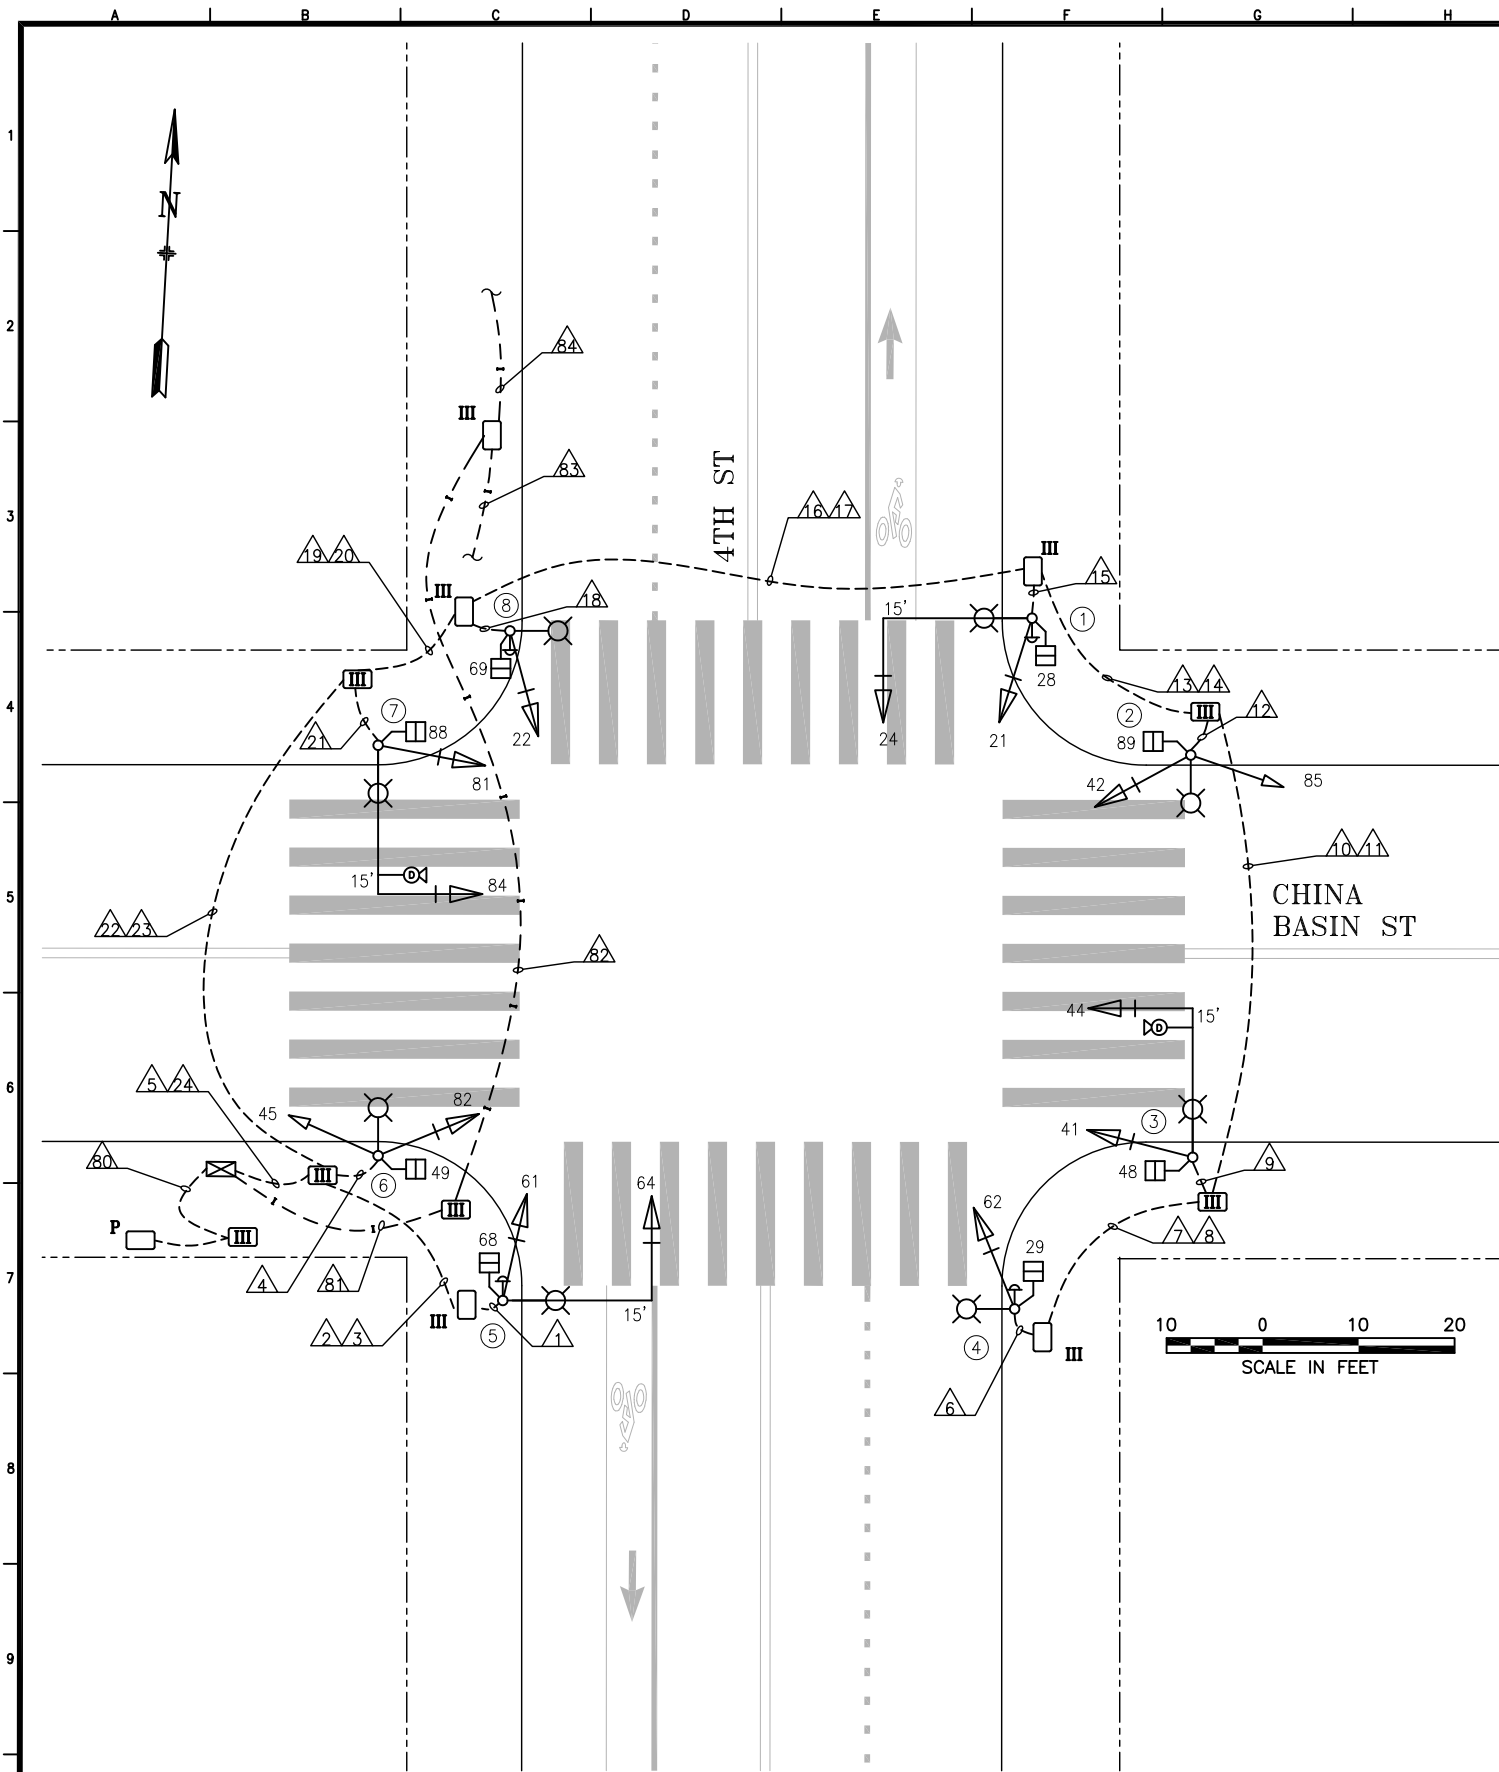

POLE AND EQUIPMENT SCHEDULE										
POLE No.	TYPE OF POLE	VEHICLE SIGNAL					PEDESTRIAN SIGNAL			REMARKS
		No.	TYPE	MOUNTING	VISORS	LOUVERS/BP	No.	TYPE	MOUNTING	
①	761 MISSION BAY 15' STRAIGHT ARM / 8' LUMINAIRE ARM N-4-P15	24 21	3S12" 3S12"	MAS SV-1-T	T T	BP BP	28	1S-COUNT	SP-1-T	PPB ① ②
②	LP2 8' LUMINAIRE ARM N-CB-P16	42 85	3S12" 3S8"	SV-2-TA	T T	BP	89	1S-COUNT	SP-1-T	①
③	LP3 15' STRAIGHT ARM / 8' LUMINAIRE ARM N-CB-P15	44 41	3S12" 3S12"	MAS SV-1-T	T T	BP BP	48	1S-COUNT	SP-1-T	DETECTION CAMERA ① ②
④	761 MISSION BAY 8' LUMINAIRE ARM N-4-P13	62	3S12"	SV-1-T	T	BP	29	1S-COUNT	SP-1-T	PPB ①
⑤	761 MISSION BAY 15' STRAIGHT ARM / 8' LUMINAIRE ARM N-4-P14	64 61	3S12" 3S12"	MAS SV-1-T	T T	BP BP	68	1S-COUNT	SP-1-T	PPB ① ②
⑥	LP2 8' LUMINAIRE ARM N-CB-P13	82 45	3S12" 3S8"	SV-2-TA	T T	BP	49	1S-COUNT	SP-1-T	①
⑦	LP3 15' STRAIGHT ARM / 8' LUMINAIRE ARM N-CB-P14	84 81	3S12" 3S12"	MAS SV-1-T	T T	BP BP	88	1S-COUNT	SP-1-T	DETECTION CAMERA ① ②
⑧	761 MISSION BAY 8' LUMINAIRE ARM N-CB-P16	22	3S12"	SV-1-T	T	BP	69	1S-COUNT	SP-1-T	PPB ①

- SHEET NOTES:**
- ① POLES ARE POWDER-COATED "STEEL GREY", #T028-GR02, BY CARDINAL INDUSTRIAL FINISHES.
 - ② THE STRAIGHT ARM SHALL BE HORIZONTAL AND CONNECTED TO THE POLE TO PROVIDE A 23' - 6" CLEARANCE ABOVE THE SIDEWALK GRADE.

- GENERAL NOTES:**
- ALL PULLBOXES USE METAL LIDS

NO.	DATE	DESCRIPTION	BY	APPROVED
1	6/24/2023	REMOVE VIDEO FOR 2/6 AND REMOVE PPB FOR 2P/6P	D. YEUNG	G. DE LEON
2	11/10/2015	CONVERTED FROM CONTRACT PLANS, RESIDENTIAL AREA MISSION BAY PROJECT	D. YEUNG	G. DE LEON

TABLE OF REVISIONS
CHECKOUT DRAWING THROUGH THE SID CUSTODIAN FOR THE LATEST REVISION



SFMTA

DRAWN BY: E. LUU	DATE: 8/2023
CHECKED BY: G. DE LEON	DATE: 8/2023

SCALE AS SHOWN
SHEET OF SHEETS 1 OF 2

TRAFFIC SIGNAL INVENTORY DIAGRAM
4TH STREET & CHINA BASIN STREET

CNN NO: 34170000
REV NO: 1

CONDUIT RUN NUMBER		△1	△2	△3	△4	△5	△6	△7	△8	△9	△10	△11	△12	△13	△14	△15	△16	△17	△18	△19	△20	△21	△22	△23	△24	△30	△31	△32	△33	△34	
CONDUIT SIZE (INCH)		2	2	2	2	3	2	2	2	2	3	2	2	3	2	2	3	2	2	3	2	2	3	2	3	2	3	3	3	◇1	◇1
NOTES				SP					SP			SP			SP			SP			SP			SP				SP	SP	HDPE	HDPE
	VEHICLE SIGNAL 61	3	3			3																									
	VEHICLE SIGNAL 64	3	3			3																									
	PEDESTRIAN SIGNAL 68	2	2			2																									
	PPB XING 4TH ST, POLE 5 (4P)	2	2			2																									
	VEHICLE SIGNAL 45				3	3																									
	VEHICLE SIGNAL 82				3	3																									
	PEDESTRIAN SIGNAL 49				2	2																									
	PPB XING CHINA BASIN, POLE 6 (6P)◇2				2	2																									
	VEHICLE SIGNAL 62						3	3			3			3			3			3			3		3						
	PEDESTRIAN SIGNAL 29						2	2			2			2			2			2			2		2						
	PPB XING 4TH ST, POLE 4 (4P)						2	2			2			2			2			2			2		2						
	VEHICLE SIGNAL 41									3	3			3			3			3			3		3		3				
	VEHICLE SIGNAL 44									3	3			3			3			3			3		3		3				
	PEDESTRIAN SIGNAL 48									2	2			2			2			2			2		2		2				
	PPB XING CHINA BASIN, POLE 3 (2P)◇2									2	2			2			2			2			2		2		2				
	VEHICLE SIGNAL 42												3	3			3			3			3		3		3				
	VEHICLE SIGNAL 85												3	3			3			3			3		3		3				
	PEDESTRIAN SIGNAL 89												2	2			2			2			2		2		2				
	PPB XING CHINA BASIN, POLE 2 (2P)◇2												2	2			2			2			2		2		2				
	VEHICLE SIGNAL 21															3	3			3			3		3		3				
	VEHICLE SIGNAL 24															3	3			3			3		3		3				
	PEDESTRIAN SIGNAL 28															2	2			2			2		2		2				
	PPB XING 4TH ST, POLE 1 (8P)															2	2			2			2		2		2				
	VEHICLE SIGNAL 22																		3	3			3		3		3				
	PEDESTRIAN SIGNAL 69																		2	2			2		2		2				
	PPB XING 4TH ST, POLE 8 (8P)																		2	2			2		2		2				
	VEHICLE SIGNAL 81																						3	3		3					
	VEHICLE SIGNAL 84																						3	3		3					
	PEDESTRIAN SIGNAL 88																						2	2		2					
	PPB XING CHINA BASIN, POLE 7 (6P)◇2																						2	2		2					
	#14 NEUTRAL	3			2		2			3			2			3			2			3									
	#14 SPARE		3			3		3			3			3			3			3			3		3						
	TOTAL #14 WIRES	13	13		12	23	9	10		13	20		12	30		13	40		9	47		13	57		57						
	#10 NEUTRAL		1			1		1			1			1			1			1			1		1						
	#10 WIRES STREETLIGHT																														
	#8 WIRES STREETLIGHT																														
	#6 WIRES (120 V TS SERVICE)																										2				
	VIDEO DETECTOR CABLE (BELDEN #8691)																														
	PHASE 4									1	1			1			1			1			1		1						
	PHASE 8																					1	1		1						

1 4-2" HDPE SCHEDULE 80 CONDUIT SPARE

2 ALTHOUGH THIS PPB HAS BEEN REMOVED, THE WIRING WAS LEFT IN THE CONDUIT FOR FUTURE USE

[illegible]