


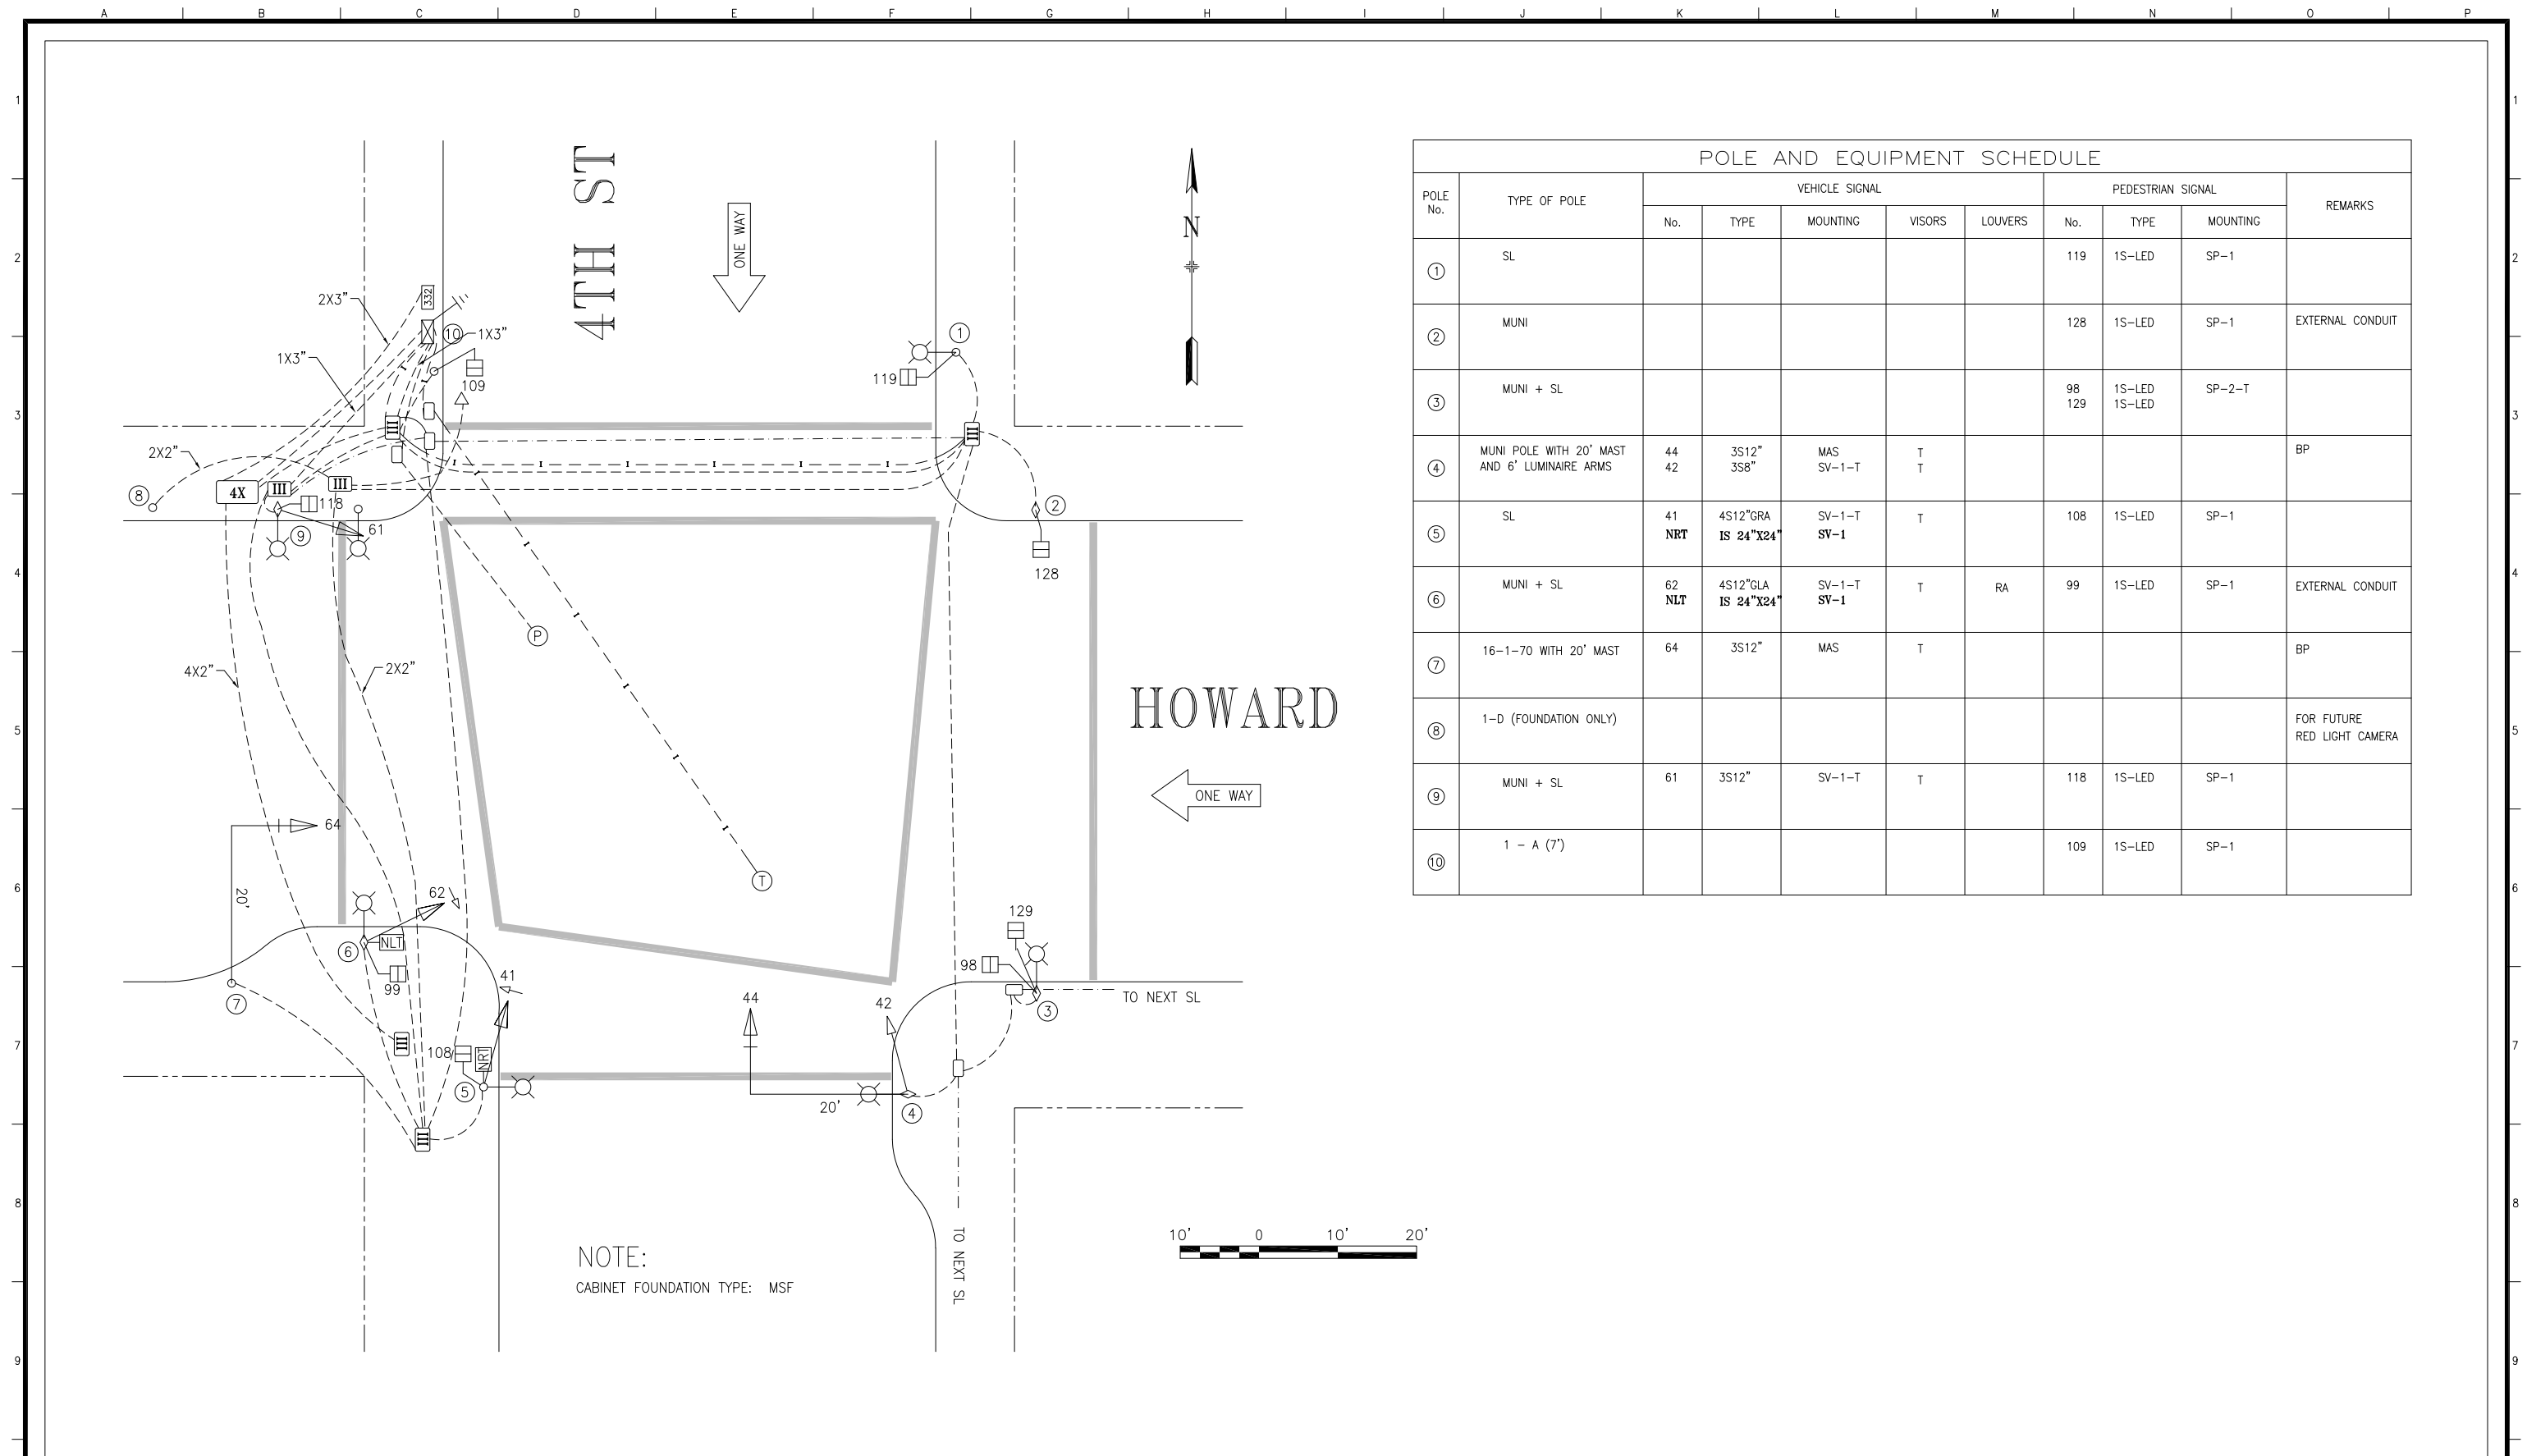

POLE No.	TYPE OF POLE	VEHICLE SIGNAL					PEDESTRIAN SIGNAL			REMARKS
		No.	TYPE	MOUNTING	VISORS	LOUVERS	No.	TYPE	MOUNTING	
①	SL						119	1S-LED	SP-1	
②	MUNI						128	1S-LED	SP-1	EXTERNAL CONDUIT
③	MUNI + SL						98 129	1S-LED 1S-LED	SP-2-T	
④	MUNI POLE WITH 20' MAST AND 6' LUMINAIRE ARMS	44 42	3S12" 3S8"	MAS SV-1-T	T T					BP
⑤	SL	41 NRT	4S12"GRA IS 24"X24"	SV-1-T SV-1	T		108	1S-LED	SP-1	
⑥	MUNI + SL	62 NLT	4S12"GLA IS 24"X24"	SV-1-T SV-1	T	RA	99	1S-LED	SP-1	EXTERNAL CONDUIT
⑦	16-1-70 WITH 20' MAST	64	3S12"	MAS	T					BP
⑧	1-D (FOUNDATION ONLY)									FOR FUTURE RED LIGHT CAMERA
⑨	MUNI + SL	61	3S12"	SV-1-T	T		118	1S-LED	SP-1	
⑩	1 - A (7')						109	1S-LED	SP-1	

A	09/06/19	SRC 2019-162: ADDED BLANKOUT NO TURN SIGNS ON POLE 5 & 6		AU	MS		
NO.	DATE	DESCRIPTION		BY	APP.		
TABLE OF REVISIONS							
CHECK WITH TRACING TO SEE IF YOU HAVE LATEST REVISION							

REFERENCE INFORMATION
& FILE NO. OF SURVEYS



SAN FRANCISCO MUNICIPAL TRANSPORTATION AGENCY
CITY AND COUNTY OF SAN FRANCISCO

			SCALE:		CNN NO.
DRAWN: DATE:	CXL	04/02/2003	1" = 10 feet	TRAFFIC SIGNAL INVENTORY DIAGRAM	24627000
CHECKED: DATE:	WL	04/09/2003	SHEET OF SHEETS 1 OF 1	4TH STREET AND HOWARD STREET	REV NO. 1