


350i-ATC cabinet w/adaptor plates
on existing M-SF foundation
(installed by City forces)

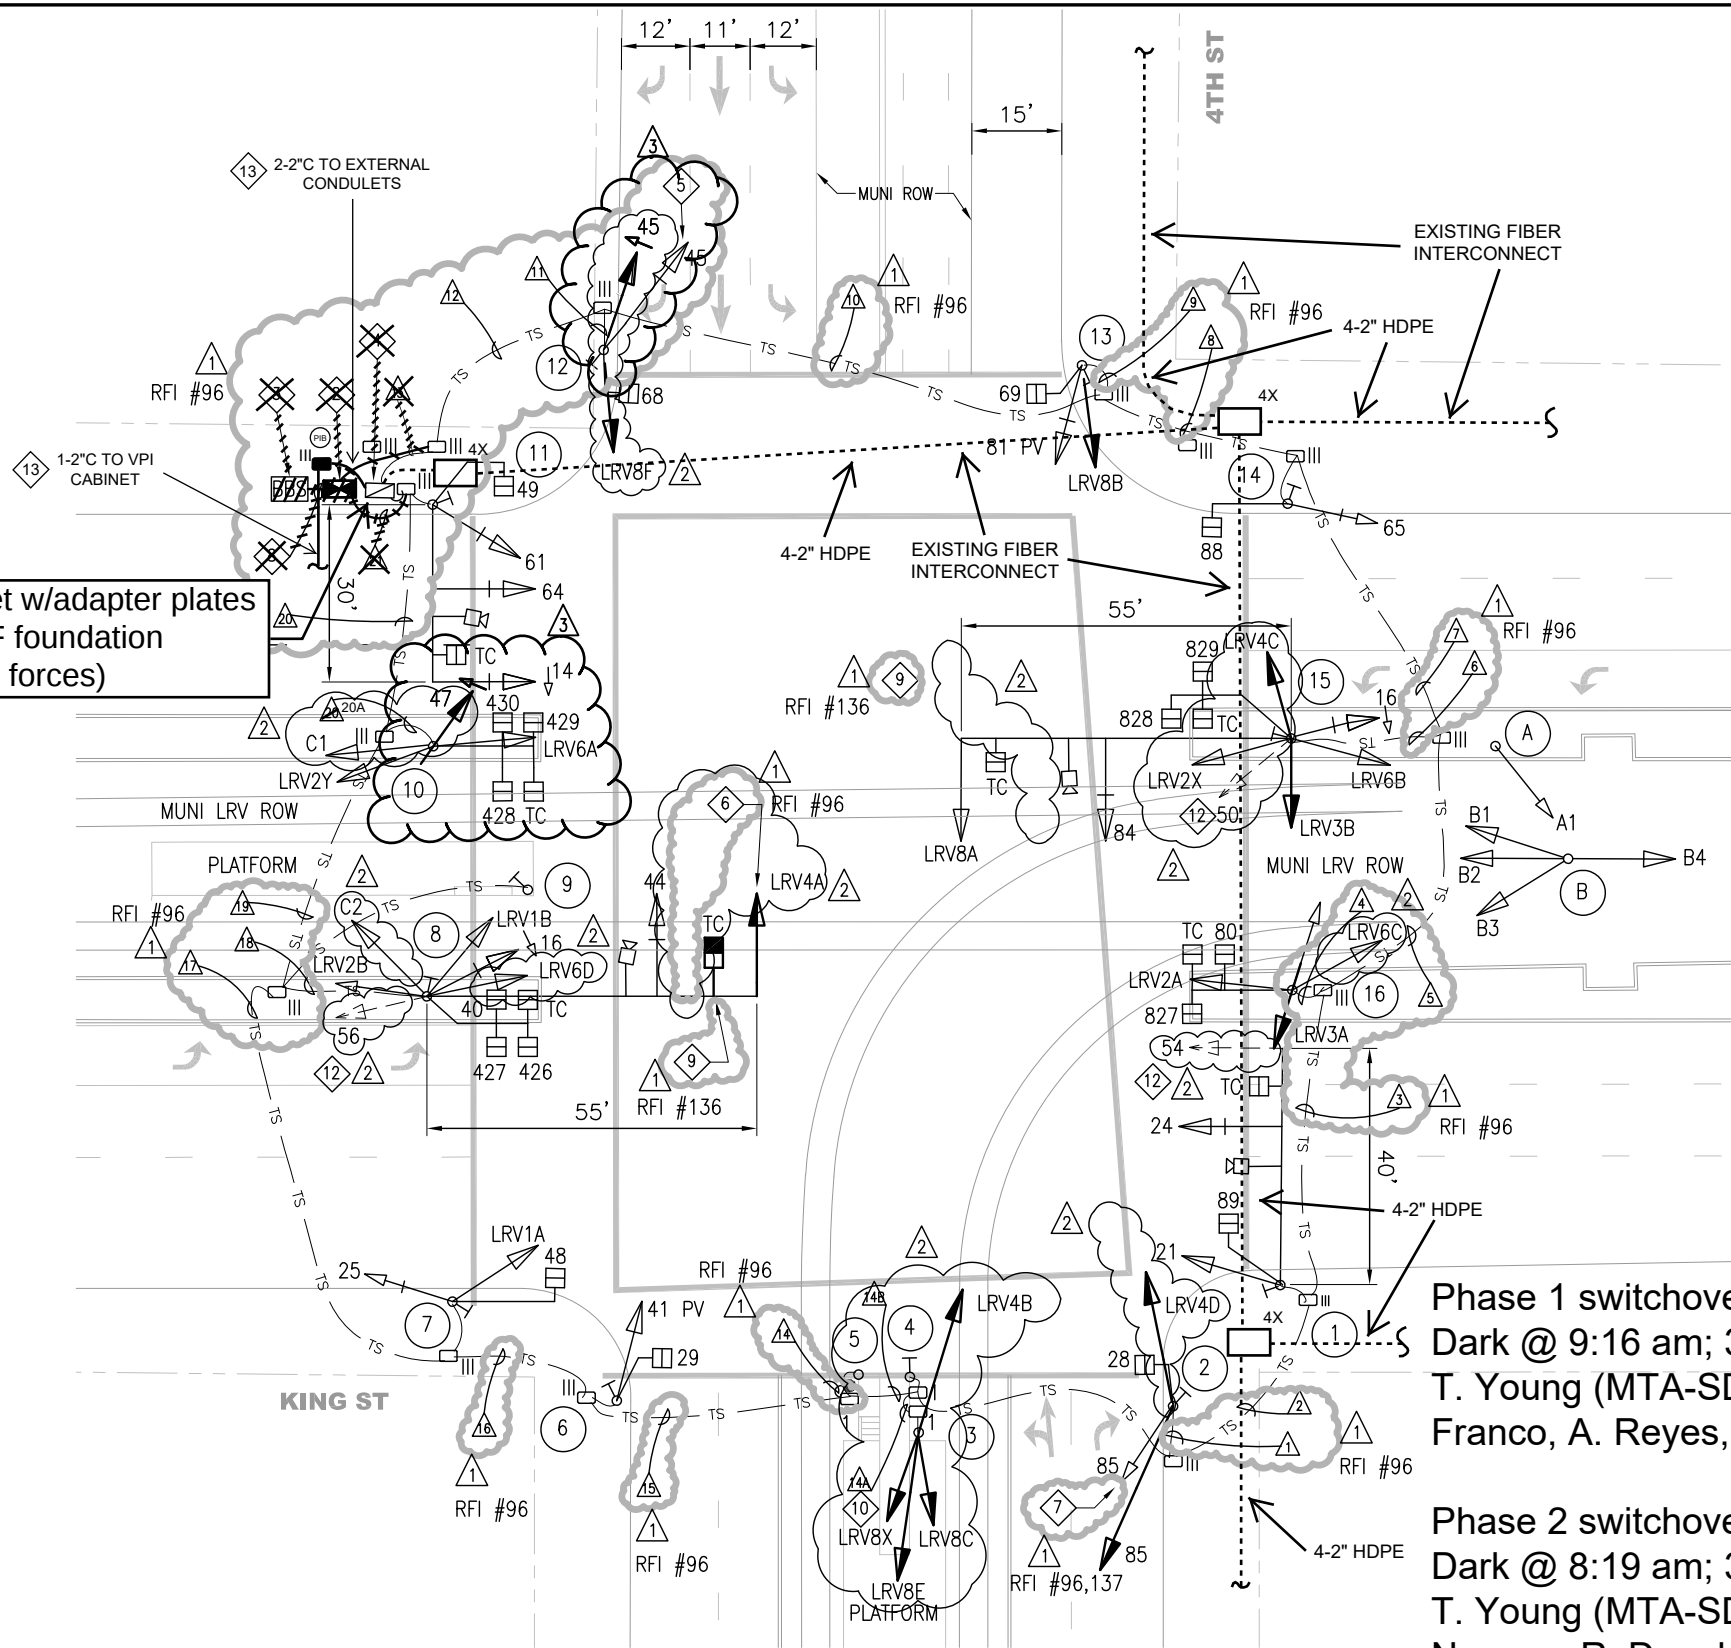


NOTES:

1. REPLACE EXISTING VDC WITH UPGRADED AUTO-SCOPE MODE.
2. F/I ITS 340 IC CABINET AND CONTROLLER. SEE DRAWING ET-154, DETAIL 1 FOR FOUNDATION DETAIL.
3. F/I BATTERY BACKUP SYSTEM (BBS).
4. REMOVE AND SALVAGE (E) TRAFFIC SIGNAL CONTROLLER AND RETURN TO CITY. DEMO (E) FOUNDATION. PROVIDE (N) TYPE 3 PULLBOX IN SAME LOCATION AS EXISTING CONTROLLER. MODIFY (E) CONDUITS AND (E) WIRING AS NEEDED.
5. R/D (E) VEHICLE SIGNAL NO. 45. REUSE (E) WIRING AND RECONNECT TO (N) SIGNAL NO. 45.
6. R/D (E) VEHICLE SIGNAL NO. 74. REUSE (E) WIRING AND RECONNECT TO (N) SIGNAL NO. 74.
7. R/D (E) VEHICLE SIGNAL NO. 85. REUSE (E) WIRING AND RECONNECT TO (N) SIGNAL NO. 85.
8. PROVIDE 2" HDPE CONDUIT.
9. PROVIDE TENON.
10. PROVIDE 1-2" CONDUIT.
11. LRV2X, LRV6C, LRV6D, C1, & C2 WERE INSTALLED BY CITY FORCES AFTER CONTRACT WAS AWARDED.
12. R/D (E) VEHICLE SIGNALS NO. 50, 54, & 56.
13. TWO EXTERNAL CONDULET FITTINGS ARE INSTALLED ON ONE OF THE CABINET ADAPTER PLATES. ONE CONTAINS CONDUCTORS THAT LEAD TO THE VPI CABINET AND THE OTHER IS A SPARE. SEE CONTRACT 1256, DRAWING SG-501 FOR DETAILS ON CONDUIT LAYOUT TO THE VPI CABINET.

Phase 1 switchover (cabinet swap) held 4/3/2022
Dark @ 9:16 am; 3-color @ 2:26 pm
T. Young (MTA-SD); D. Verhalen, D. Guevara, B. Franco, A. Reyes, P. Nguyen (MTA Signal Shop)

Phase 2 switchover (signal upgrades) held 5/28/2022
Dark @ 8:19 am; 3-color @ 11:58 am
T. Young (MTA-SD); D. Verhalen, M. Chue, P. Nguyen, R. Donohoe (MTA Signal Shop)

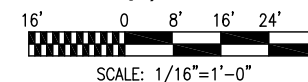

PLAN

FOR ORIGINAL SIGNATURES, SEE CL-23616 REV 0

DATE	DESCRIPTION	REV. NO.	BY	CHECKED	APPROVED
09/01/2023	SRC 2023-226 MODIFIED VEH 45 & 47 TO 4S12" FYRA	3	MT	AL	AL
03/06/2020	ISSUED FOR PCC NO. 694	2			
08/28/2014	ISSUED FOR 1300 PCC NO. 14	1			
05/25/2012	ISSUED FOR BID	0			

SFMTA

DESIGNED W. SENG/A. HERCE
DRAWN W. SENG
CHECKED S. PONG
REVIEWED T. TOLENTINO
RECOMMENDED C. MORGANSON
APPROVED R. EDWARDS
DATE 05/25/2012

REV. 0
SEALED BY
W. SENG



CITY AND COUNTY OF SAN FRANCISCO
MUNICIPAL TRANSPORTATION AGENCY

APPROVED
EDWARD D. REISKIN
DIRECTOR OF TRANSPORTATION

THIRD STREET LIGHT RAIL PROGRAM
PHASE 2 - CENTRAL SUBWAY
SURFACE, TRACK AND SYSTEMS

TRAFFIC SIGNALS
4TH AND KING STREETS
TRAFFIC SIGNAL PLAN

CONTRACT NO. 1256
SFMTA CONTROL NO. CL-23616
DRAWING NO. ET-112
SHEET NO. 822
REVISION 3

POLE AND EQUIPMENT SCHEDULE 7									
POLE NO.	TYPE OF POLE	LUMINAIRE (HPS)	VEHICLE SIGNAL			PEDESTRIAN SIGNAL			REMARKS
		VOLTAGE/WATTS	NO.	TYPE	MOUNTING (F/I)	NO.	TYPE	MOUNTING (F/I)	
1	(E) MUNI COMBO POLE WITH 39 1/2" MAST ARM		21 24 IC	3S12" 3S12" 1S16"x16"	SV-1-T MAS MAI	89	IS-C	SP-1-T	PPB CAMERA
2	(E) MISSION BAY POLE		85 LRV4D	3S12" 2S12"	SV-2-T	28	IS-C	SP-1-T	PPB 6 LRV4D - 2S12" LUNAR BAR 8 2
3	(E) TYPE 1-A (12')		LRV8C LRV8Y LRV4B LRV4E	4S12" 3S12" 2S12" 2S12"	SV-1 SV-1 TV-2-T	-	-	-	9 LRV4B - 2S12" LUNAR BAR LRV8E - 2S12" LUNAR BAR 6 8
4	(E) PPB POST		-	-	-	-	-	-	PPB
5	(E) PPB POST 3 2					-	-	-	2
6	(E) MISSION BAY POLE		41	PV3S12"	SV-1-T	29	IS-C	SP-1-T	PPB
7	(E) TYPE 1-A (10')		25 LRV1A	3S12" 2S12"	TV-2-T	48	IS-C	SP-1-T	PPB
8	(E) MUNI COMBO POLE WITH 55' MAST ARM		LRV4A 16 LRV2B LRV1B LRV6D C2 TC	2S12" 3S12" LA 2S12" 2S12" 2S12" 4S12" 1S16"x16"	MAS SV-1-T SV-3-T SV-1 MAI	40 427 TC 426	IS 16" x 16"	DET. 2	LRV4A - 2S12" LUNAR BAR 8 PPB CAMERA 1 RFI #96 2
9	(E) PPB POST		-	-	-	-	-	-	PPB 3
10	(E) MUNI COMBO POLE		C1 LRV6A LRV2Y 47	4S12" 2S12" 2S12" 4S12"FYRA	SV-1 SV-1-T SV-1 SV-1-T	430 428 429 TC	IS-C 16"x16"	DET. 2	6 10 2 11 12 DETAIL A
11	(E) MUNI COMBO POLE WITH 30" MAST ARM		14 61 64 TC	3S12" LA 3S12" 3S12" 1S 16"x16"	MAS SV-1-T MAS MAT	49	IS-C	SP-1-T	PPB CAMERA
12	(E) MUNI COMBO POLE		LRV8F 45	2S12" 4S12"FYRA	SV-2-T	68	IS-C		LRV8F - 2S12" LUNAR BAR 8 PPB 6 12 DETAIL A 2
13	(E) MISSION BAY POLE		81 LRV8B	PV3S12" 2S12"	SV-1-T SV-1	69	IS-C	SP-1-T	PPB 6 LRV8B - 2S12" LUNAR BAR 8 2
14	(E) MUNI COMBO POLE		65	3S12"	SV-1-T	88	IS-C	SP-1-T	PPB
15	(E) MUNI COMBO POLE WITH 55' MAST ARM		LRV4C 16 LRV6B LRV2X 84 TC LRV8A LRV3B	2S12" 3S12" LA 2S12" 2S12" 3S12" 1S 16"x16" 2S12" 2S12"	SV-1 SV-1-T SV-2-T MAS MAT MAT SV-1	828 829 TC	IS-C 16"x16"	DET. 1	LRV4C - 2S12" LUNAR BAR 8 6 PPB CAMERA 1 RFI #96 LRV3B - 2S12" LUNAR BAR 8 2
16	(E) MUNI COMBO POLE		LRV3A LRV2A LRV6C K11	2S12" 2S12" 2S12" 3S8" x	SV-1 SV-2-T SV-1	80 827 TC	IS-C 16"x16"	DET. 1	LRV3A - 2S12" LUNAR BAR 8 6 10

POLE AND EQUIPMENT SCHEDULE 7						
POLE NO.	TYPE OF POLE	LUMINAIRE (HPS)	VEHICLE SIGNAL			REMARKS
		VOLTAGE/WATTS	NO.	TYPE	MOUNTING (F/I)	
A	(E) TYPE 1-A (10')		A1	4S8"	TV-1	MUNI SIGNAL
B	(E) TYPE 1-A (10')		B1 B2 B3 B4	4S12" 4S12" 4S12" 4S12"	TV-4	MUNI SIGNALS FOR TRACK SWITCHOVER

NOTES:

- M.A. = MAST ARM
- REFER TO CHART ABOVE FOR SIGNALS MAINTAINED BY MUNI
- (E) EXISTING POLE TO REMAIN;
- F/I "TRAIN COMING" SIGN
- CONTRACTOR SHALL PULL (N) FIELD WIRING FROM THE (N) TRAFFIC SIGNAL HEAD TO THE CONTROLLER.
- BOLD TEXT INDICATE (N)
- 2S12" LUNAR BAR = RED HORIZONTAL BAR (TOP INDICATION) & WHITE VERTICAL BAR (BOTTOM INDICATION)
- SIGNALS LRV8C & LRV8X ARE TRACK SWITCH SIGNALS. REFER TO SG SERIES DRAWINGS FOR FURTHER DETAILS.
- LRV2X, LRV6C, LRV6D, C1, & C2 WERE INSTALLED BY CITY FORCES AFTER CONTRACT WAS AWARDED
- 45 DEGREE ANGLE VISORS ON SIGNAL 47 INSTALLED BY CITY FORCES
- GRA FOR SIGNALS 45/47 ARE DEACTIVATED AND COVERED BY CITY FORCES. TO BE RESERVED FOR FUTURE ACTIVATION.

RYG
FY
DETAIL A

FOR ORIGINAL SIGNATURES, SEE CL-23617 REV 0

09/01/2023	SRC 2023-226 MODIFIED VEH 45 & 47 TO 4S12" FYRA	3	MT	AL	AL				
04/01/2020	ISSUED FOR PCC NO. 694	2							
08/28/2014	ISSUED FOR PCC NO. 14	1							
05/25/2012	ISSUED FOR BID	0							
DATE	DESCRIPTION	REV. NO.	BY	CHECKED	APPROVED				

SFMTA

DESIGNED W. SENG
DRAWN W. SENG
CHECKED S. PONG
REVIEWED T. TOLENTINO
RECOMMENDED C. MORGANSON
APPROVED R. EDWARDS
DATE 05/25/2012

REV. 0
SEALED BY
W. SENG



CITY AND COUNTY OF SAN FRANCISCO
MUNICIPAL TRANSPORTATION AGENCY

APPROVED

EDWARD D. REISKIN

DIRECTOR OF TRANSPORTATION

THIRD STREET LIGHT RAIL PROGRAM
PHASE 2 - CENTRAL SUBWAY
SURFACE, TRACK AND SYSTEMS

TRAFFIC SIGNALS
4TH AND KING STREETS
POLE SCHEDULE

CONTRACT NO. 1256	REVISION 3
SFMTA CONTROL NO. CL-23617	
DRAWING NO. ET-113	3
SHEET NO. 823	

CONDUIT AND WIRING SCHEDULE		1	2	3	1488	
-----------------------------	--	---	---	---	---	---	---	---	---	---	----	----	-----	-----	------	------	--