


LINCOLN & 5TH AVE.

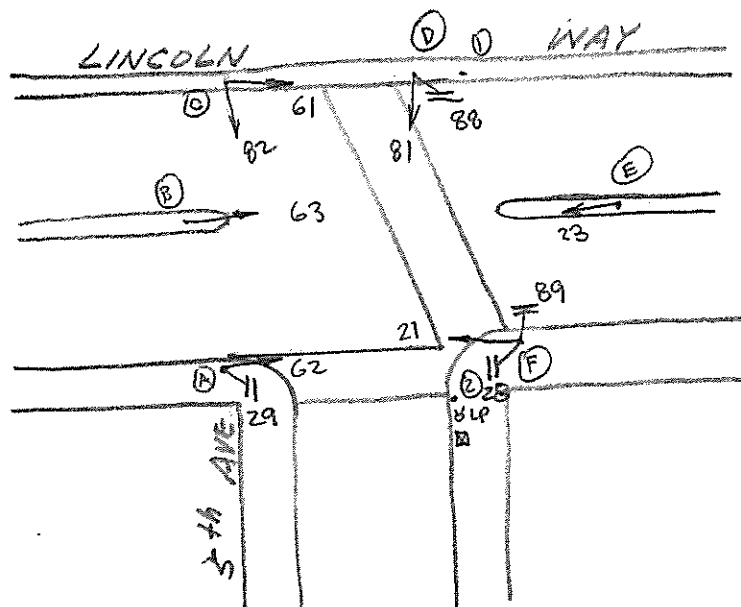

12-12-2016

POLE	FUNC.	MAT'L	SIGNAL NO.	MAKE	NO. OF SECT.	SIZE	VISOR	B.P. OR LOUVERS	MOUNT	PED SIGNAL NO.	LEGEND	MESSAGE	MAKE	MOUNT
A	S	C	62	EC	3	8"	FC 8"	No	T	88	K-COUNT	W/DR	ED	S
B	L	C	63	EC	3	12" R 8" G+Y	FC 12" FC 8"	No	S	89	K-COUNT	W/DR	ED	S
C	S	C	82	EC	3	8"	FC 8"	No	T	28	K-COUNT	W/DR		S
D	S	C	61	EC	3	12" R 8" G+Y	FC 12" FC 8"	No	T	29	K-COUNT	W/DR		S
E	L	C	81	EC	3	8"	FC 8"	No	T					
F	S	C	23	EC	3	12"	T 12"	No	S					
			21	EC	3	8"	FC 8"	No	T					
1	U	W												
2	U	W												

CONTROLLER CABINET SIZE : ORDINARY BASE CABINET : YES

COMMENTS : ADDED φ2 PLS PER SPC 2016-304

SIGNAL 23 - 3512" PER FIELD

-J. HORNESTEL